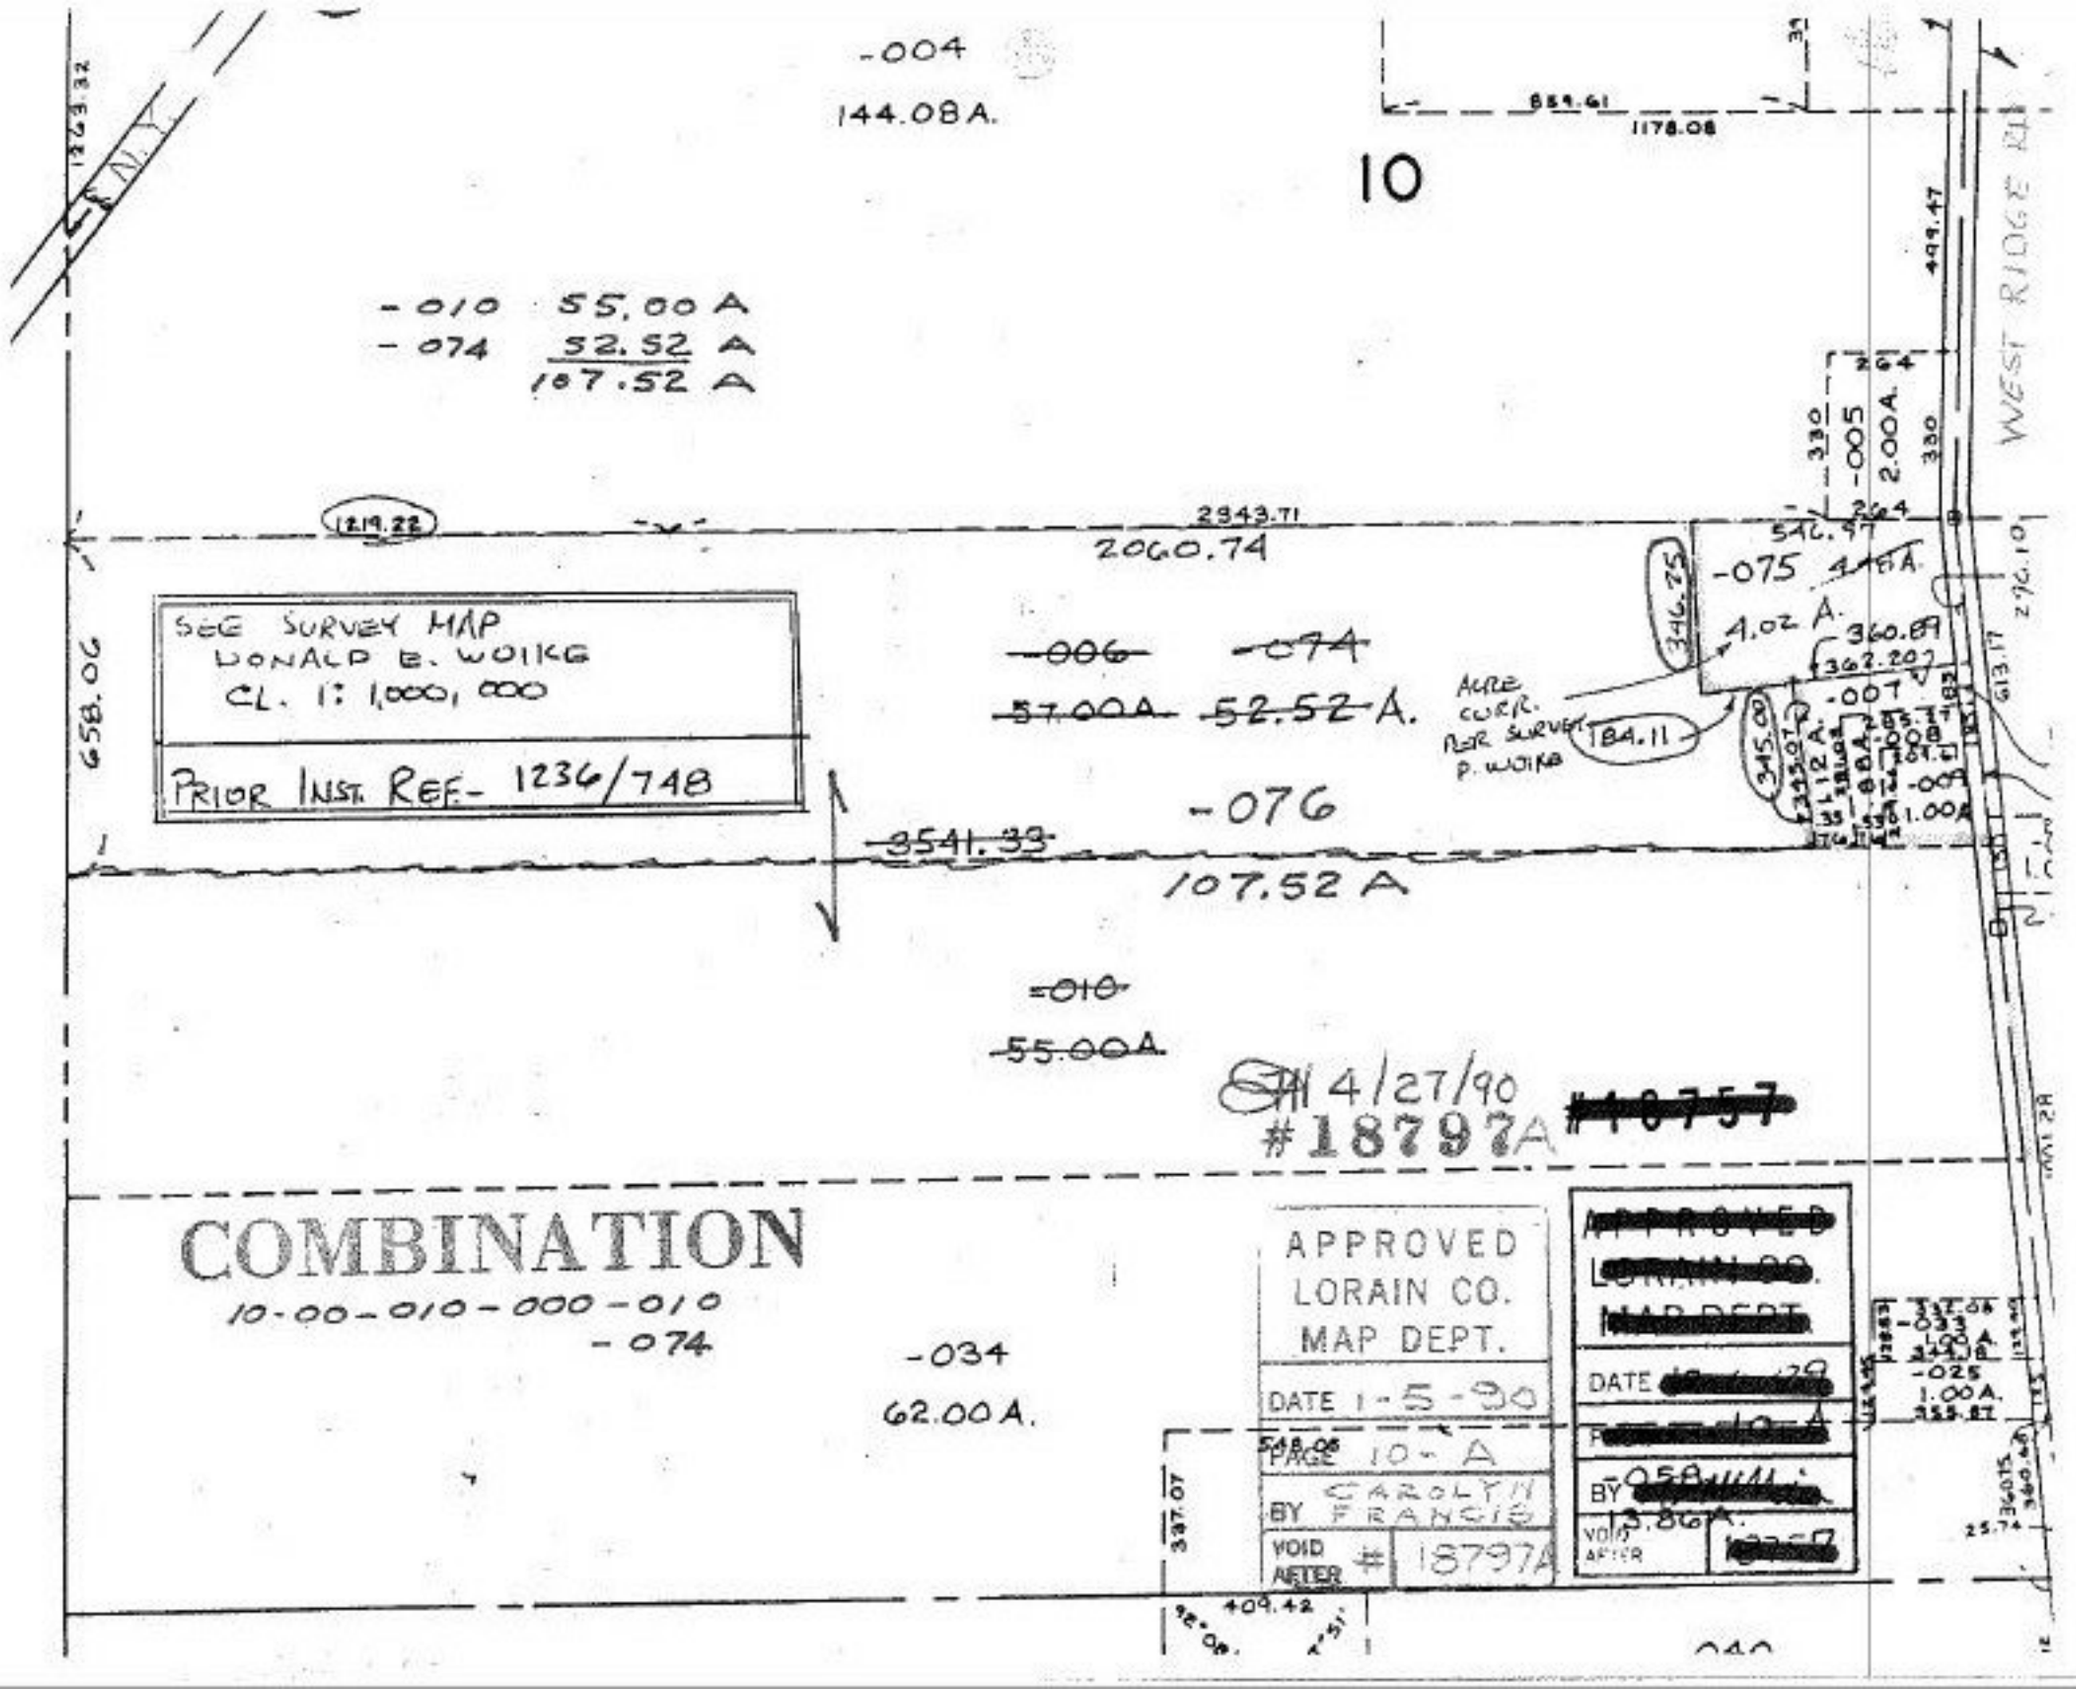

-004
144.08A.
10
-010 55.00 A
-074 52.52 A
107.52 A
1219.22
2343.71
2060.74
SEE SURVEY MAP
DONALD E. WOIKE
CL. 1: 1,000,000
PRIOR INST. REF- 1236/748
658.06
~~-006~~ ~~-074~~
~~57.00A~~ ~~52.52~~ A.
-076
~~3541.33~~
107.52 A
~~-010~~
~~55.00A~~
4/27/90
#18797A
COMBINATION
10-00-010-000-010
-074
-034
62.00A.
APPROVED
LORAIN CO.
MAP DEPT.
DATE 1-5-90
PAGE 10-A
BY CAROLYN FRANCIS
VOID AFTER # 18797A
DATE
BY
VOID AFTER
WEST RIDGE RD
-005
2.00A.
-075
4.02 A.
-007
-009
1.00A
-025
1.00A.