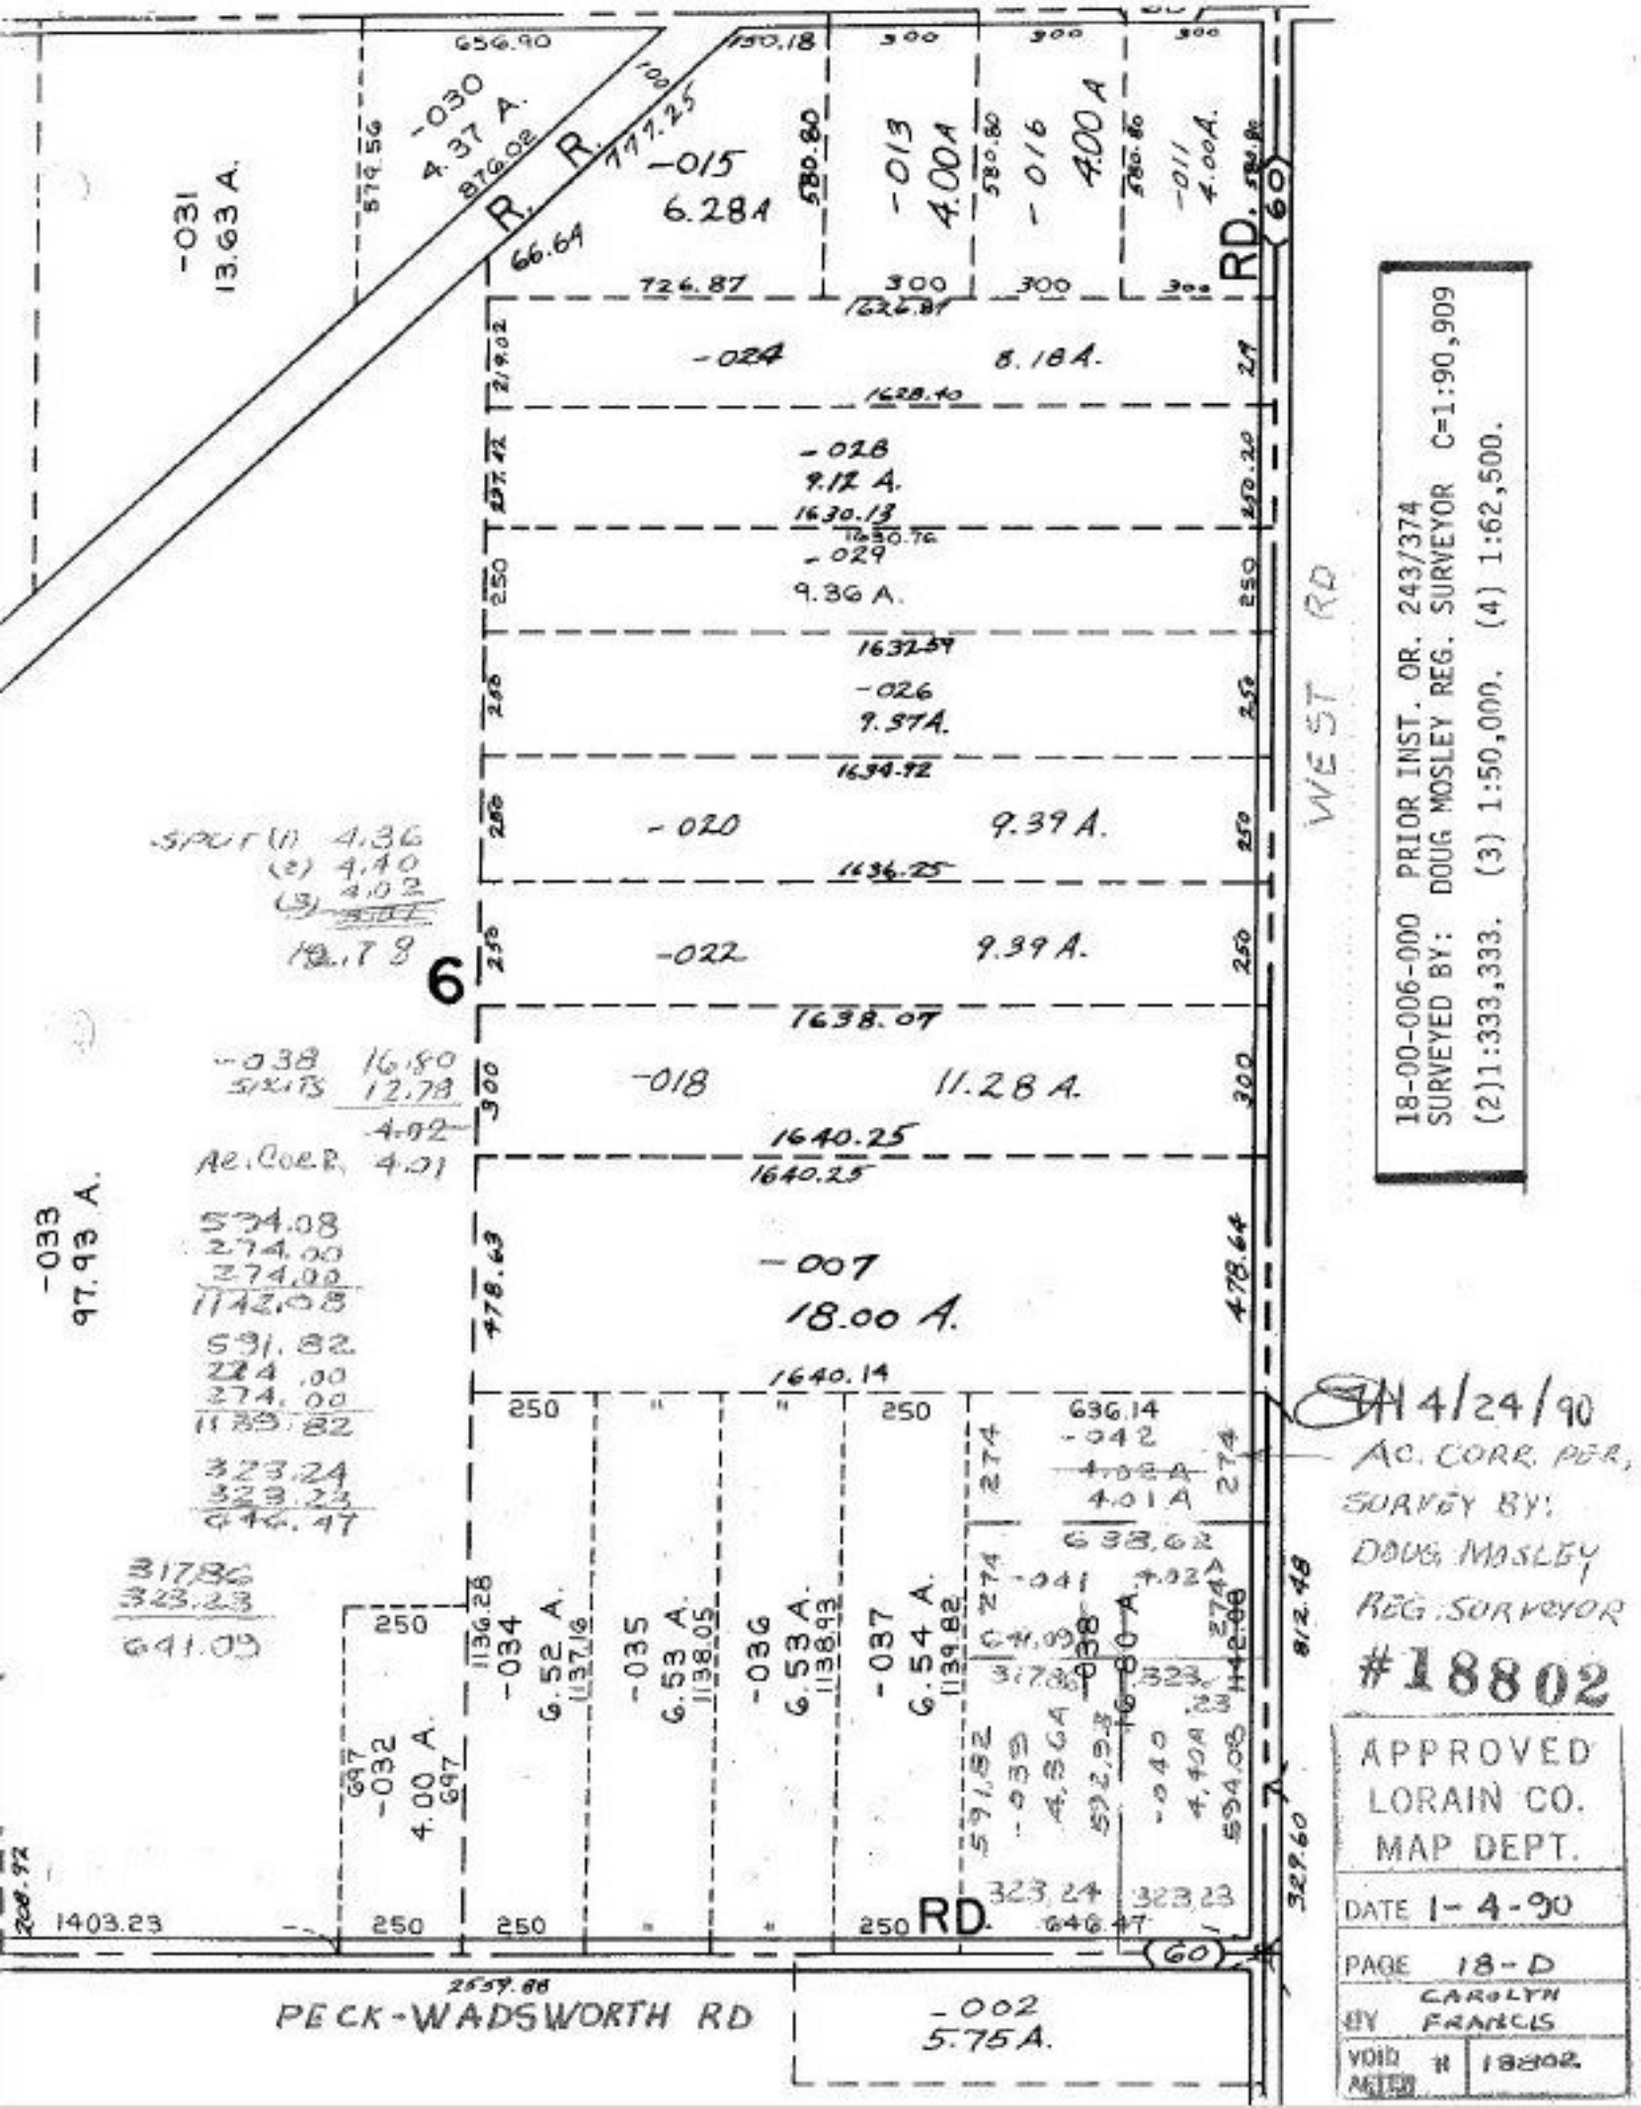

18-00-006-000 PRIOR INST. OR. 243/374
SURVEYED BY: DOUG MOSLEY REG. SURVEYOR C=1:90,909
(2)1:333,333. (3) 1:50,000. (4) 1:62,500.
-031 13.63 A.
-030 4.37 A.
-015 6.28A
-013 4.00A
-016 4.00 A
-011 4.00A.
R. R.
RD.
WEST RD
-024 8.18A.
-028 9.12 A.
-029 9.36 A.
-026 9.37A.
-020 9.39 A.
-022 9.39 A.
-018 11.28 A.
-007 18.00 A.
-033 97.93 A.
-034 6.52 A.
-035 6.53 A.
-036 6.53 A.
-037 6.54 A.
-032 4.00 A.
-002 5.75A.
PECK-WADSWORTH RD
6
SPLIT (1) 4.36
(2) 4.40
(3) 4.02
12.78
-038 16.80
SPLITS 12.78
4.02
AC. CORR. 4.01
594.08
274.00
274.00
1142.08
591.82
274.00
274.00
1139.82
323.24
323.23
646.47
317.86
323.23
641.09
4/24/90
AC. CORR. PER, SURVEY BY: DOUG MOSLEY REG. SURVEYOR
#18802
APPROVED LORAIN CO. MAP DEPT.
DATE 1-4-90
PAGE 18-D
BY CAROLYN FRANCIS
VOID AFTER # 18802