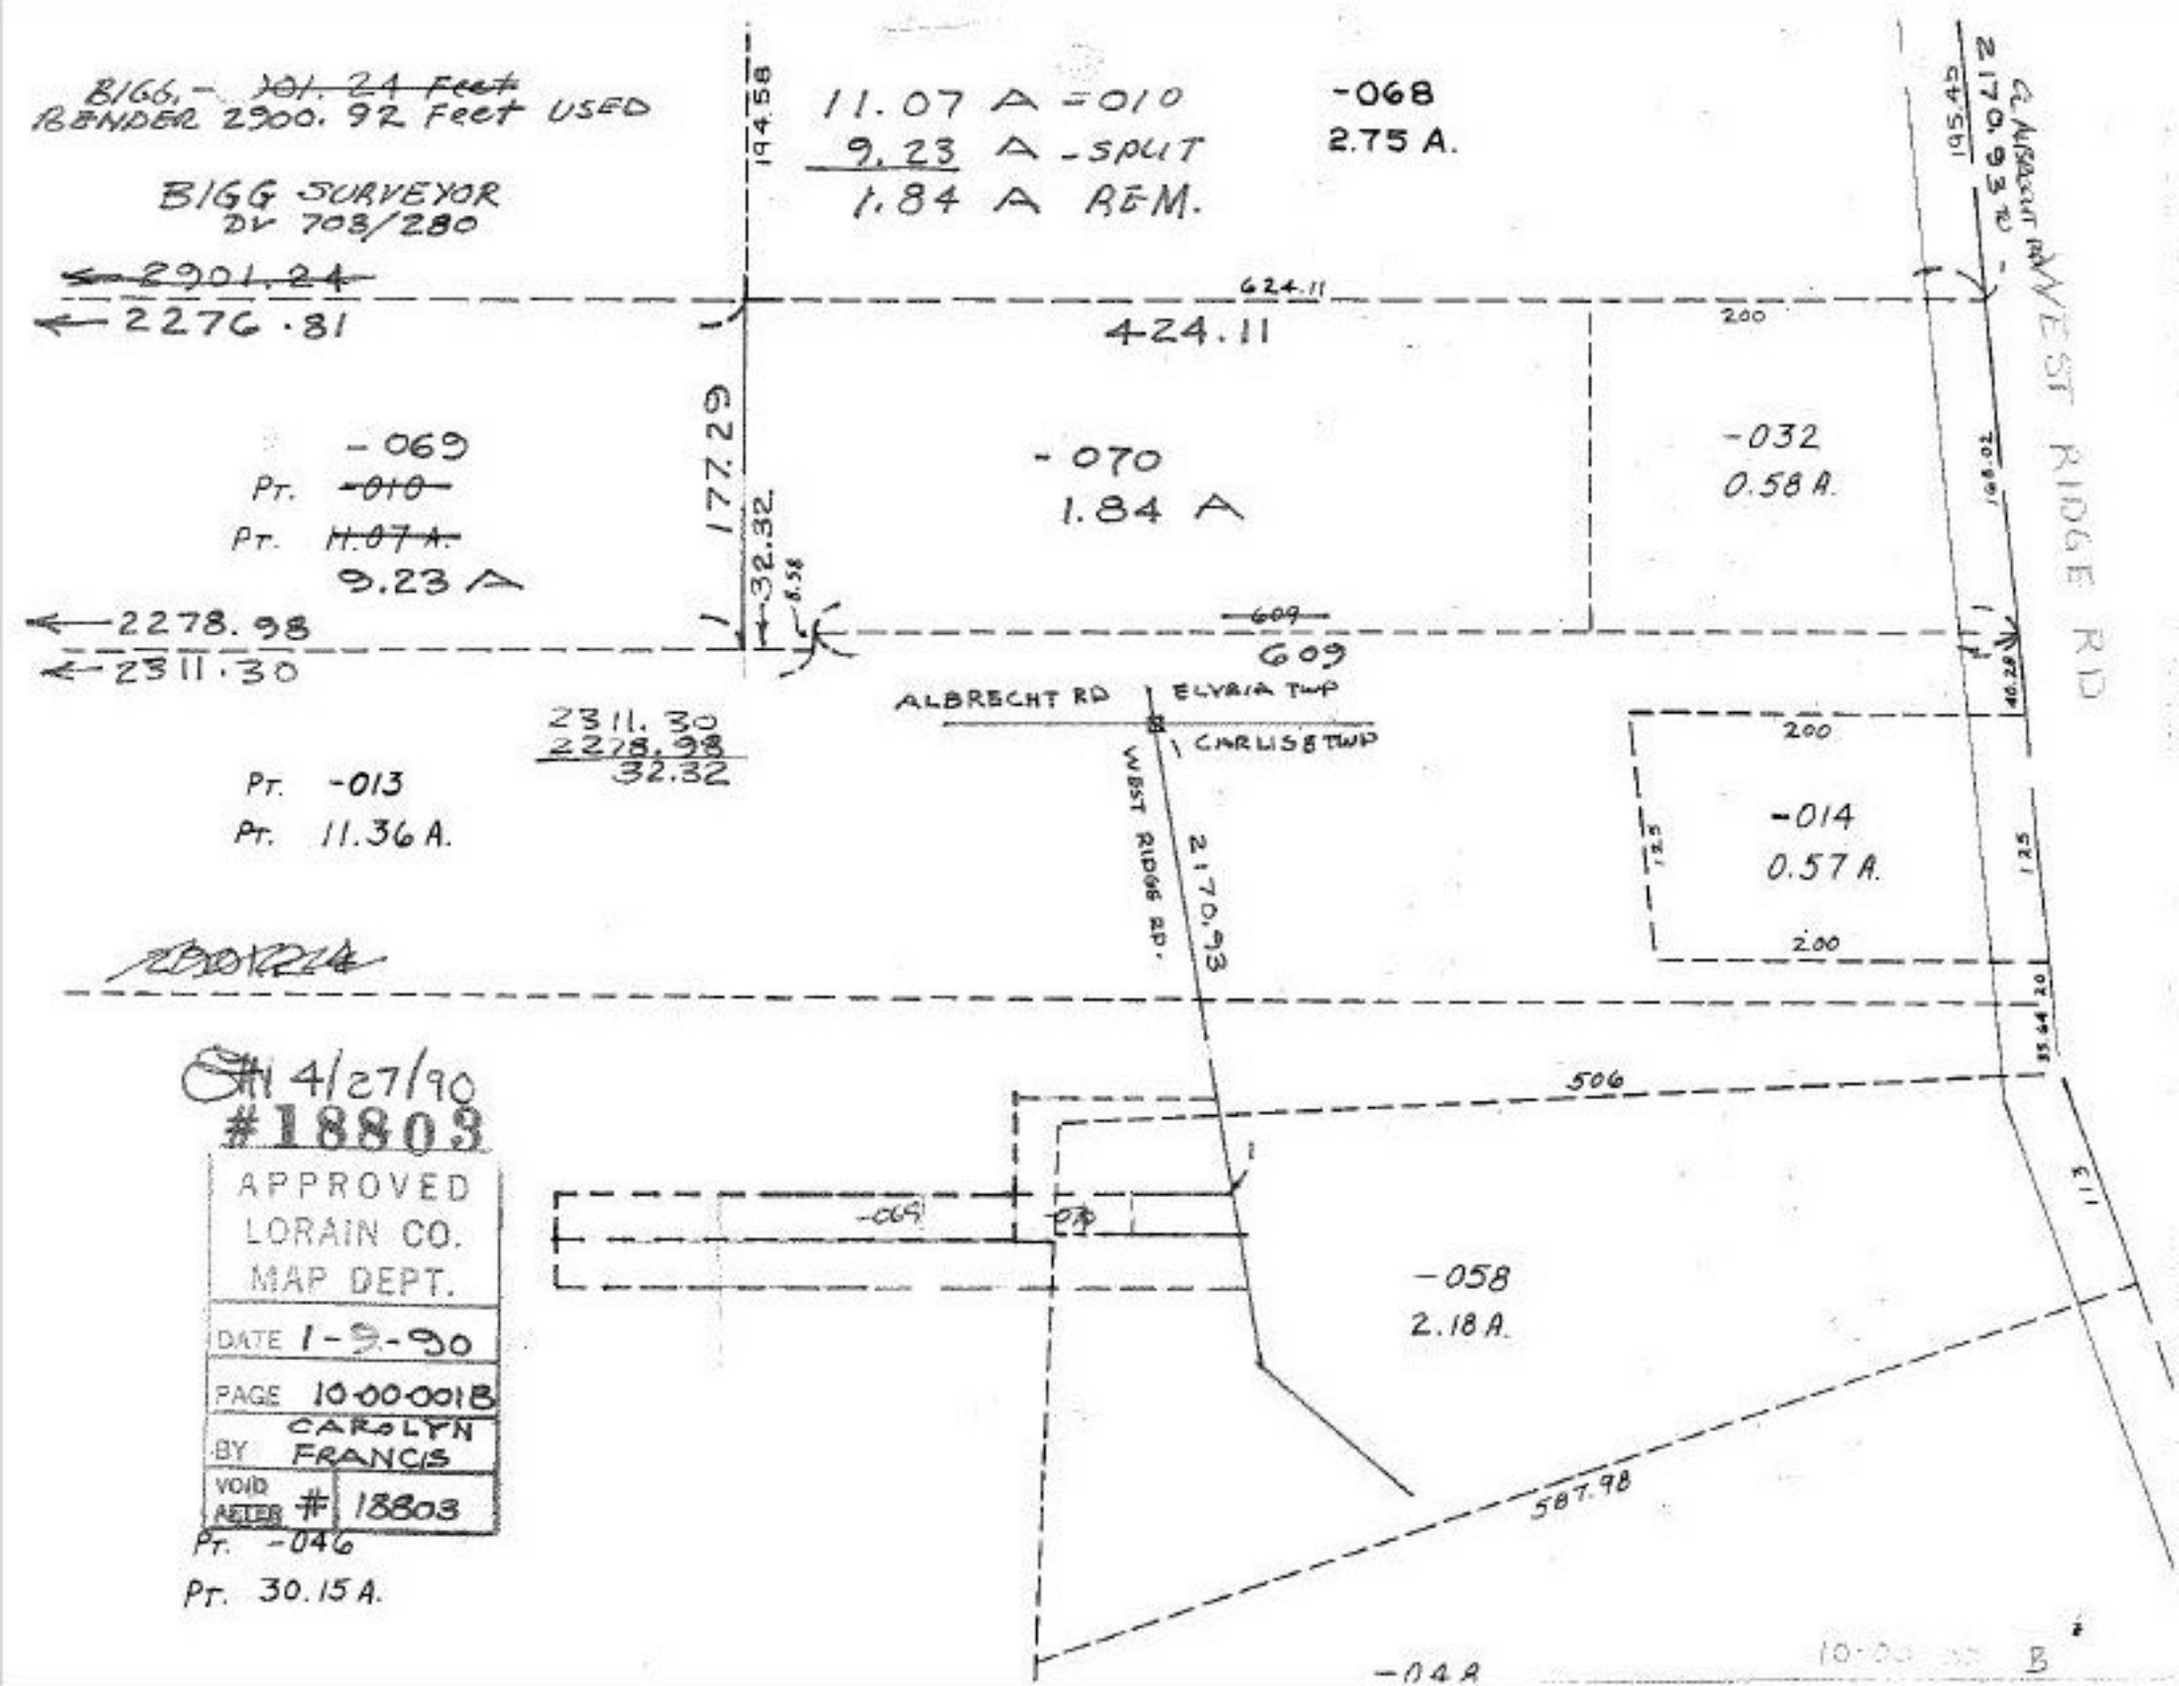
BIGG. - ~~101.24 Feet~~
BENDER 2900.92 Feet USED
BIGG SURVEYOR
DV 703/280
~~2901.24~~
2276.81
11.07 A = 010
9.23 A - SPLIT
1.84 A REM.
-068
2.75 A.
194.58
624.11
424.11
200
-069
Pt. ~~-010~~
Pt. ~~11.07 A.~~
9.23 A
177.29
32.32
-070
1.84 A
-032
0.58 A.
2278.98
2311.30
~~609~~
609
ALBRECHT RD
ELYRIA TWP
CARLISE TWP
2311.30
2278.98
32.32
Pt. -013
Pt. 11.36 A.
WEST RIDGE RD.
2170.93
-014
0.57 A.
125
200
506
-069
-058
2.18 A.
587.98
-04 A
Pt. -046
Pt. 30.15 A.
WEST RIDGE RD
2170.93
195.45
168.02
40.28
35.64
113
4/27/90
#18803
APPROVED
LORAIN CO.
MAP DEPT.
DATE 1-9-90
PAGE 10-00-001B
BY CAROLYN FRANCIS
VOID AFTER # 18803