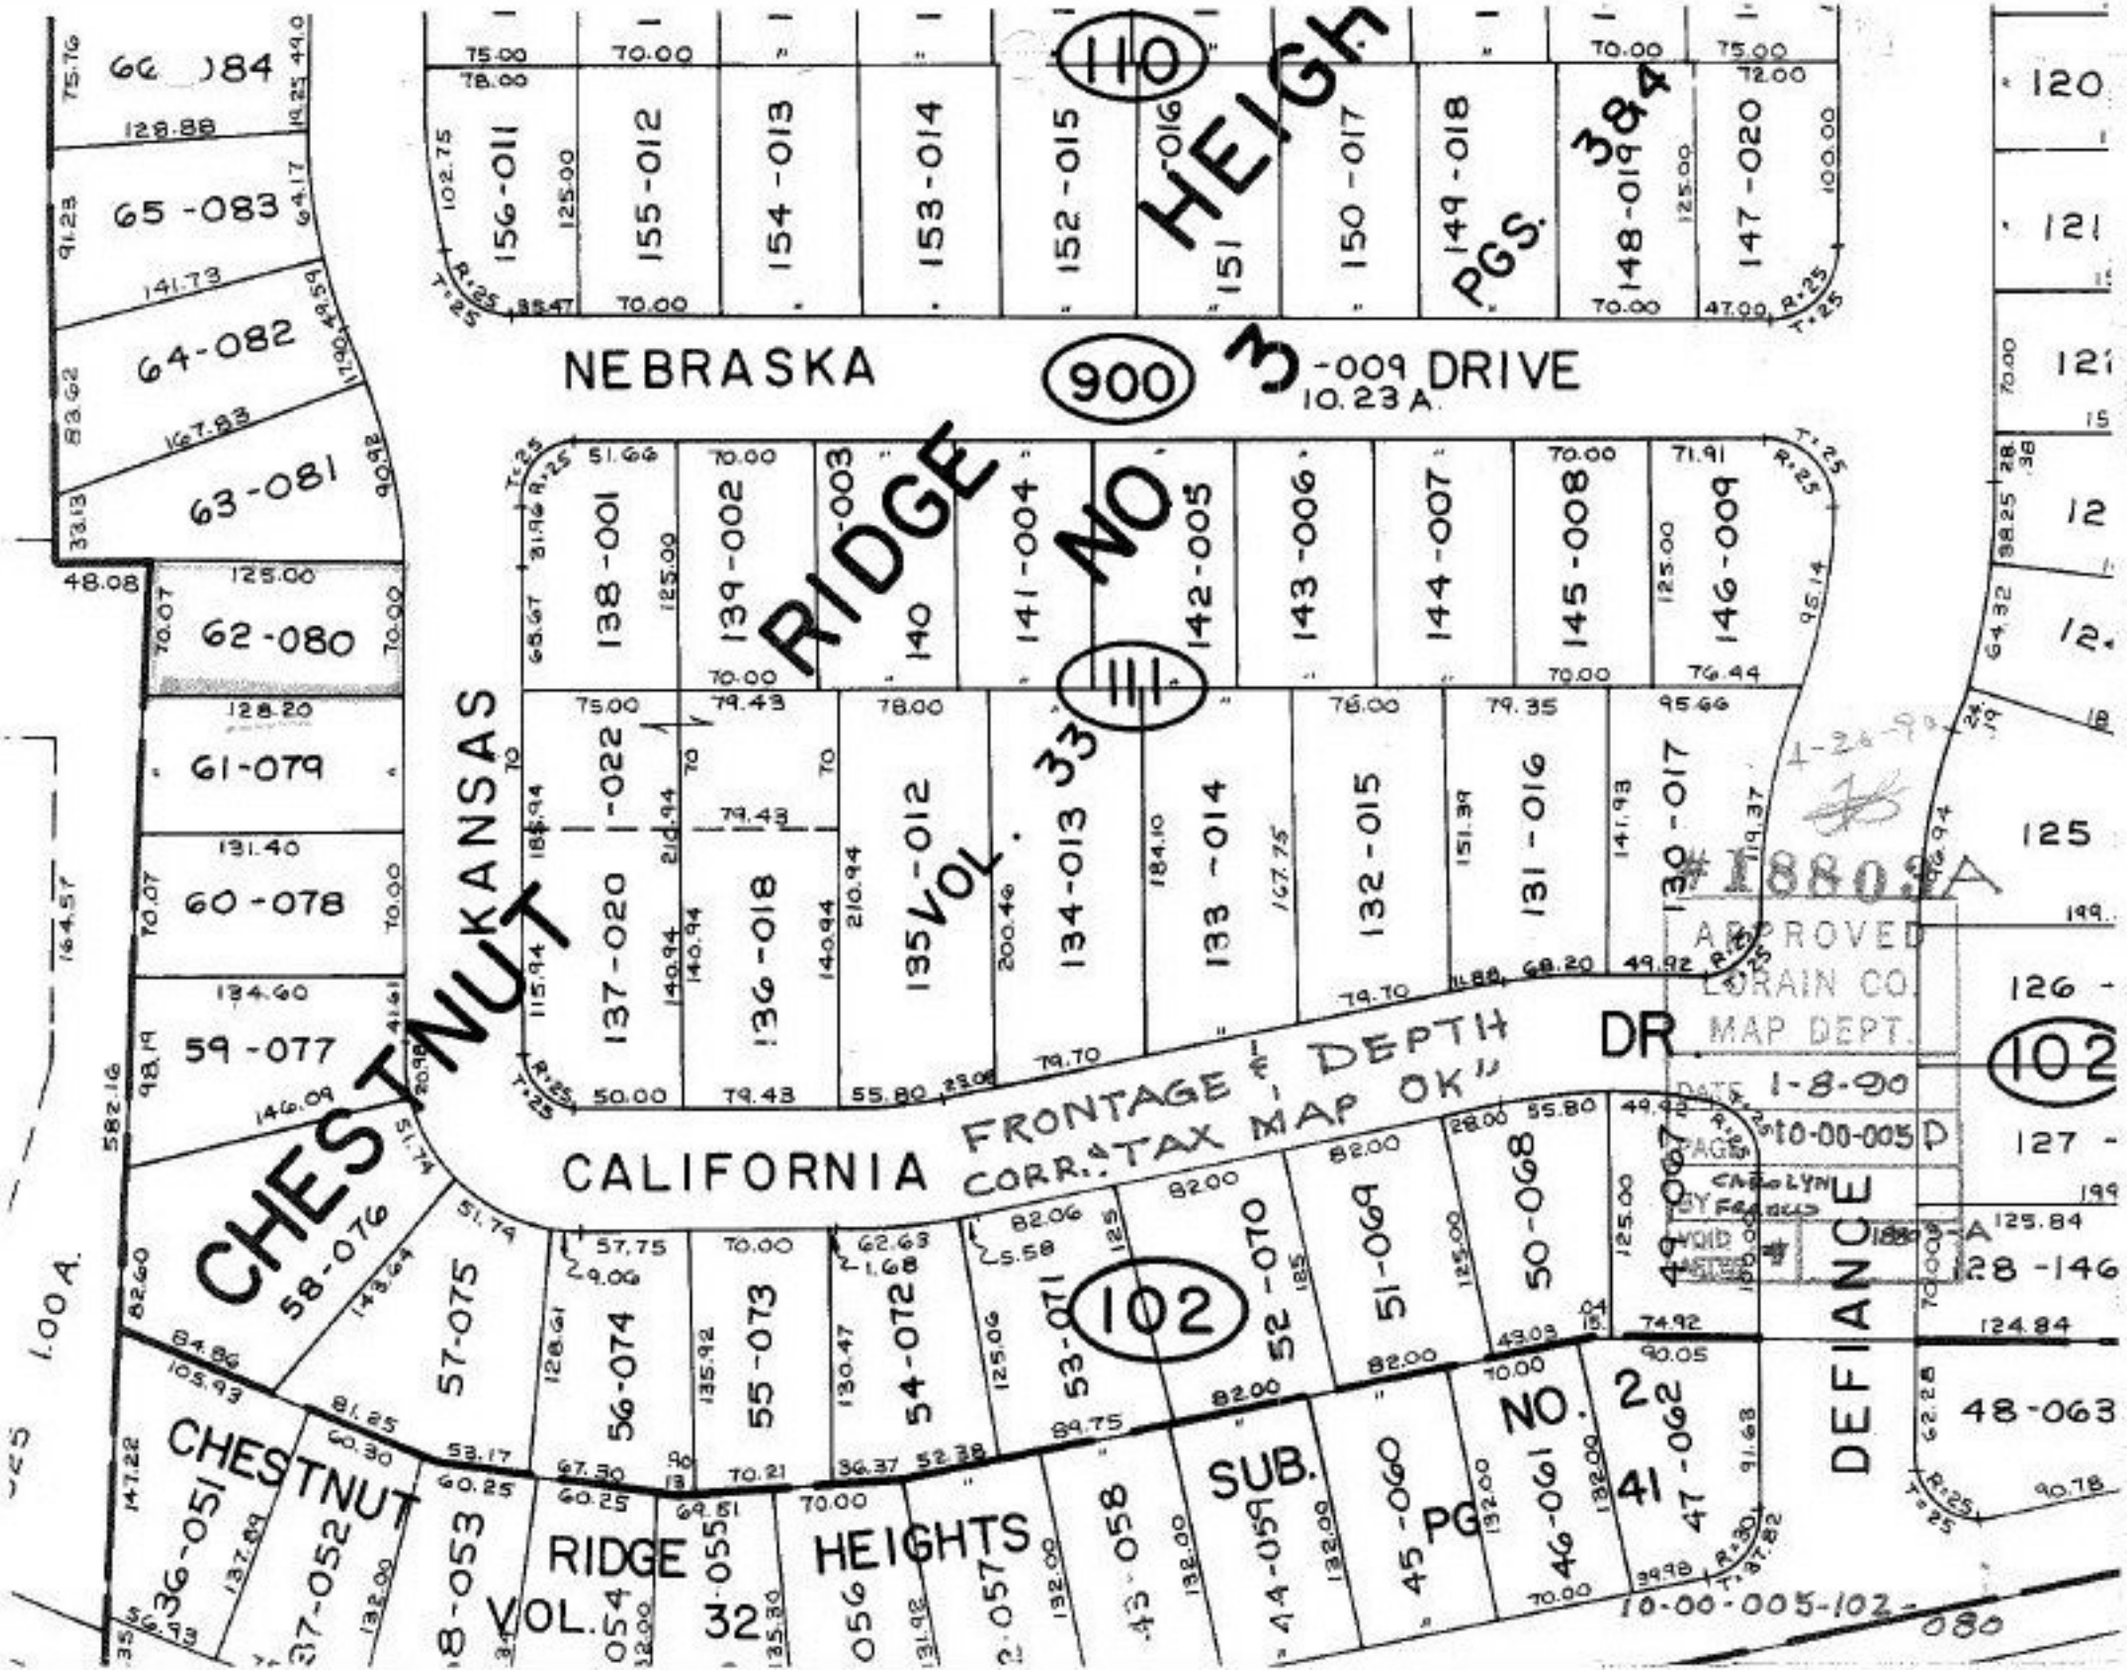
NEBRASKA
900
DRIVE
CALIFORNIA
DR
CHESTNUT
KANSAS
CHESTNUT
RIDGE
HEIGHTS
VOL. 32
RIDGE
NO. 3
VOL. 33
DEFIANCE
NO. 2
SUB.
PG. 41
PGS. 38
FRONTAGE - DEPTH
CORR. & TAX MAP OK
APPROVED
LORAIN CO.
MAP DEPT.
DATE 1-8-90
10-00-005 D
10-00-005-102-080
#1880-A