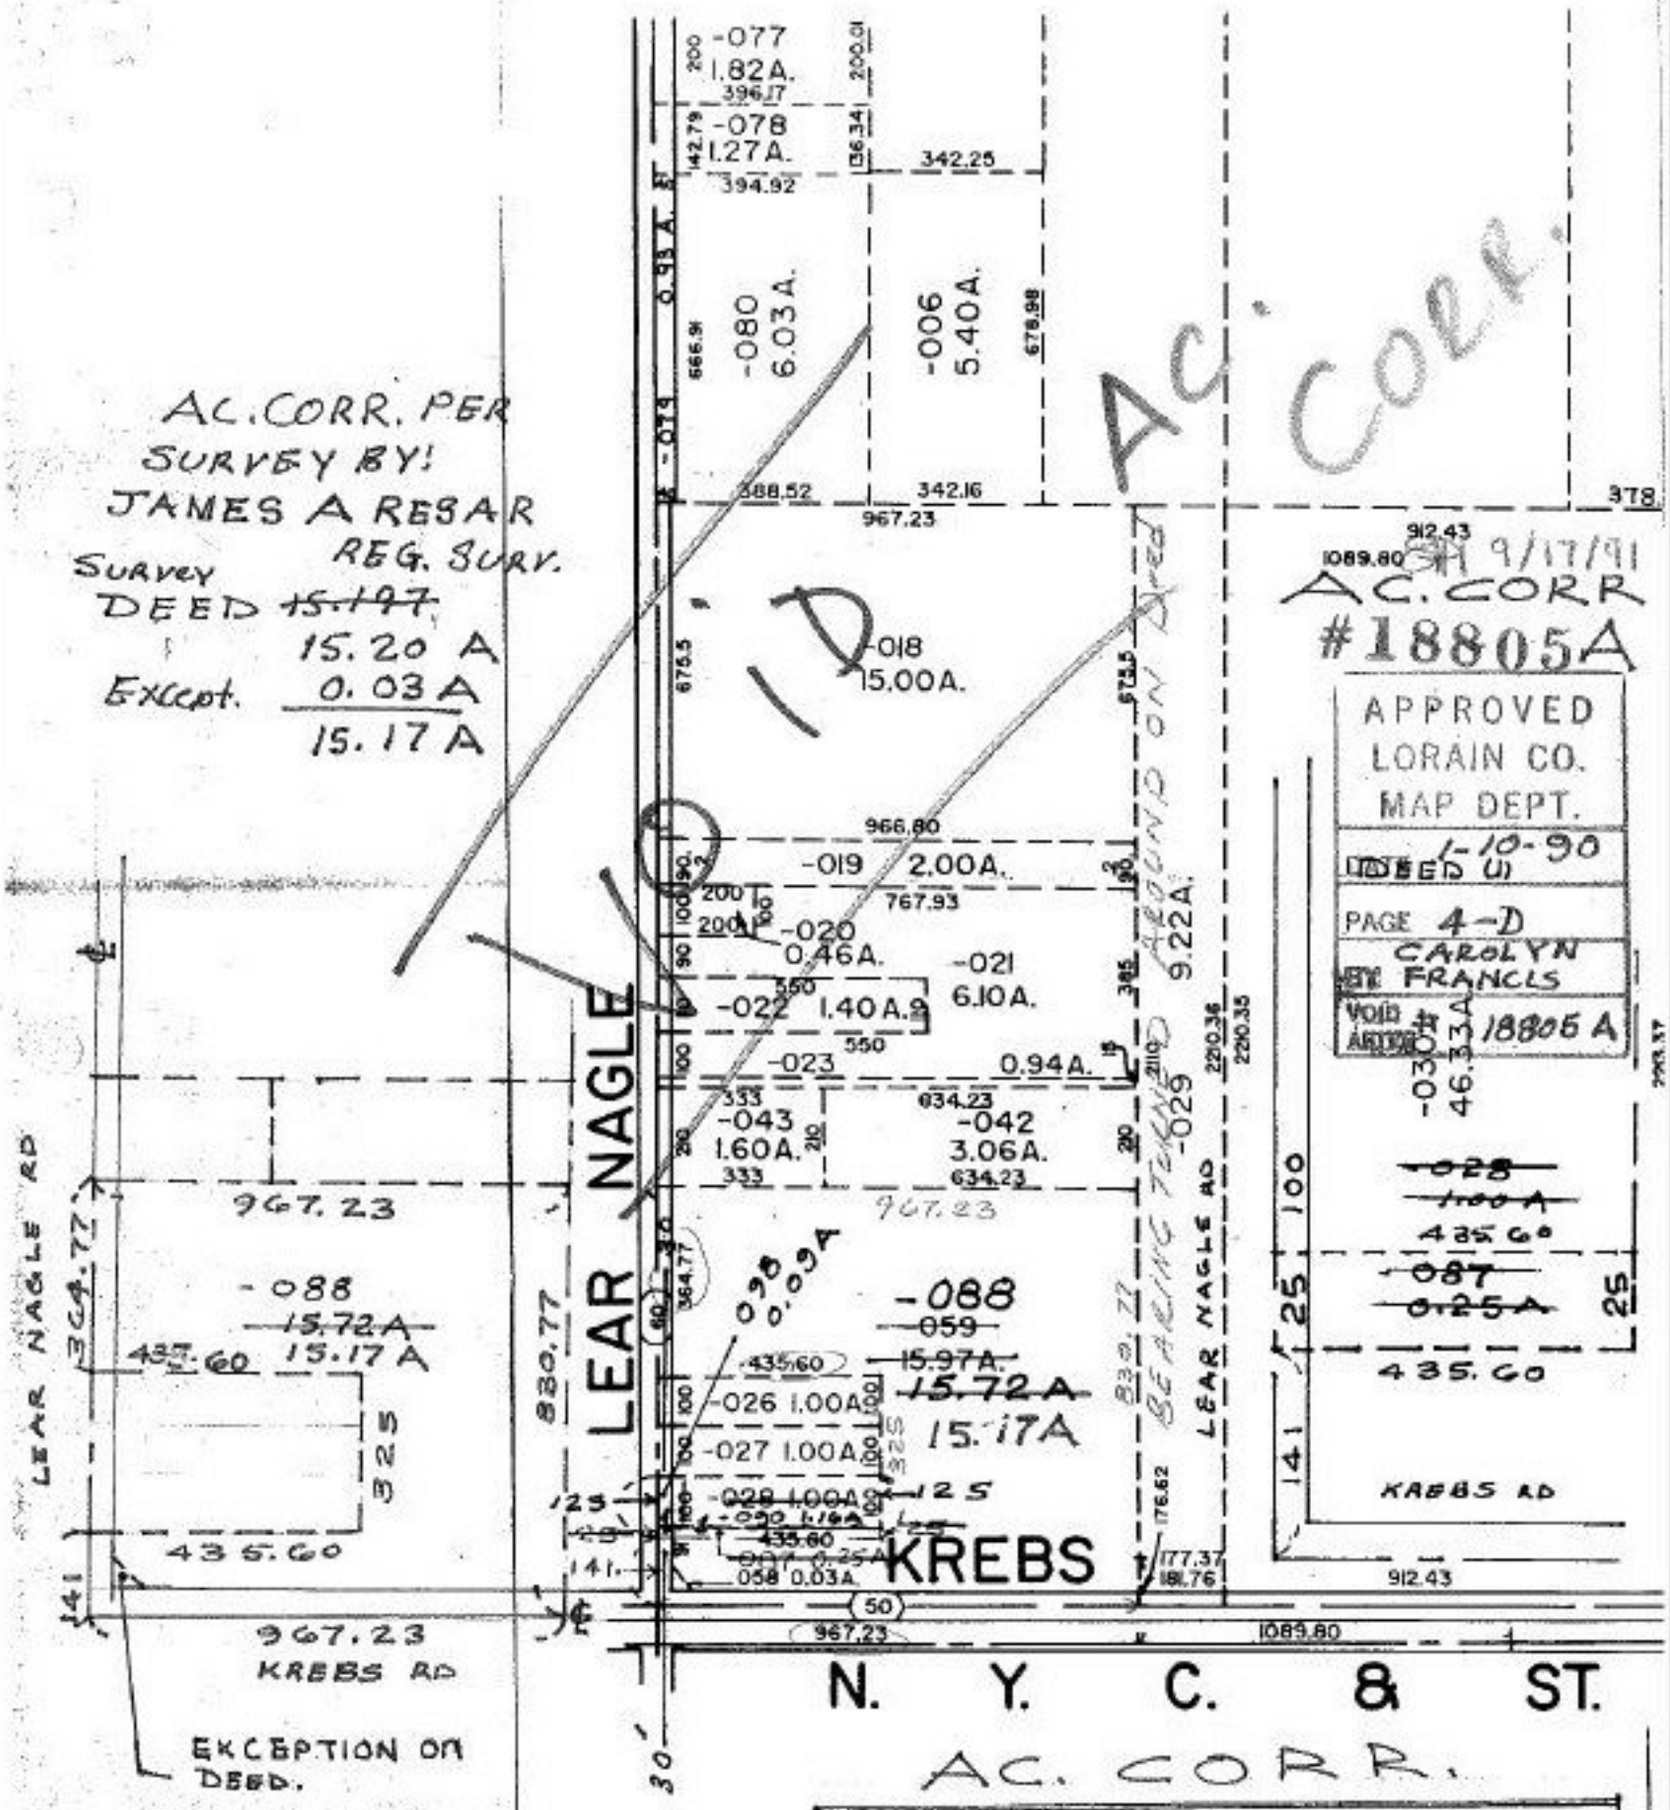
AC. CORR. PER SURVEY BY: JAMES A RESAR REG. SURV.
SURVEY DEED ~~15.197~~ 15.20 A
Except. 0.03 A
15.17 A
AC. CORR.
9/17/91
AC. CORR
#18805A
APPROVED LORAIN CO. MAP DEPT.
1-10-90
DEED (1)
PAGE 4-D
CAROLYN FRANCIS
VOID AFTER 18805 A
NO ID
LEAR NAGLE
KREBS
N. Y. C. & ST.
LEAR NAGLE RD
KREBS RD
BEARING TURNED AROUND ON DEED
-077 1.82A.
-078 1.27A.
-080 6.03A.
-006 5.40A.
-018 15.00A.
-019 2.00A.
-020 0.46A.
-021 6.10A.
-022 1.40A.
-023 0.94A.
-043 1.60A.
-042 3.06A.
-029 9.22A.
-030 46.33A
-028 1.00A
-087 0.25A
-088 15.72A 15.17A
-059 15.97A.
-026 1.00A
-027 1.00A
-028 1.00A
-090 1.16A
-087 0.25A
-058 0.03A
967.23
1089.80
912.43
435.60
325
141
125
50
30
EXCEPTION ON DEED.
PARCEL DEEDED TO CITY OF AVON LAKE VOL. 1377/785
04-00-029-000- PRIOR INST. (1) 712/324
SURVEYED BY: JAMES A. RESAR REG. SURVEYOR
C=1: INF (1 & 2) DV. 722/569
04-00-029-000-088
C=1: INF