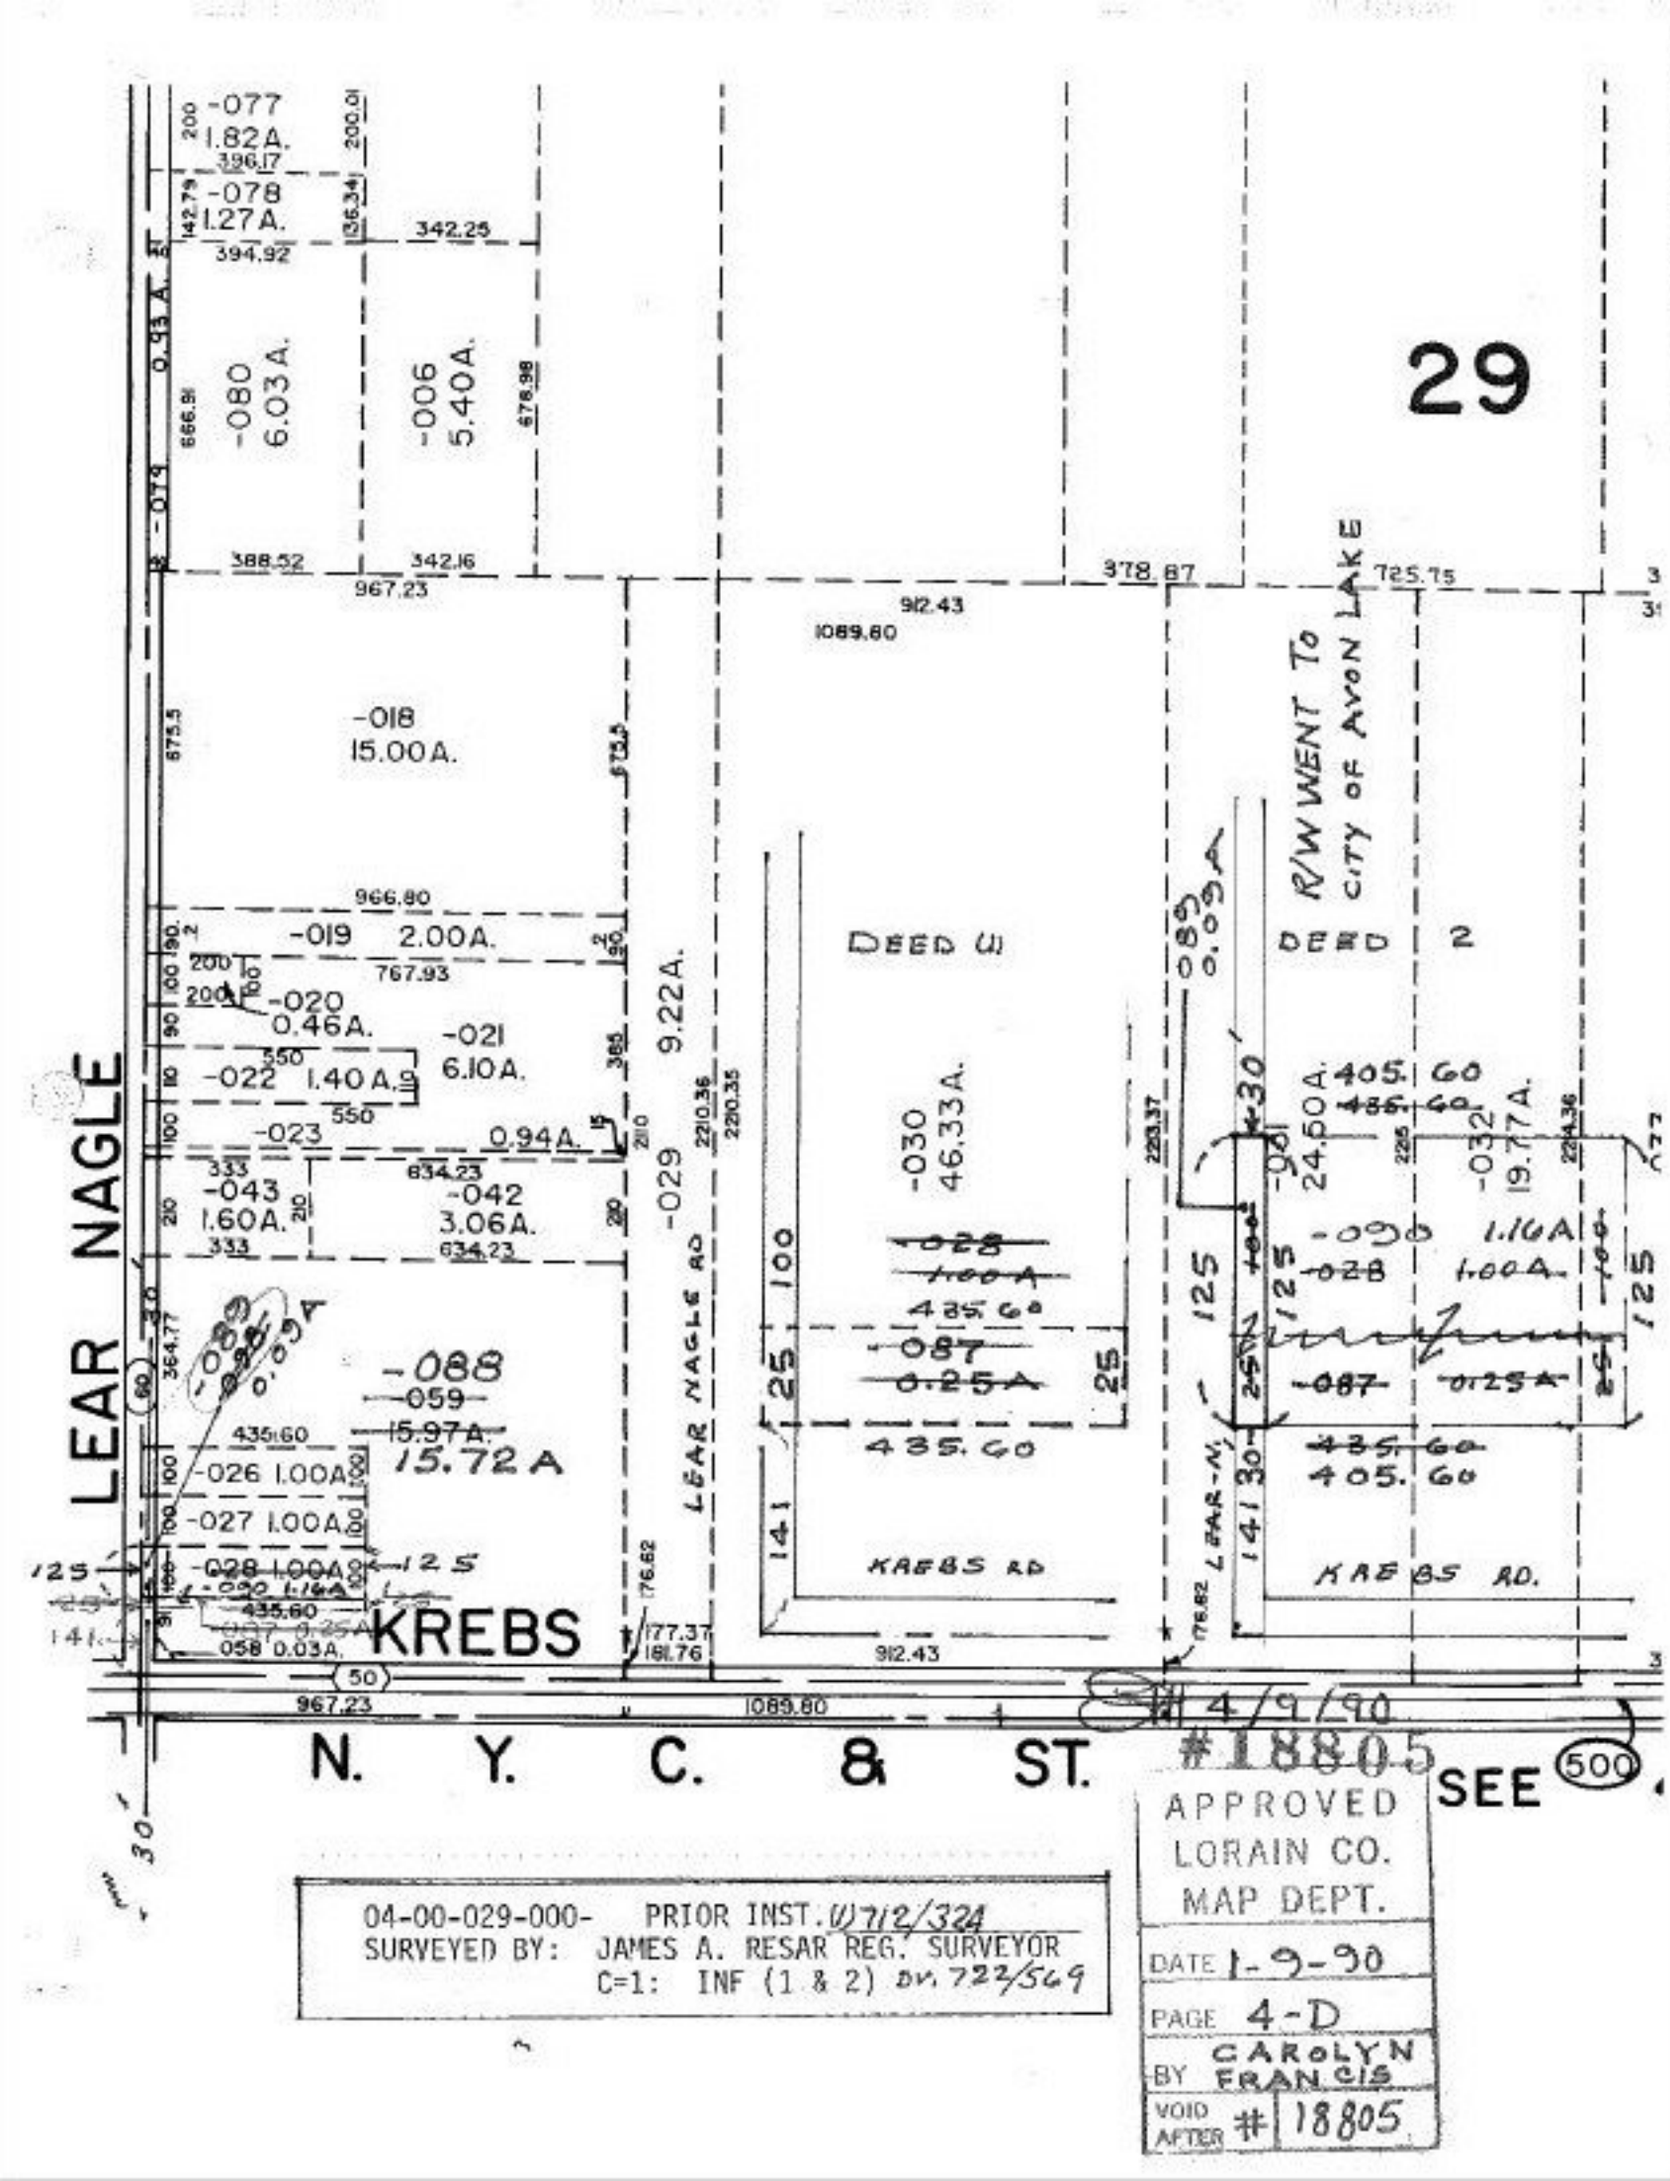

04-00-029-000- PRIOR INST. W712/324
SURVEYED BY: JAMES A. RESAR REG. SURVEYOR
C=1: INF (1 & 2) DV. 722/569