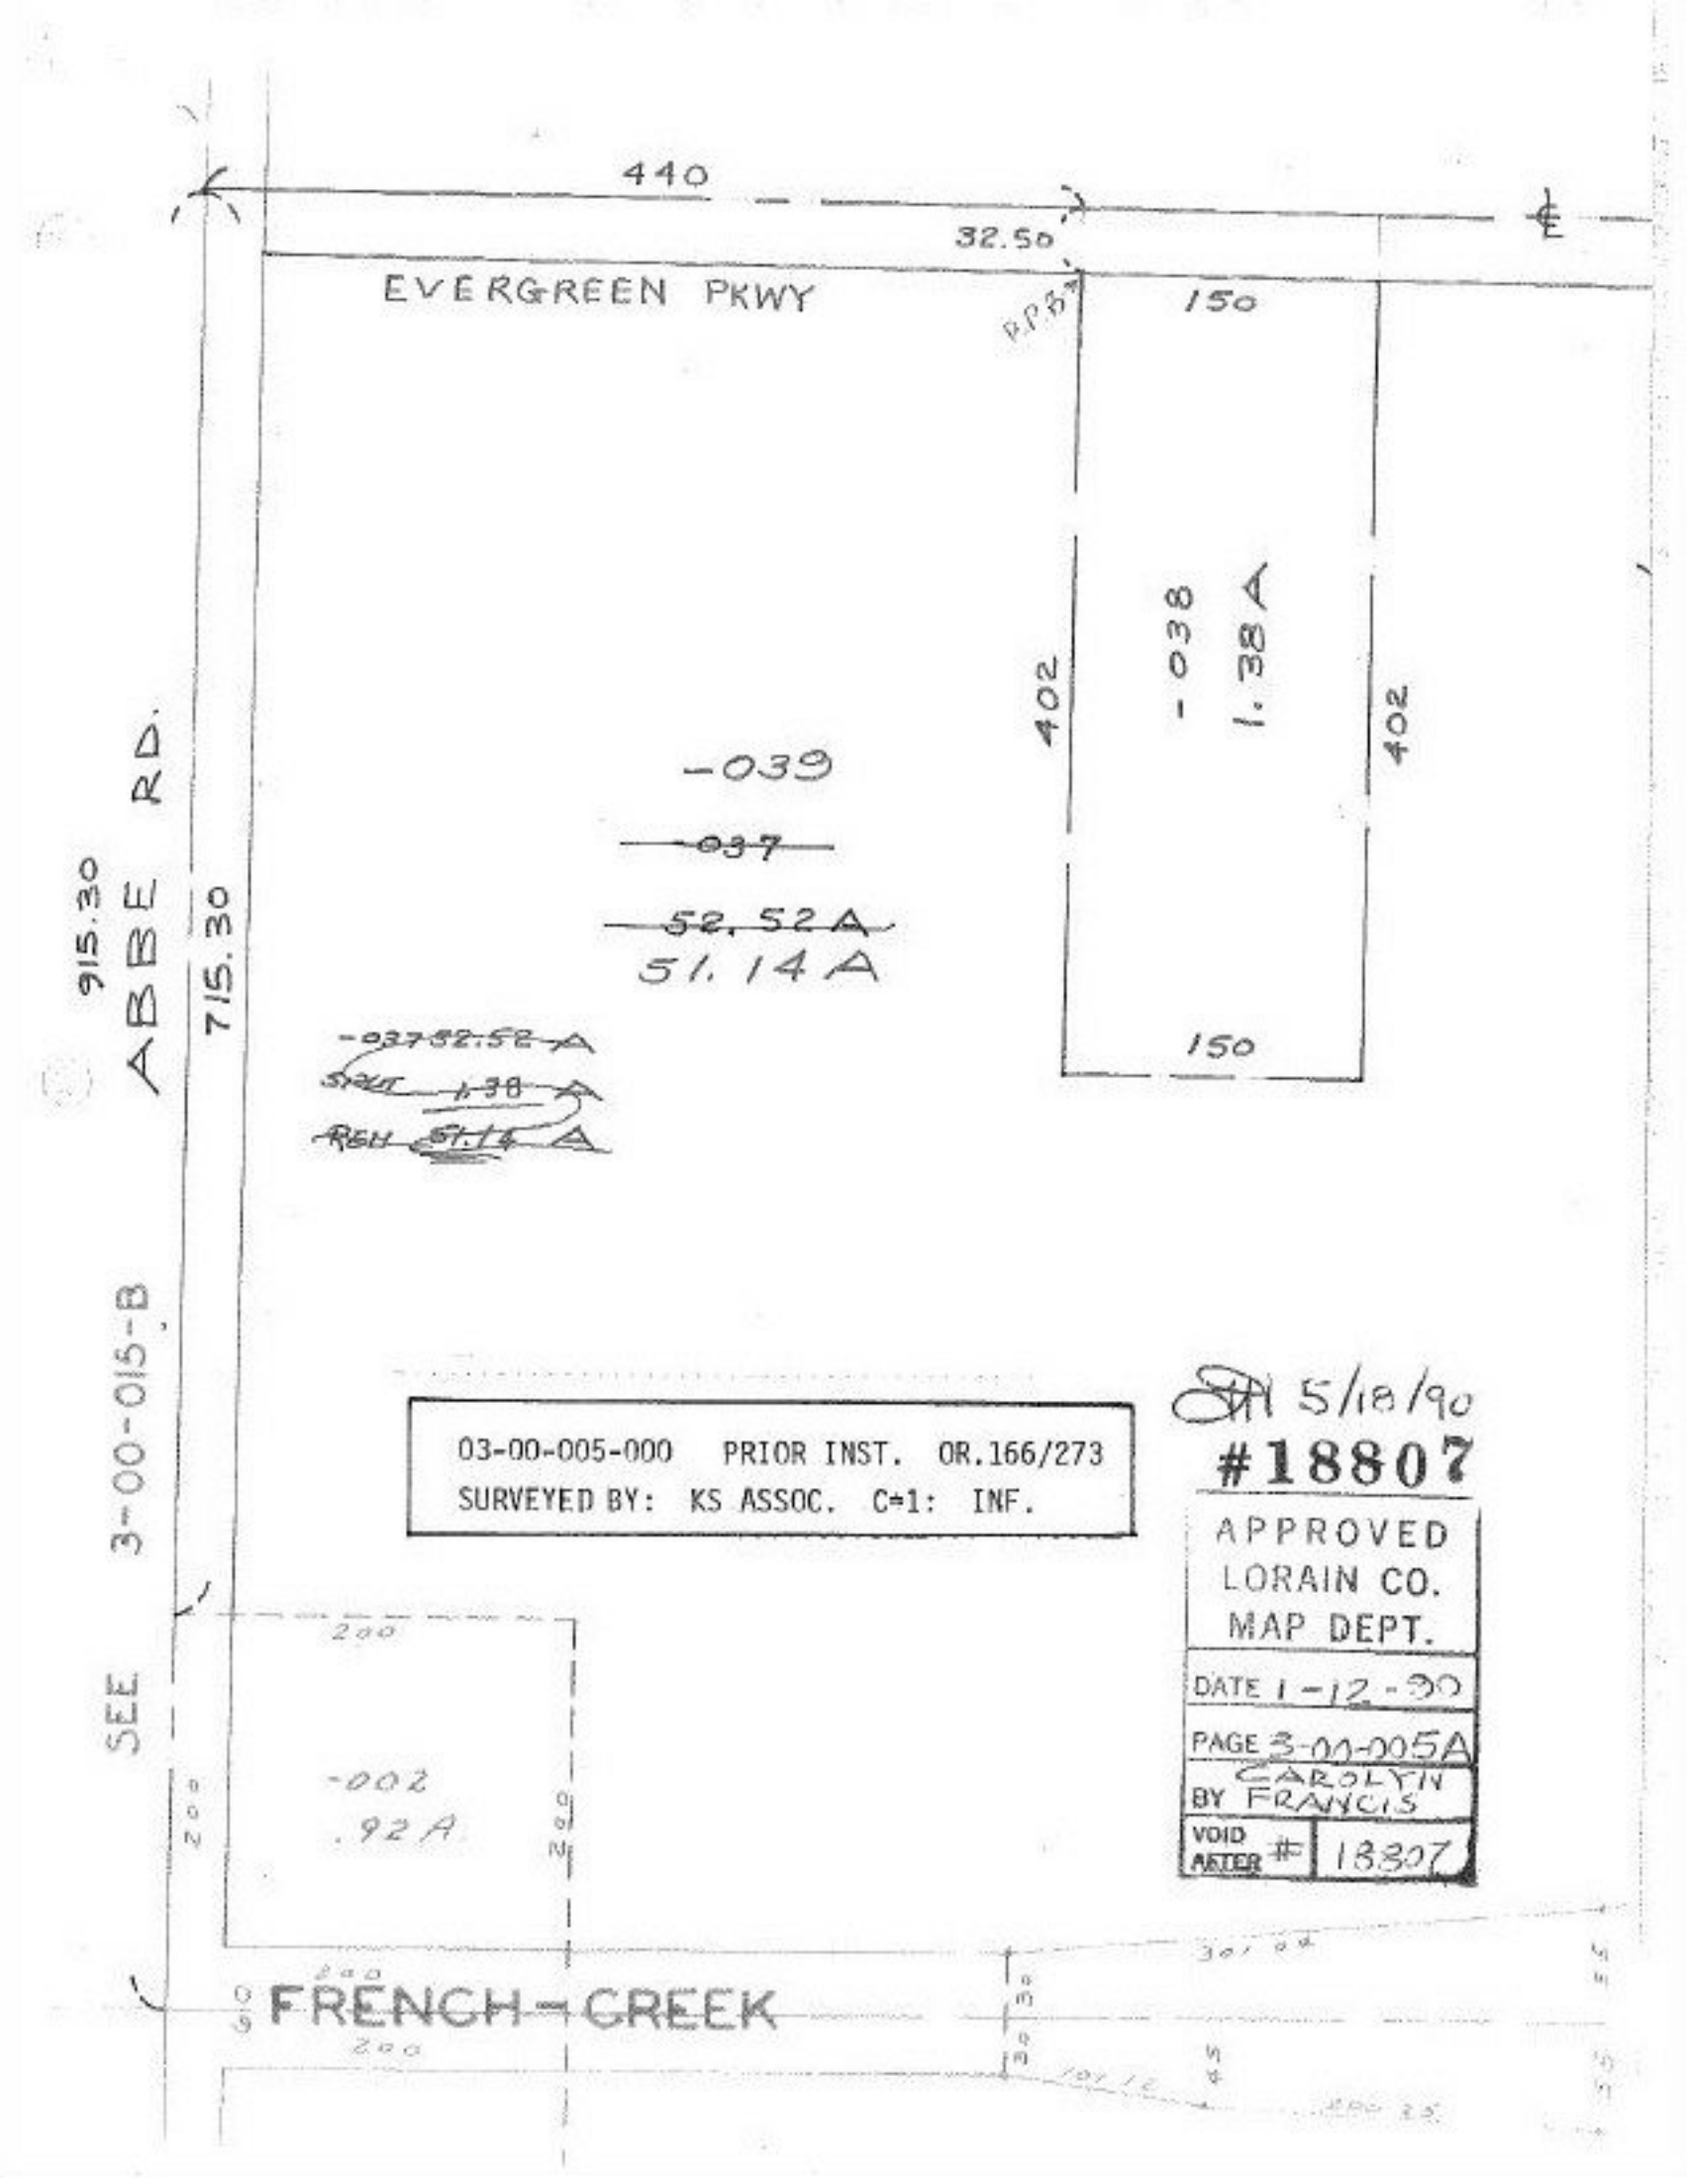
440
32.50
EVERGREEN PKWY
PPB
150
402
-038
1.38 A
402
150
-039
-037
52.52A
51.14A
-037 52.52 A
SPLIT 1.38 A
REM 51.14 A
915.30
715.30
ABBE RD.
3-00-015-B
SEE
-002
.92A
200
200
200
200
FRENCH-CREEK
03-00-005-000 PRIOR INST. OR.166/273
SURVEYED BY: KS ASSOC. C=1: INF.
5/18/90
#18807
APPROVED
LORAIN CO.
MAP DEPT.
DATE 1-12-90
PAGE 3-00-005A
BY CAROLYN FRANCIS
VOID AFTER # 18807