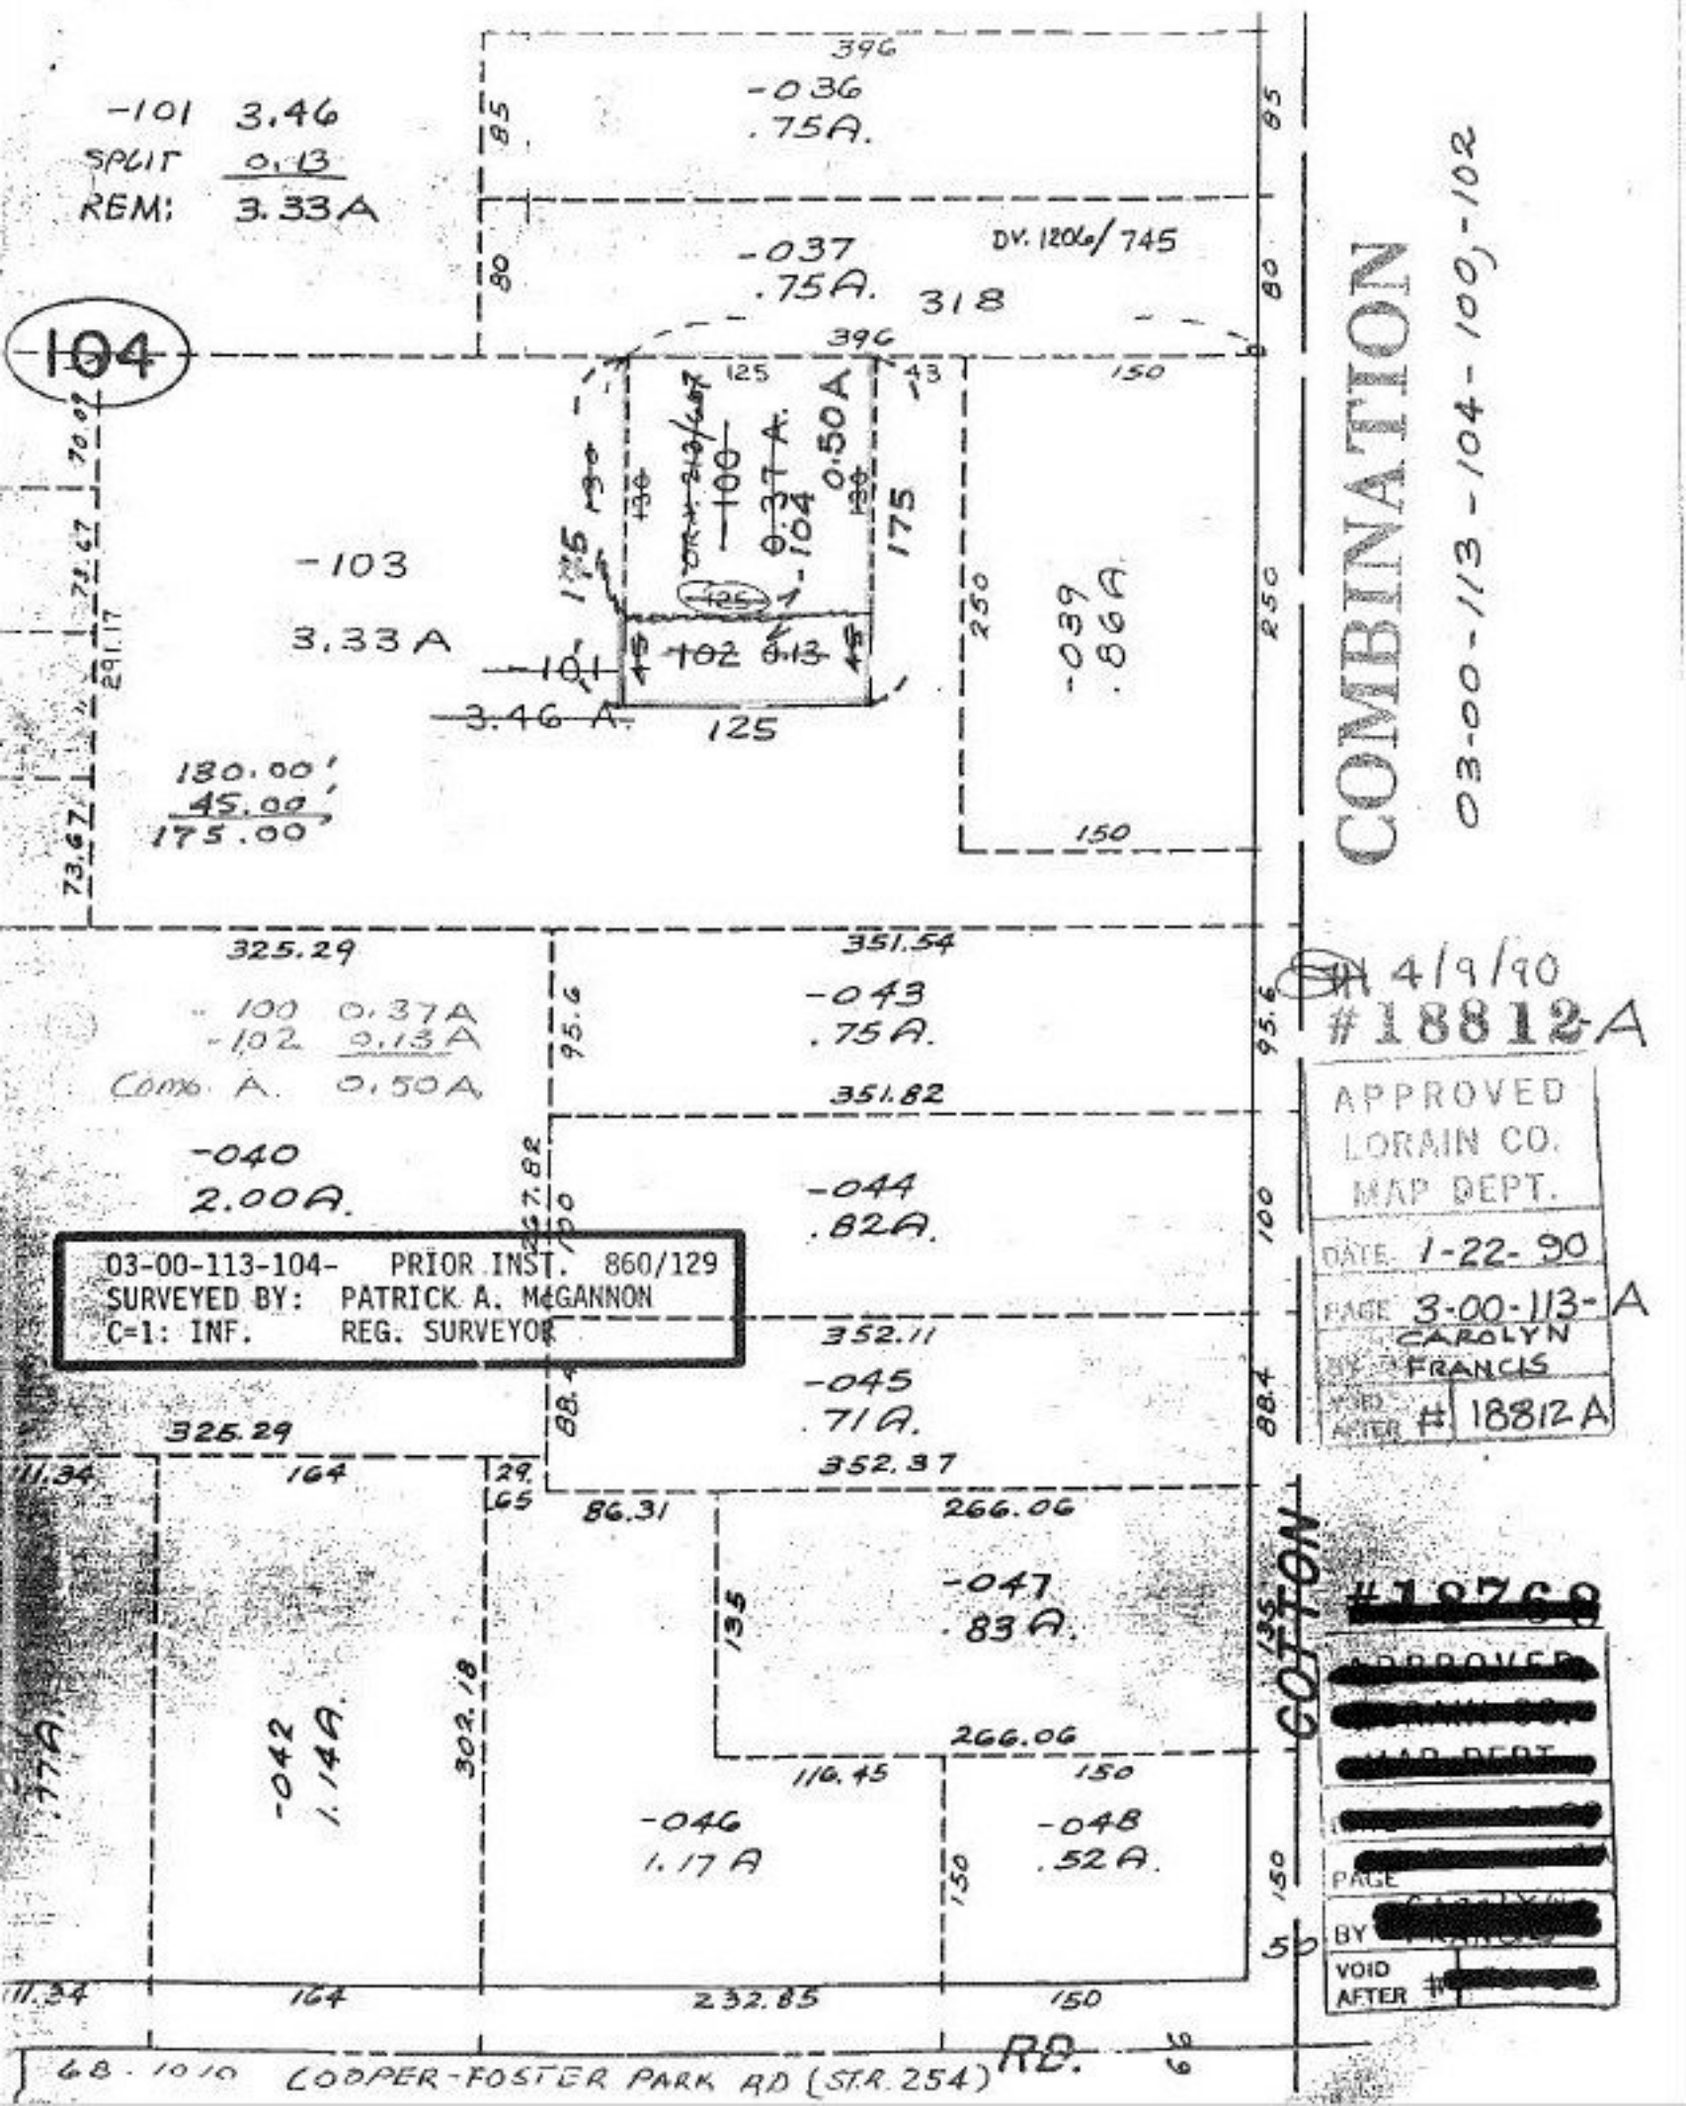

03-00-113-104- PRIOR INST. 860/129
SURVEYED BY: PATRICK A. McGANNON
C=1: INF. REG. SURVEYOR