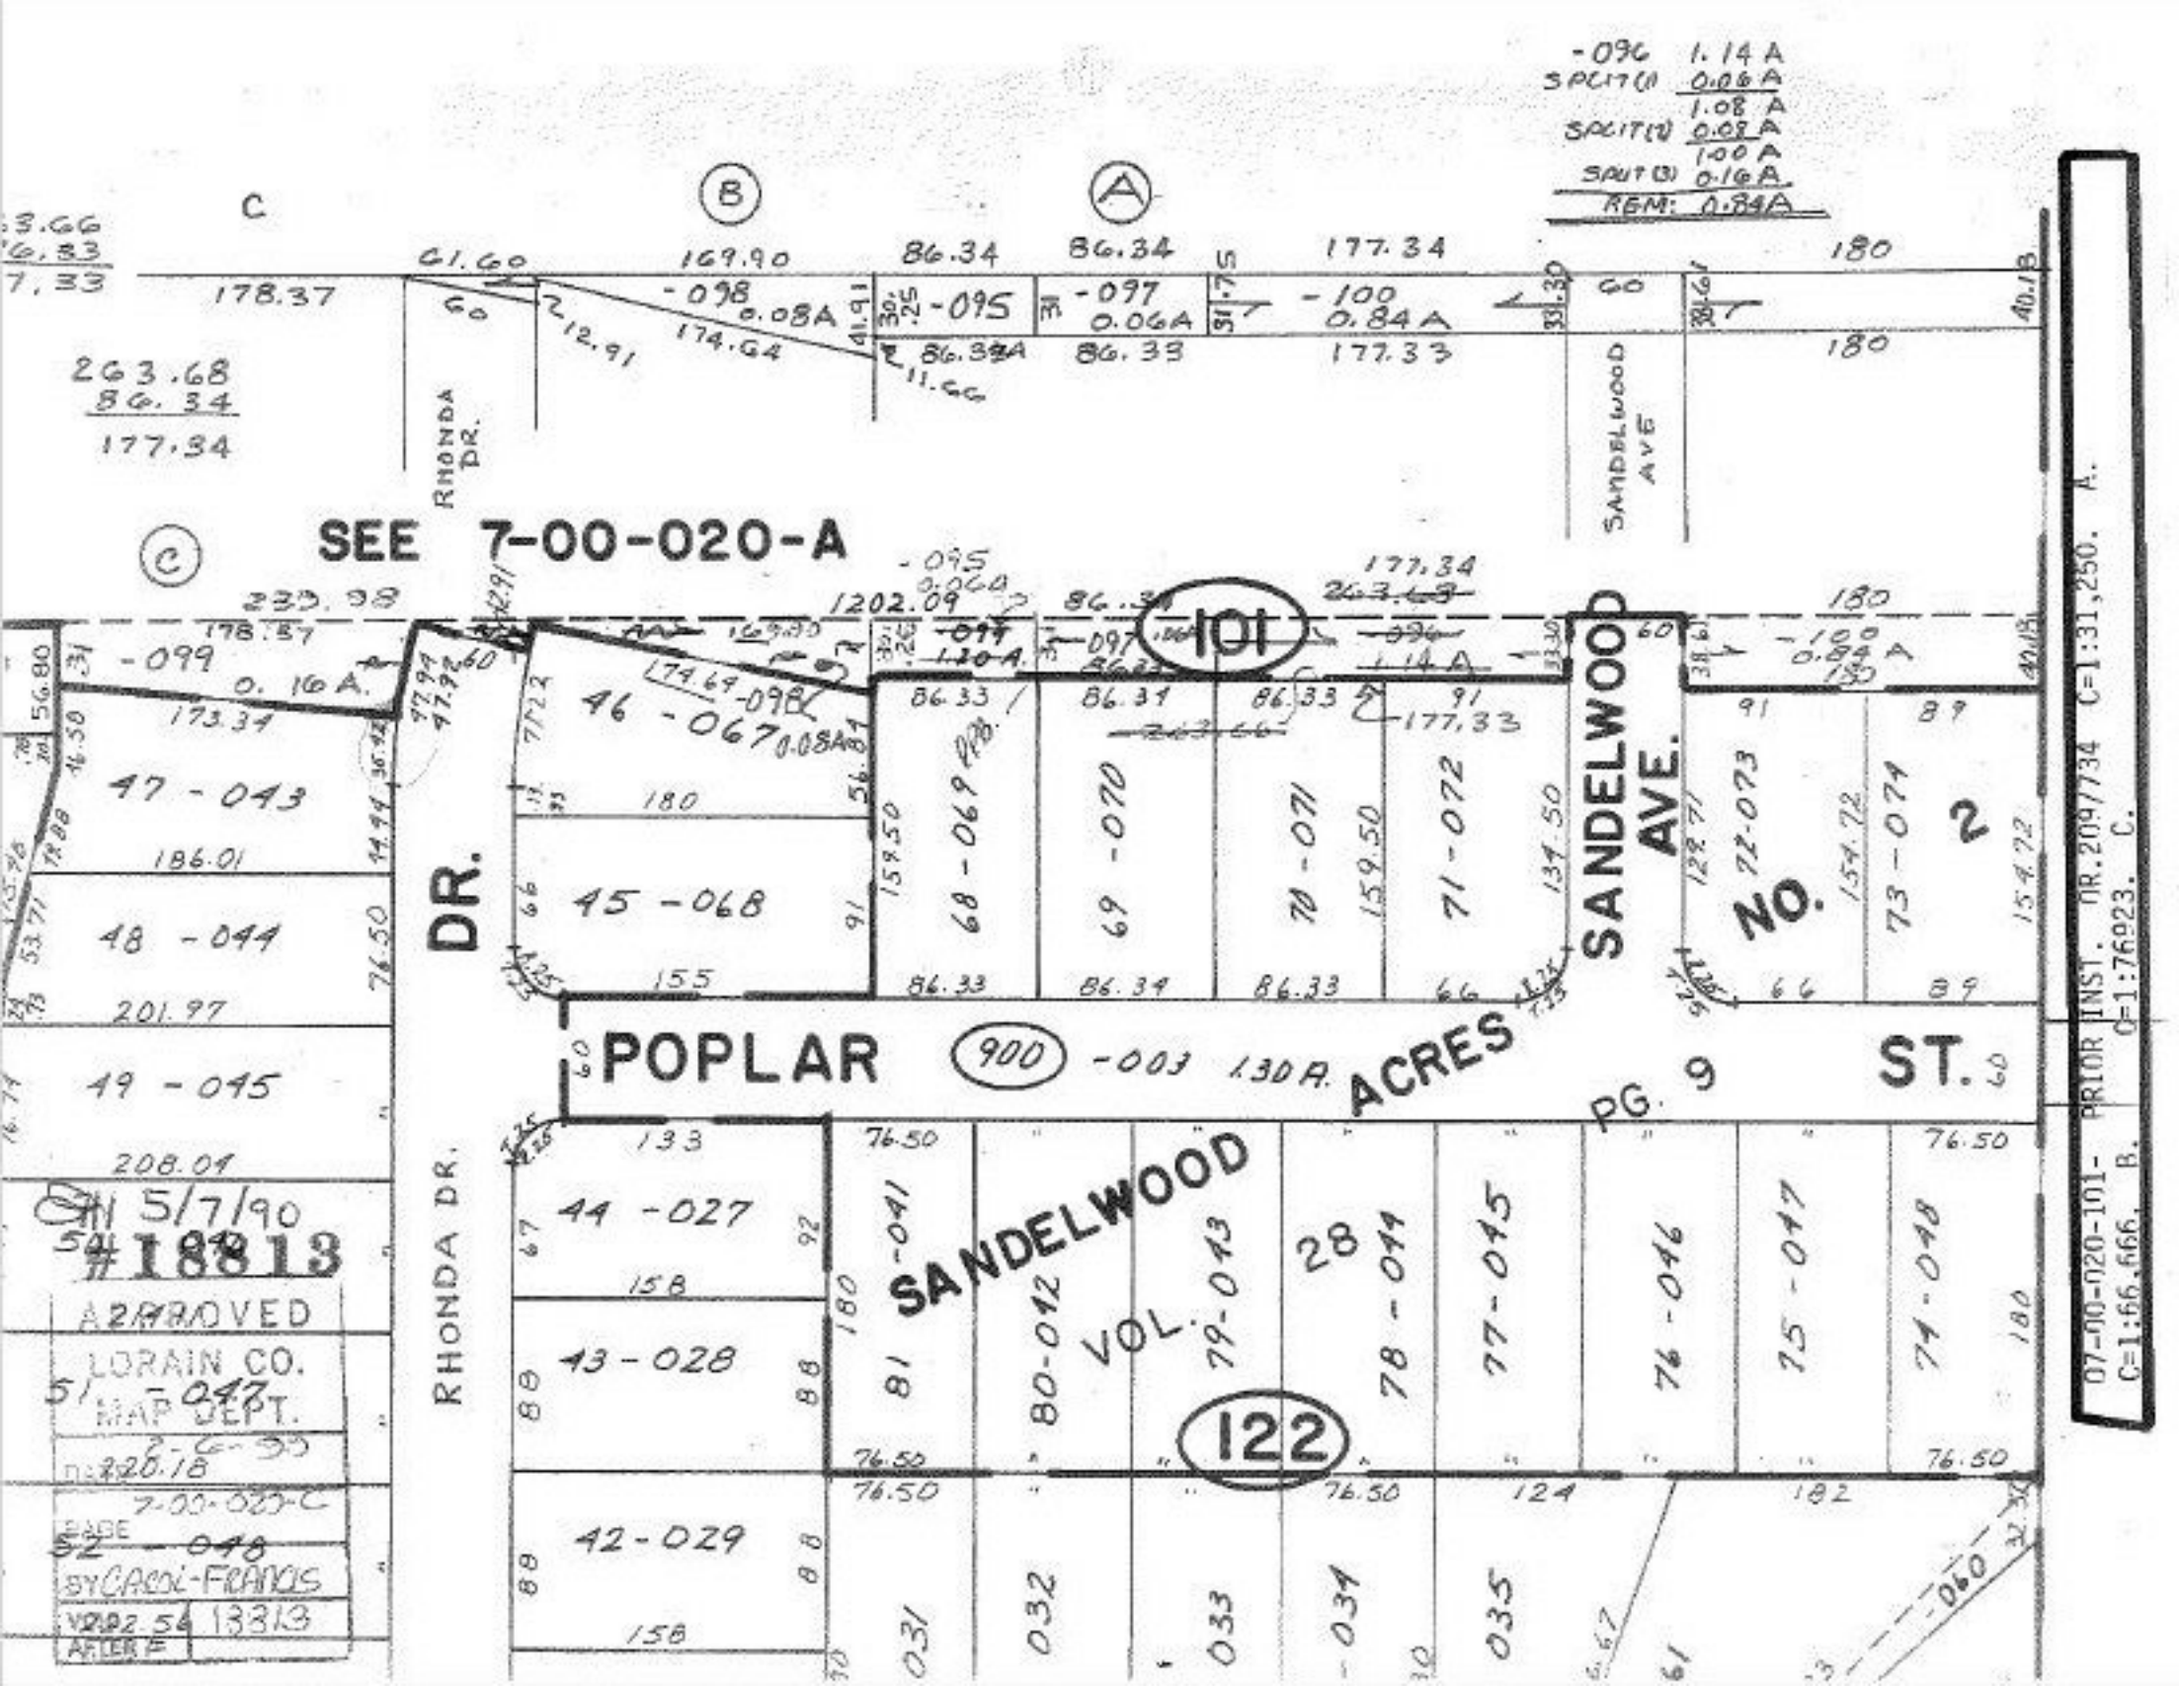
-096 1.14 A
SPLIT(1) 0.06 A
1.08 A
SPLIT(2) 0.08 A
1.00 A
SPLIT(3) 0.16 A
REM: 0.84A
C
B
A
178.37
61.60
169.90
86.34
86.34
177.34
180
-098 0.08A
-095
-097 0.06A
-100 0.84 A
263.68
86.34
177.34
RHONDA DR.
SANDELWOOD AVE
SEE 7-00-020-A
233.98
1202.09
101
-099 0.16 A
-095 0.06A
-097 1.30A
-096 1.14 A
-100 0.84 A
46 -067 0.08A
47 -043
186.01
48 -044
201.97
49 -045
208.01
45 -068
68 -069
69 -070
70 -071
71 -072
72-073
73 -071
SANDELWOOD AVE. NO. 2
POPLAR
900
-003 1.30 A.
ACRES
PG. 9
ST.
RHONDA DR.
44 -027
43 -028
42 -029
SANDELWOOD VOL.
81 -041
80-012
79-043
28
78 -044
77-045
76 -046
75 -047
74-048
122
031
032
033
-034
035
-060
07-00-020-101- PRIOR INST. OR.209/734 C=1:31,250. A.
C=1:66,666. B. C=1:76923. C.
5/7/90
#18813
APPROVED
LORAIN CO.
MAP DEPT.
7-00-020-C
BY CAROL-FRANOS
VOID 54 18813