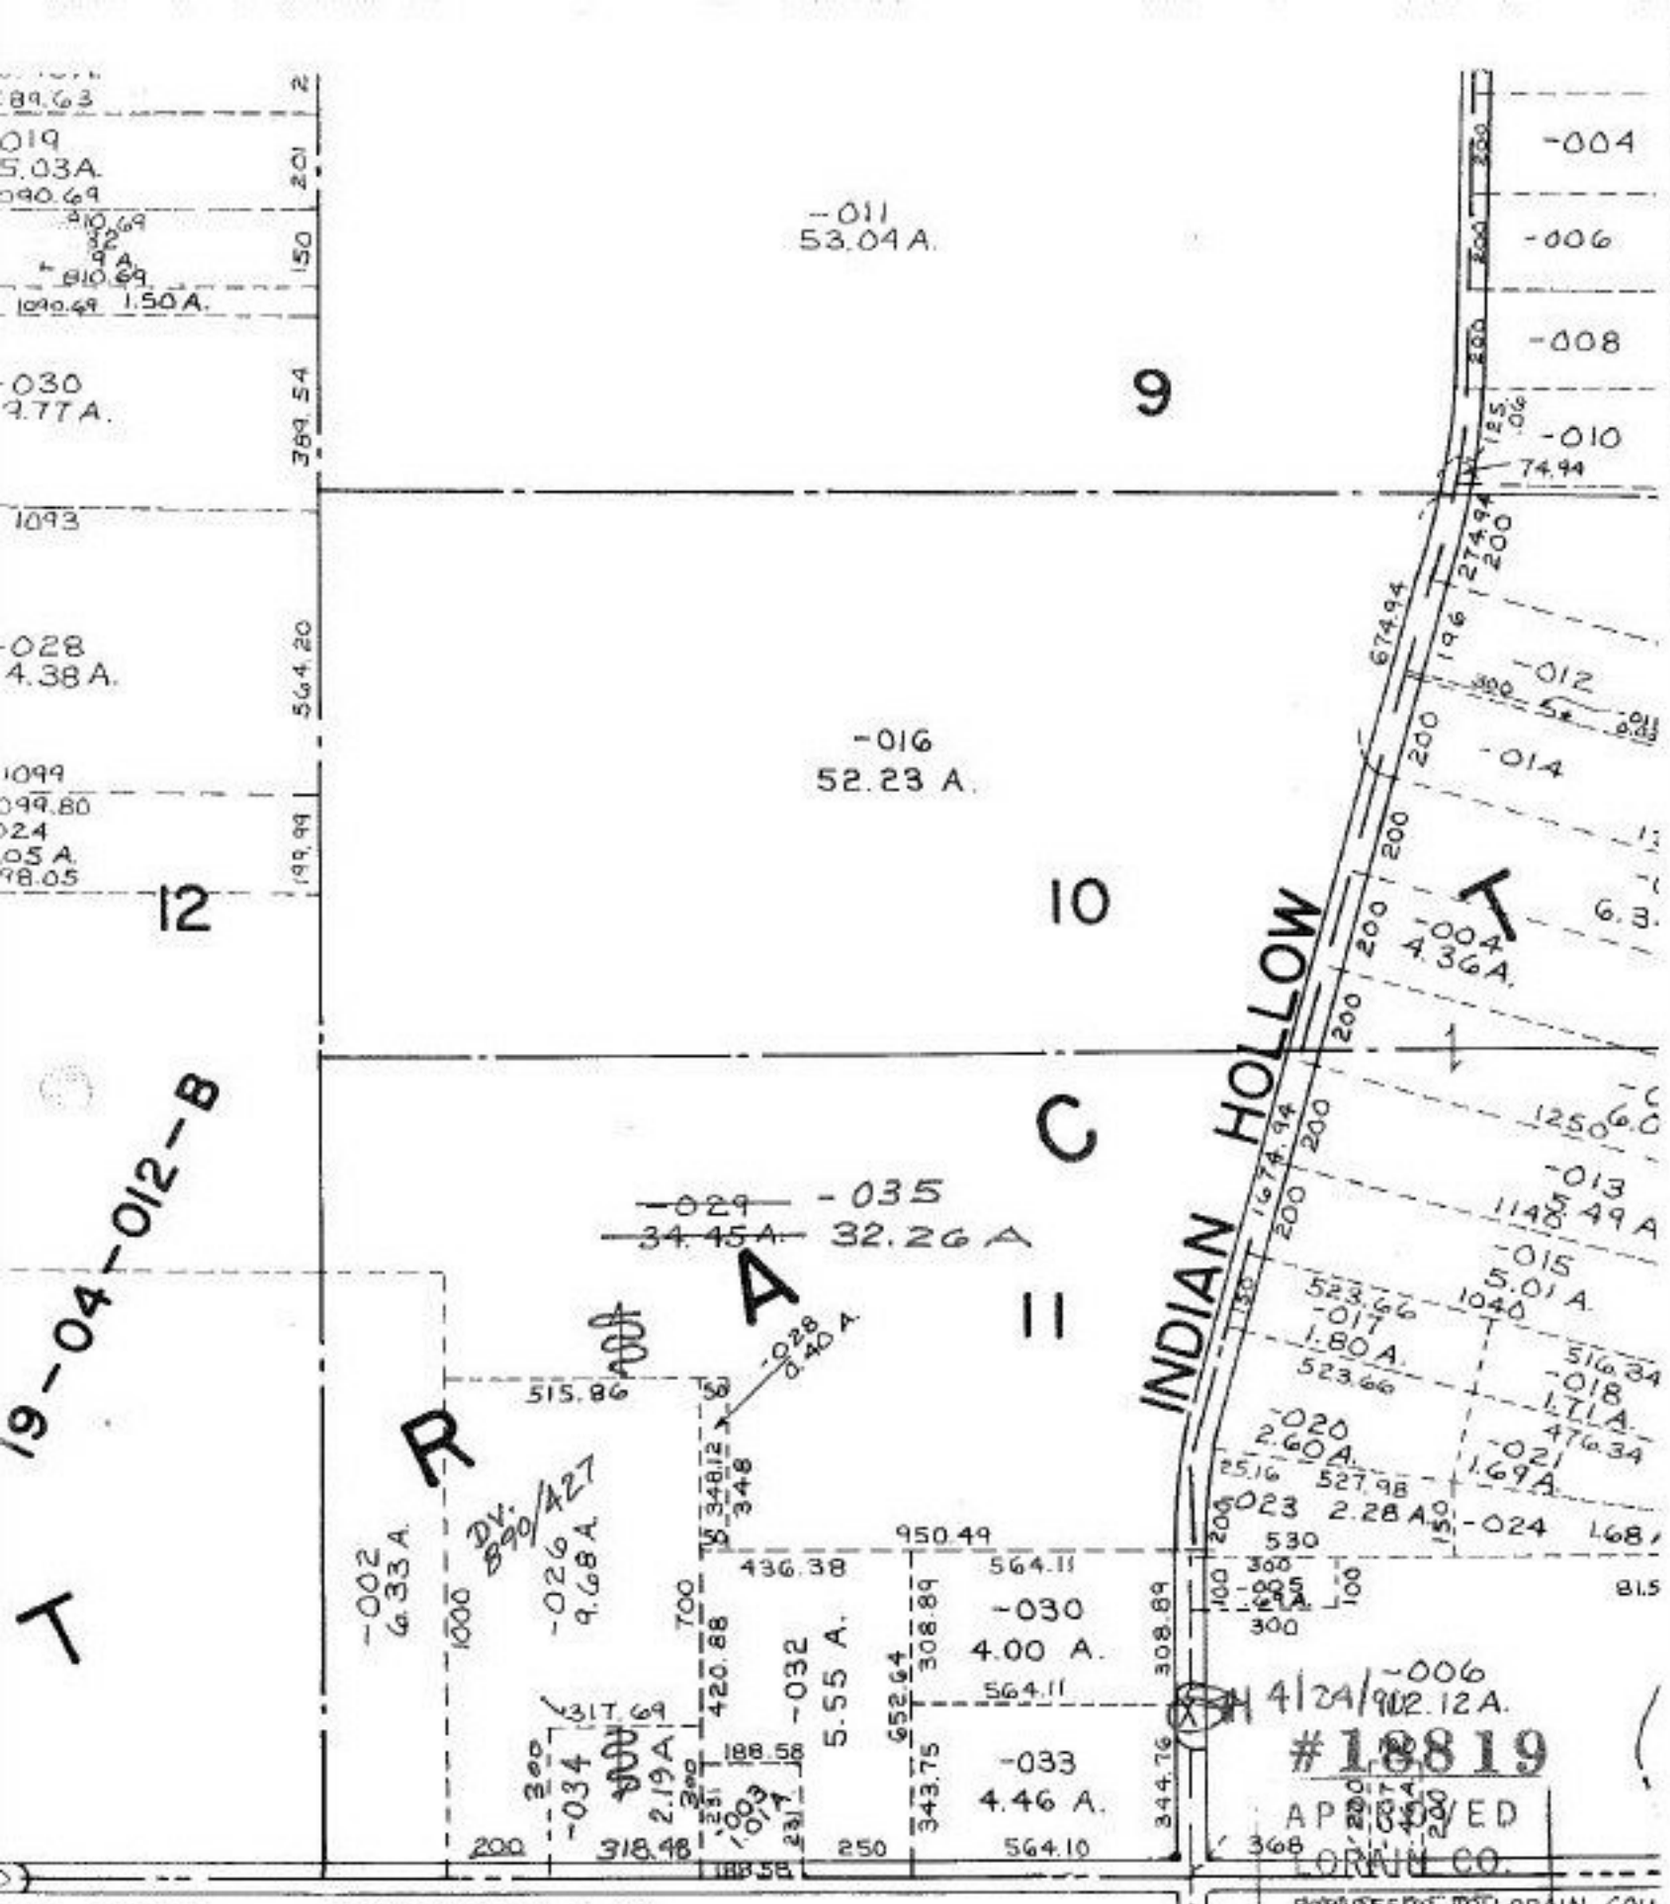
-011
53.04 A.
9
-004
-006
-008
-010
74.94
-012
-014
-016
52.23 A.
10
-004
4.36 A.
INDIAN HOLLOW
12
19-04-012-8
-029
34.45 A.
-035
32.26 A
11
C
A
R
T
-028
0.40 A.
-002
6.33 A.
-026
9.68 A.
Dv. 890/427
-032
5.55 A.
-030
4.00 A.
-033
4.46 A.
-034
2.19 A.
-013
11.49 A.
-015
5.01 A.
-017
1.80 A.
-018
1.11 A.
-020
2.60 A.
-021
1.69 A.
023
2.28 A.
-024
-006
12.12 A.
4/24/90
#18819
APPROVED
LORAIN CO.
515.86
436.38
950.49
564.11
564.10
318.98
343.75
344.76
308.89
652.64
420.88
317.69
188.58
523.66
527.98
516.34
476.34
674.94
1674.94
1148.49
1250
530
1040
MEDINA — NORTHWALK
19-04-011-000- PRIOR INST. 988/457
SURVEYED BY: DOUG MOSLEY REG. SURV. C=1:142857
TRACT 4 LOTS 9 THRU 12, 34, 35
MAP DEPT. LORAIN COUNTY
DATE 1-26-90
PAGE 19-C
BY CAROLYN FRANCIS
#18819