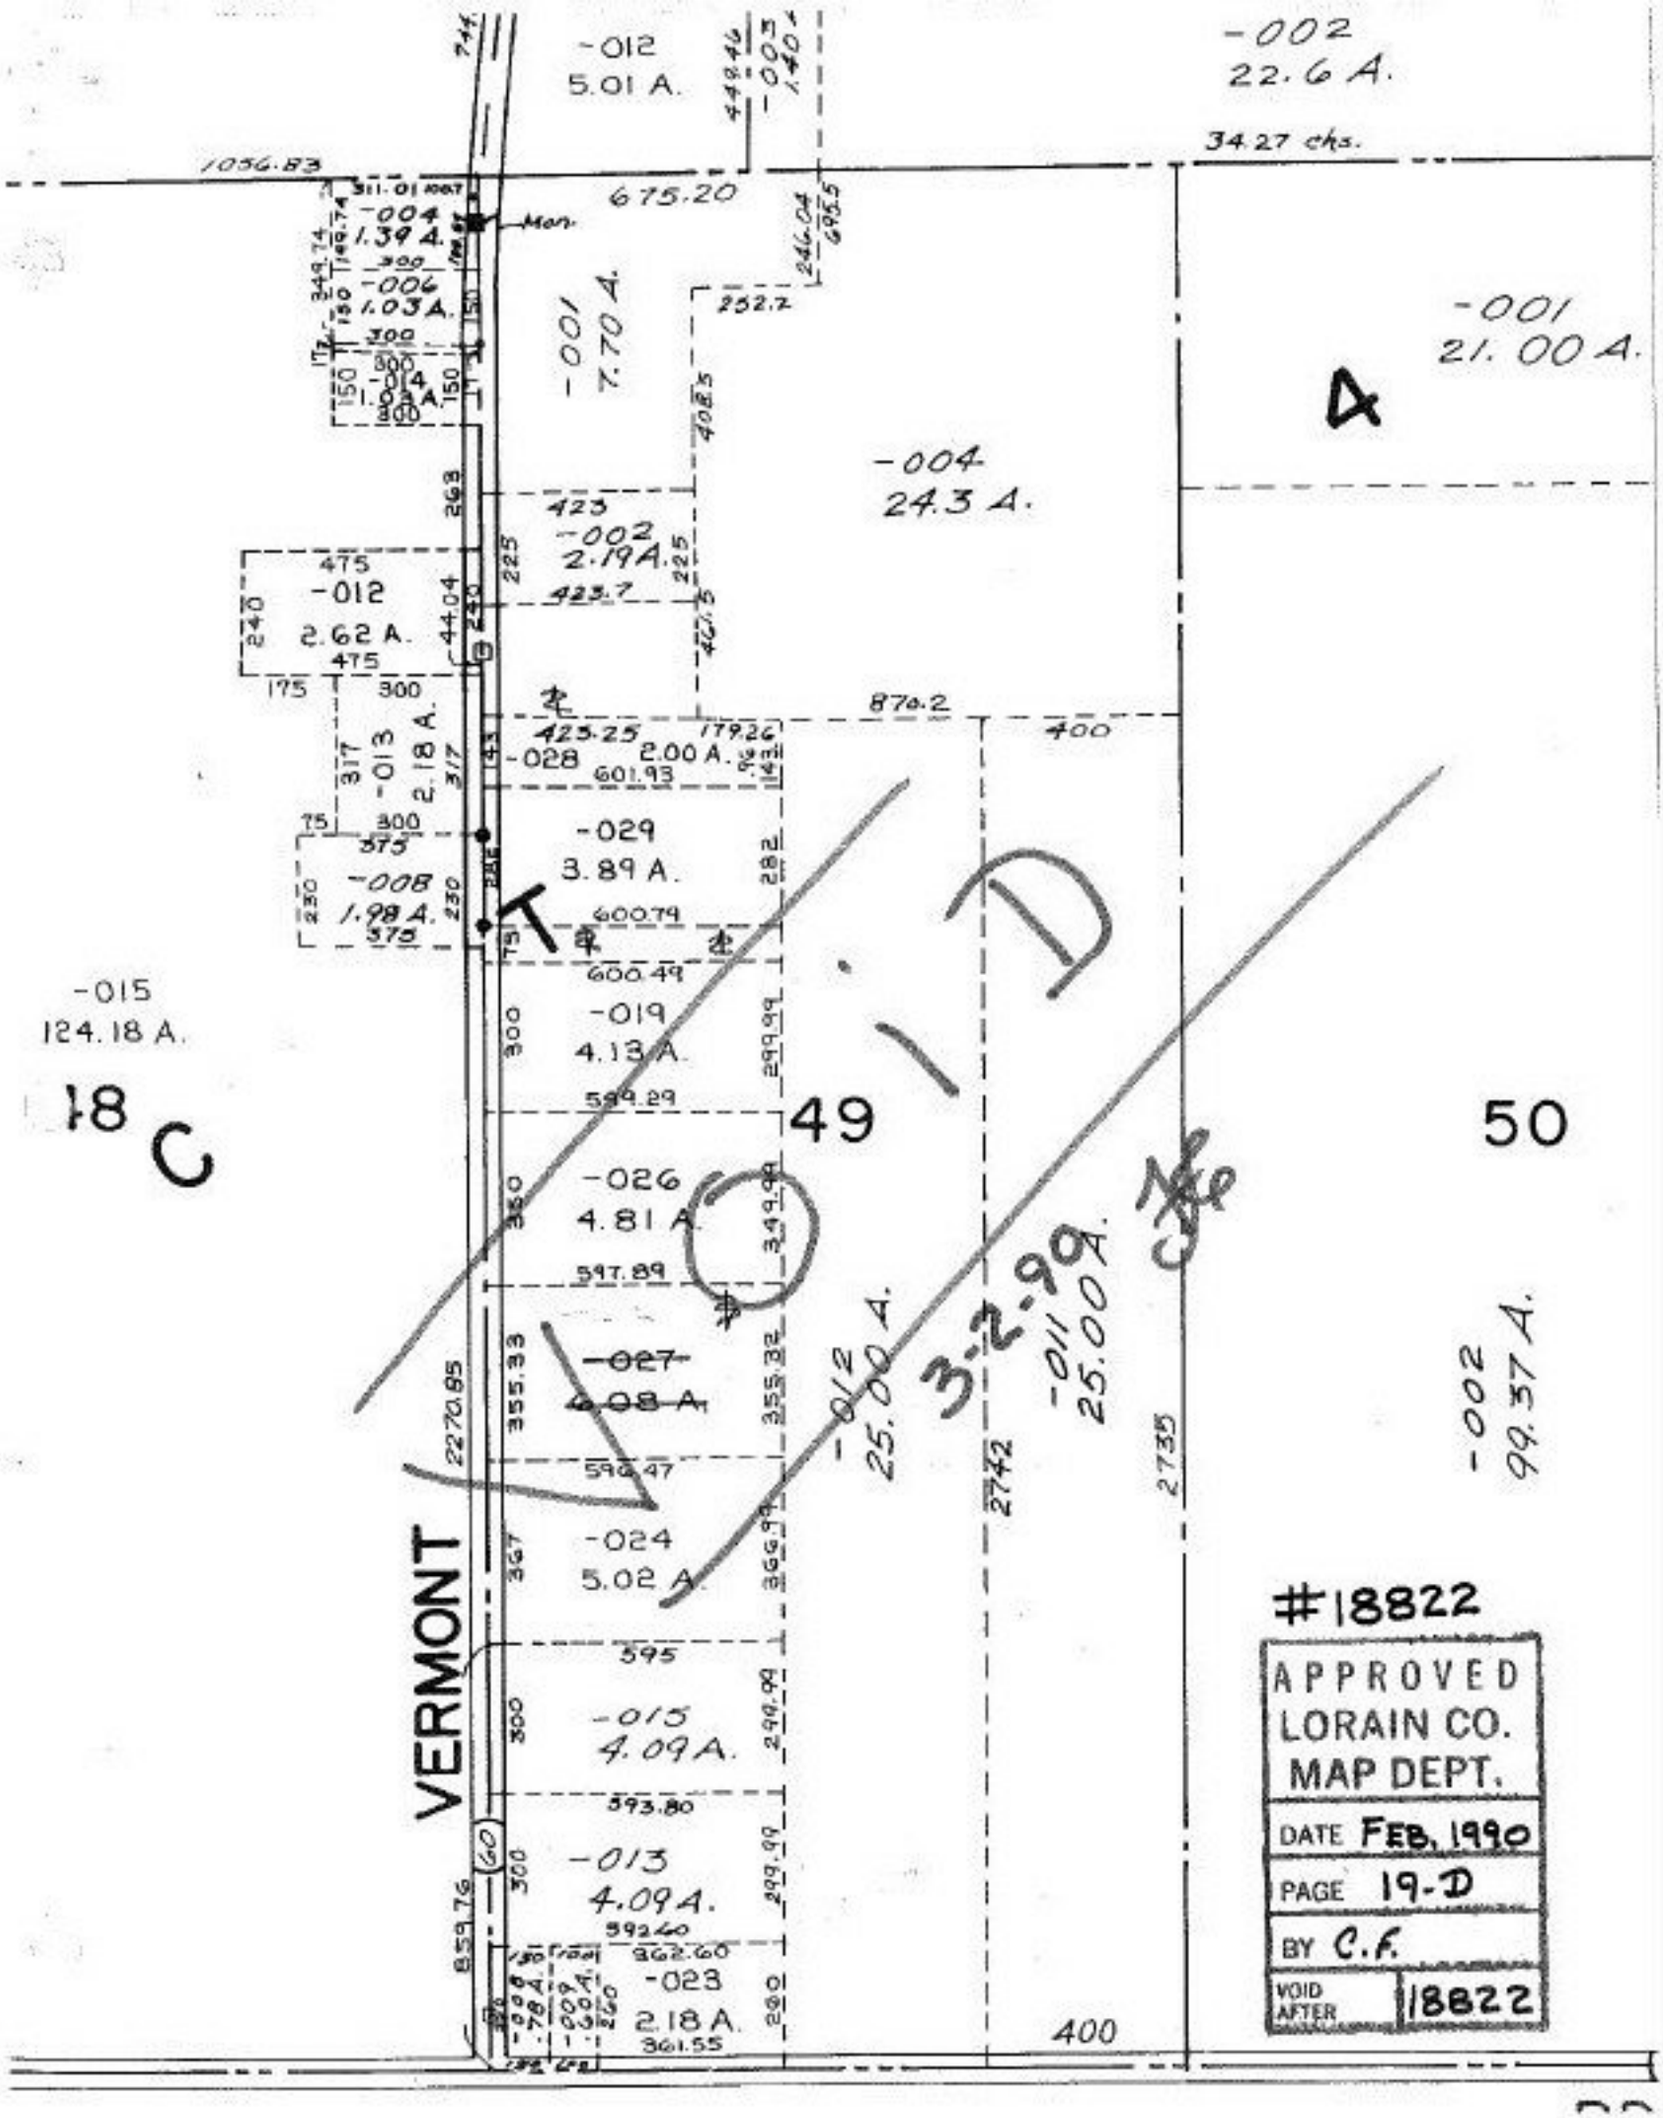
-012
5.01 A.
-002
22.6 A.
34.27 chs.
1056.83
675.20
-004
1.39 A.
-006
1.03 A.
-001
7.70 A.
-001
21.00 A.
A
-004
24.3 A.
-002
2.19A.
-012
2.62 A.
-013
2.18 A.
-028
2.00 A.
-029
3.89 A.
-008
1.98 A.
-015
124.18 A.
18 C
-019
4.13 A.
49
50
-026
4.81 A.
-027
4.08 A.
-012
25.00 A.
3-2-99
-011
25.000A.
-002
99.37 A.
VERMONT
-024
5.02 A.
-015
4.09A.
-013
4.09A.
-023
2.18 A.
400
#18822
APPROVED
LORAIN CO.
MAP DEPT.
DATE FEB. 1990
PAGE 19-D
BY C.F.
VOID AFTER 18822