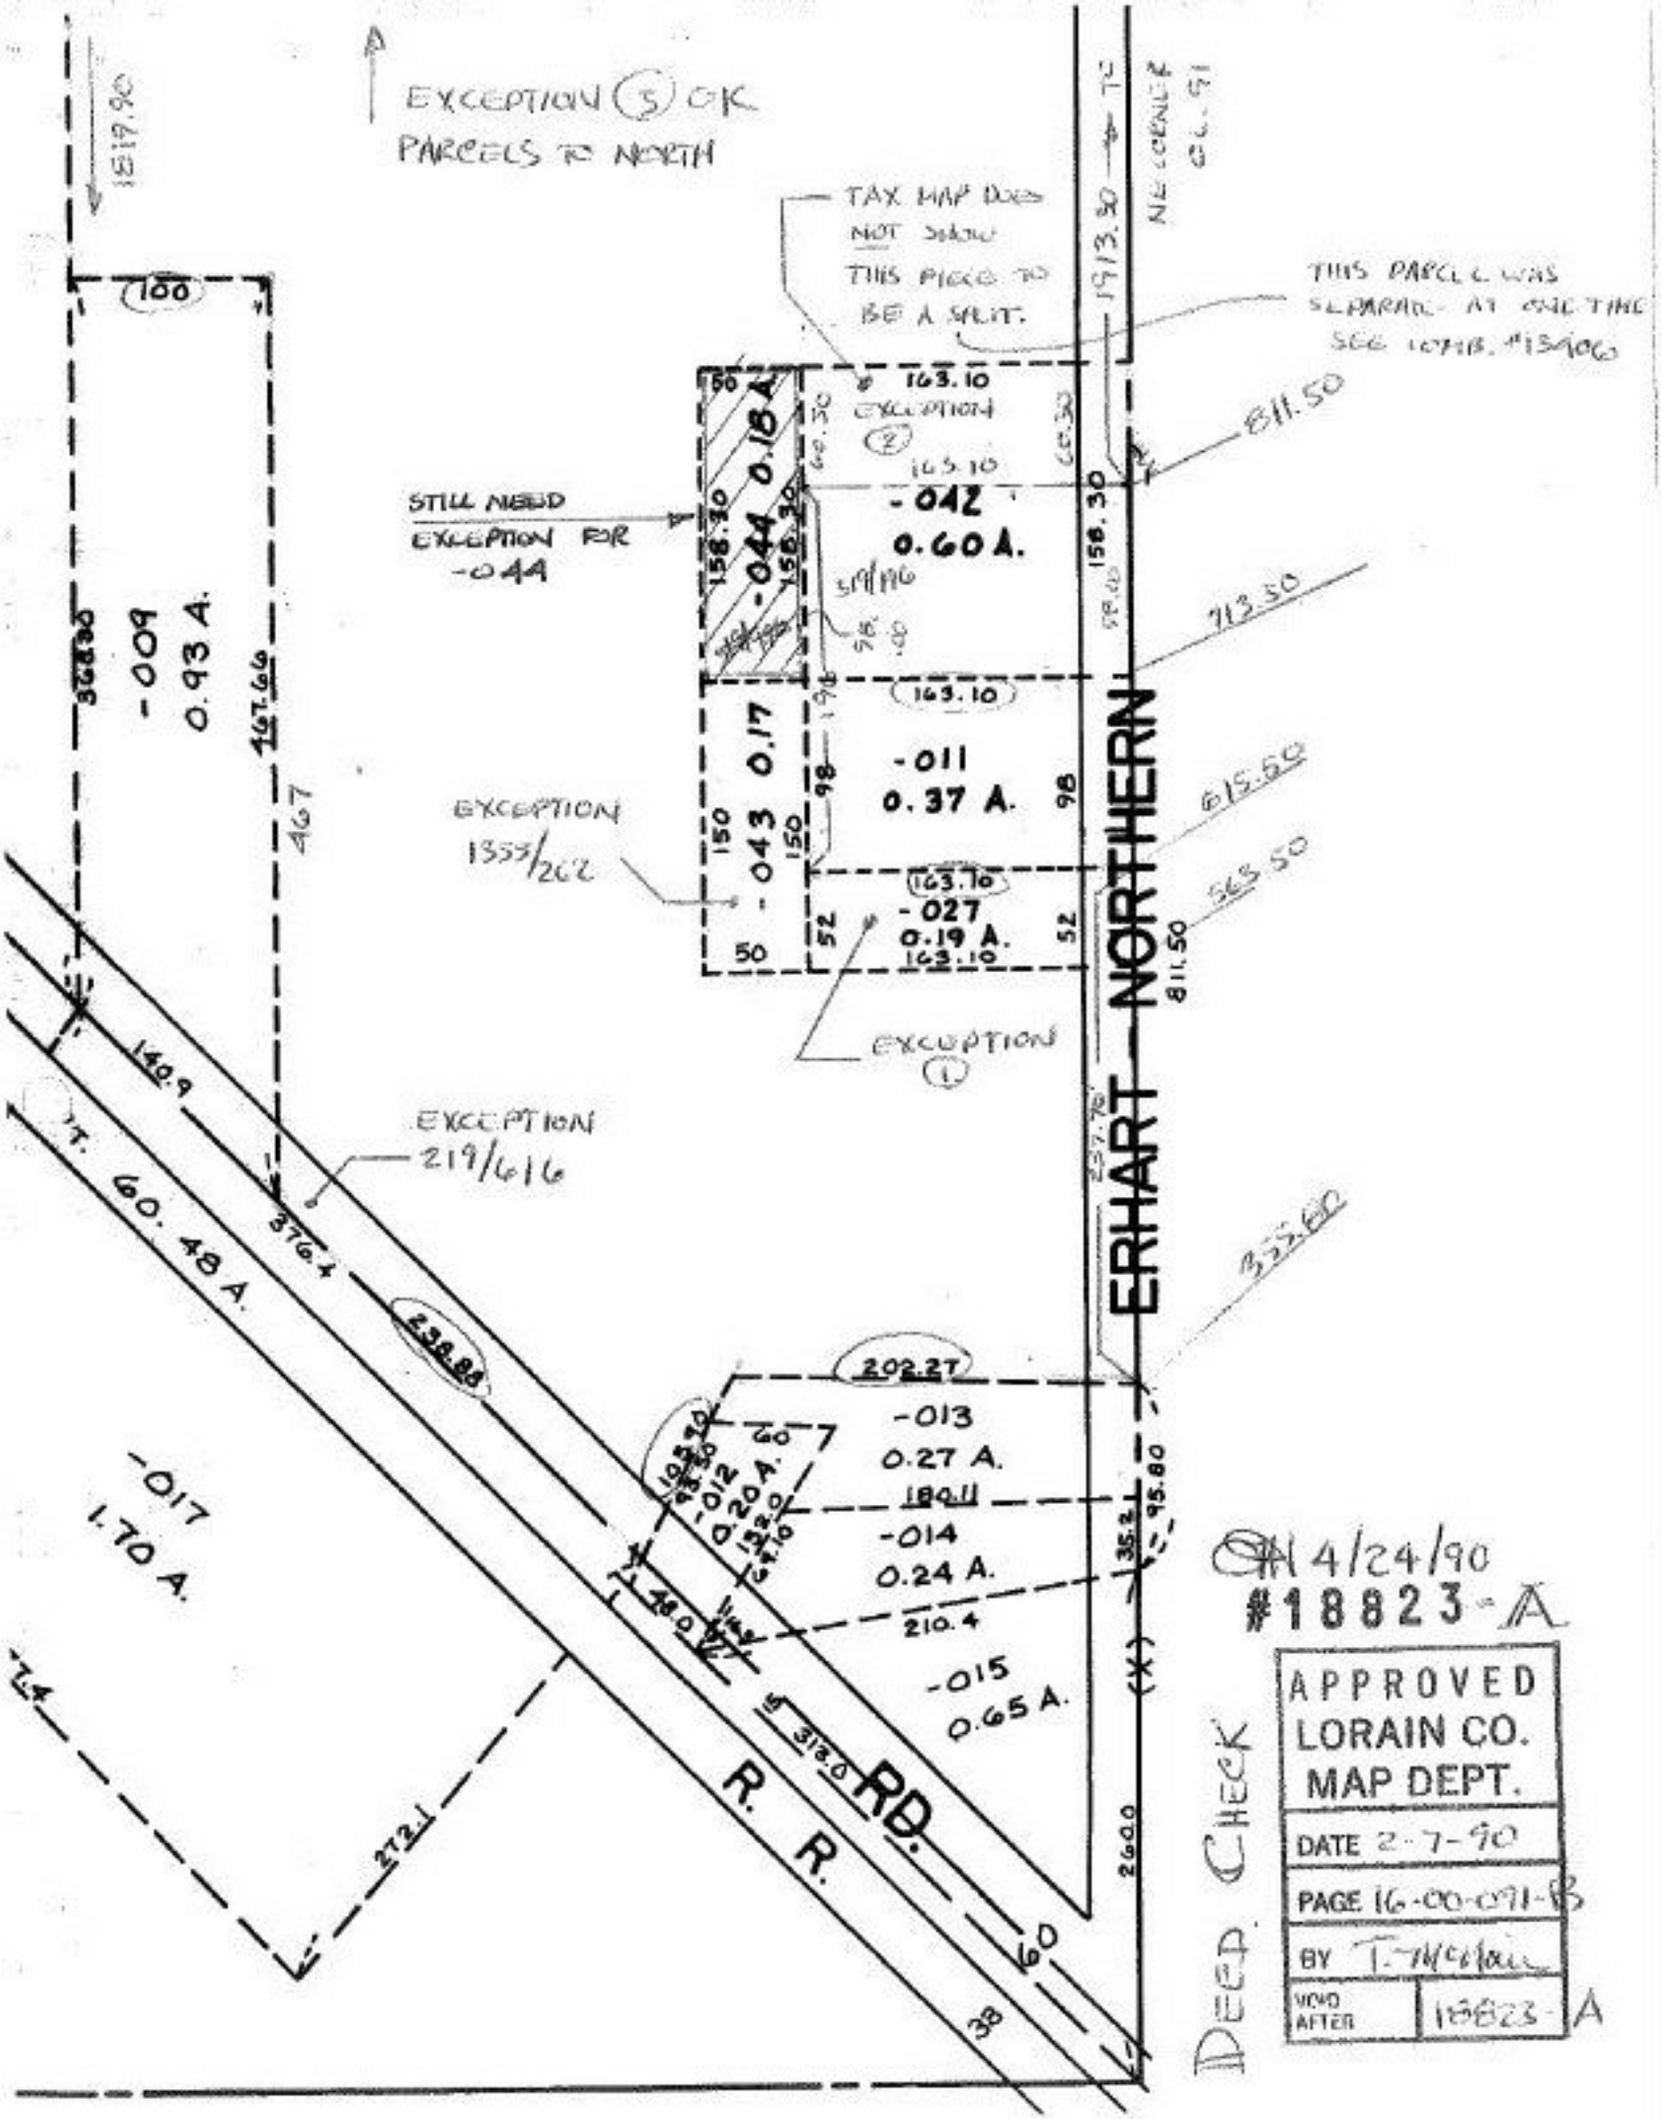
EXCEPTION (5) OK
PARCELS TO NORTH
TAX MAP DOES NOT SHOW THIS PIECE TO BE A SPLIT.
THIS PARCEL WAS SEPARATE AT ONE TIME SEE TOWN. #13406
STILL NEED EXCEPTION FOR -044
EXCEPTION 1353/262
EXCEPTION 219/616
EXCEPTION (1)
EXCEPTION (2)
-009 0.93 A.
-044 0.18 A.
-042 0.60 A.
-043 0.17
-011 0.37 A.
-027 0.19 A.
-013 0.27 A.
-012 0.20 A.
-014 0.24 A.
-015 0.65 A.
-017 1.70 A.
ERHART NORTHERN
R. R. RD.
811.50
713.50
615.50
565.50
322.60
95.80
2600.0
60
38
4/24/90
#18823-A
APPROVED
LORAIN CO.
MAP DEPT.
DATE 2-7-90
PAGE 16-00-091-B
BY T. McClain
VOID AFTER 18823-A
DEED CHECK