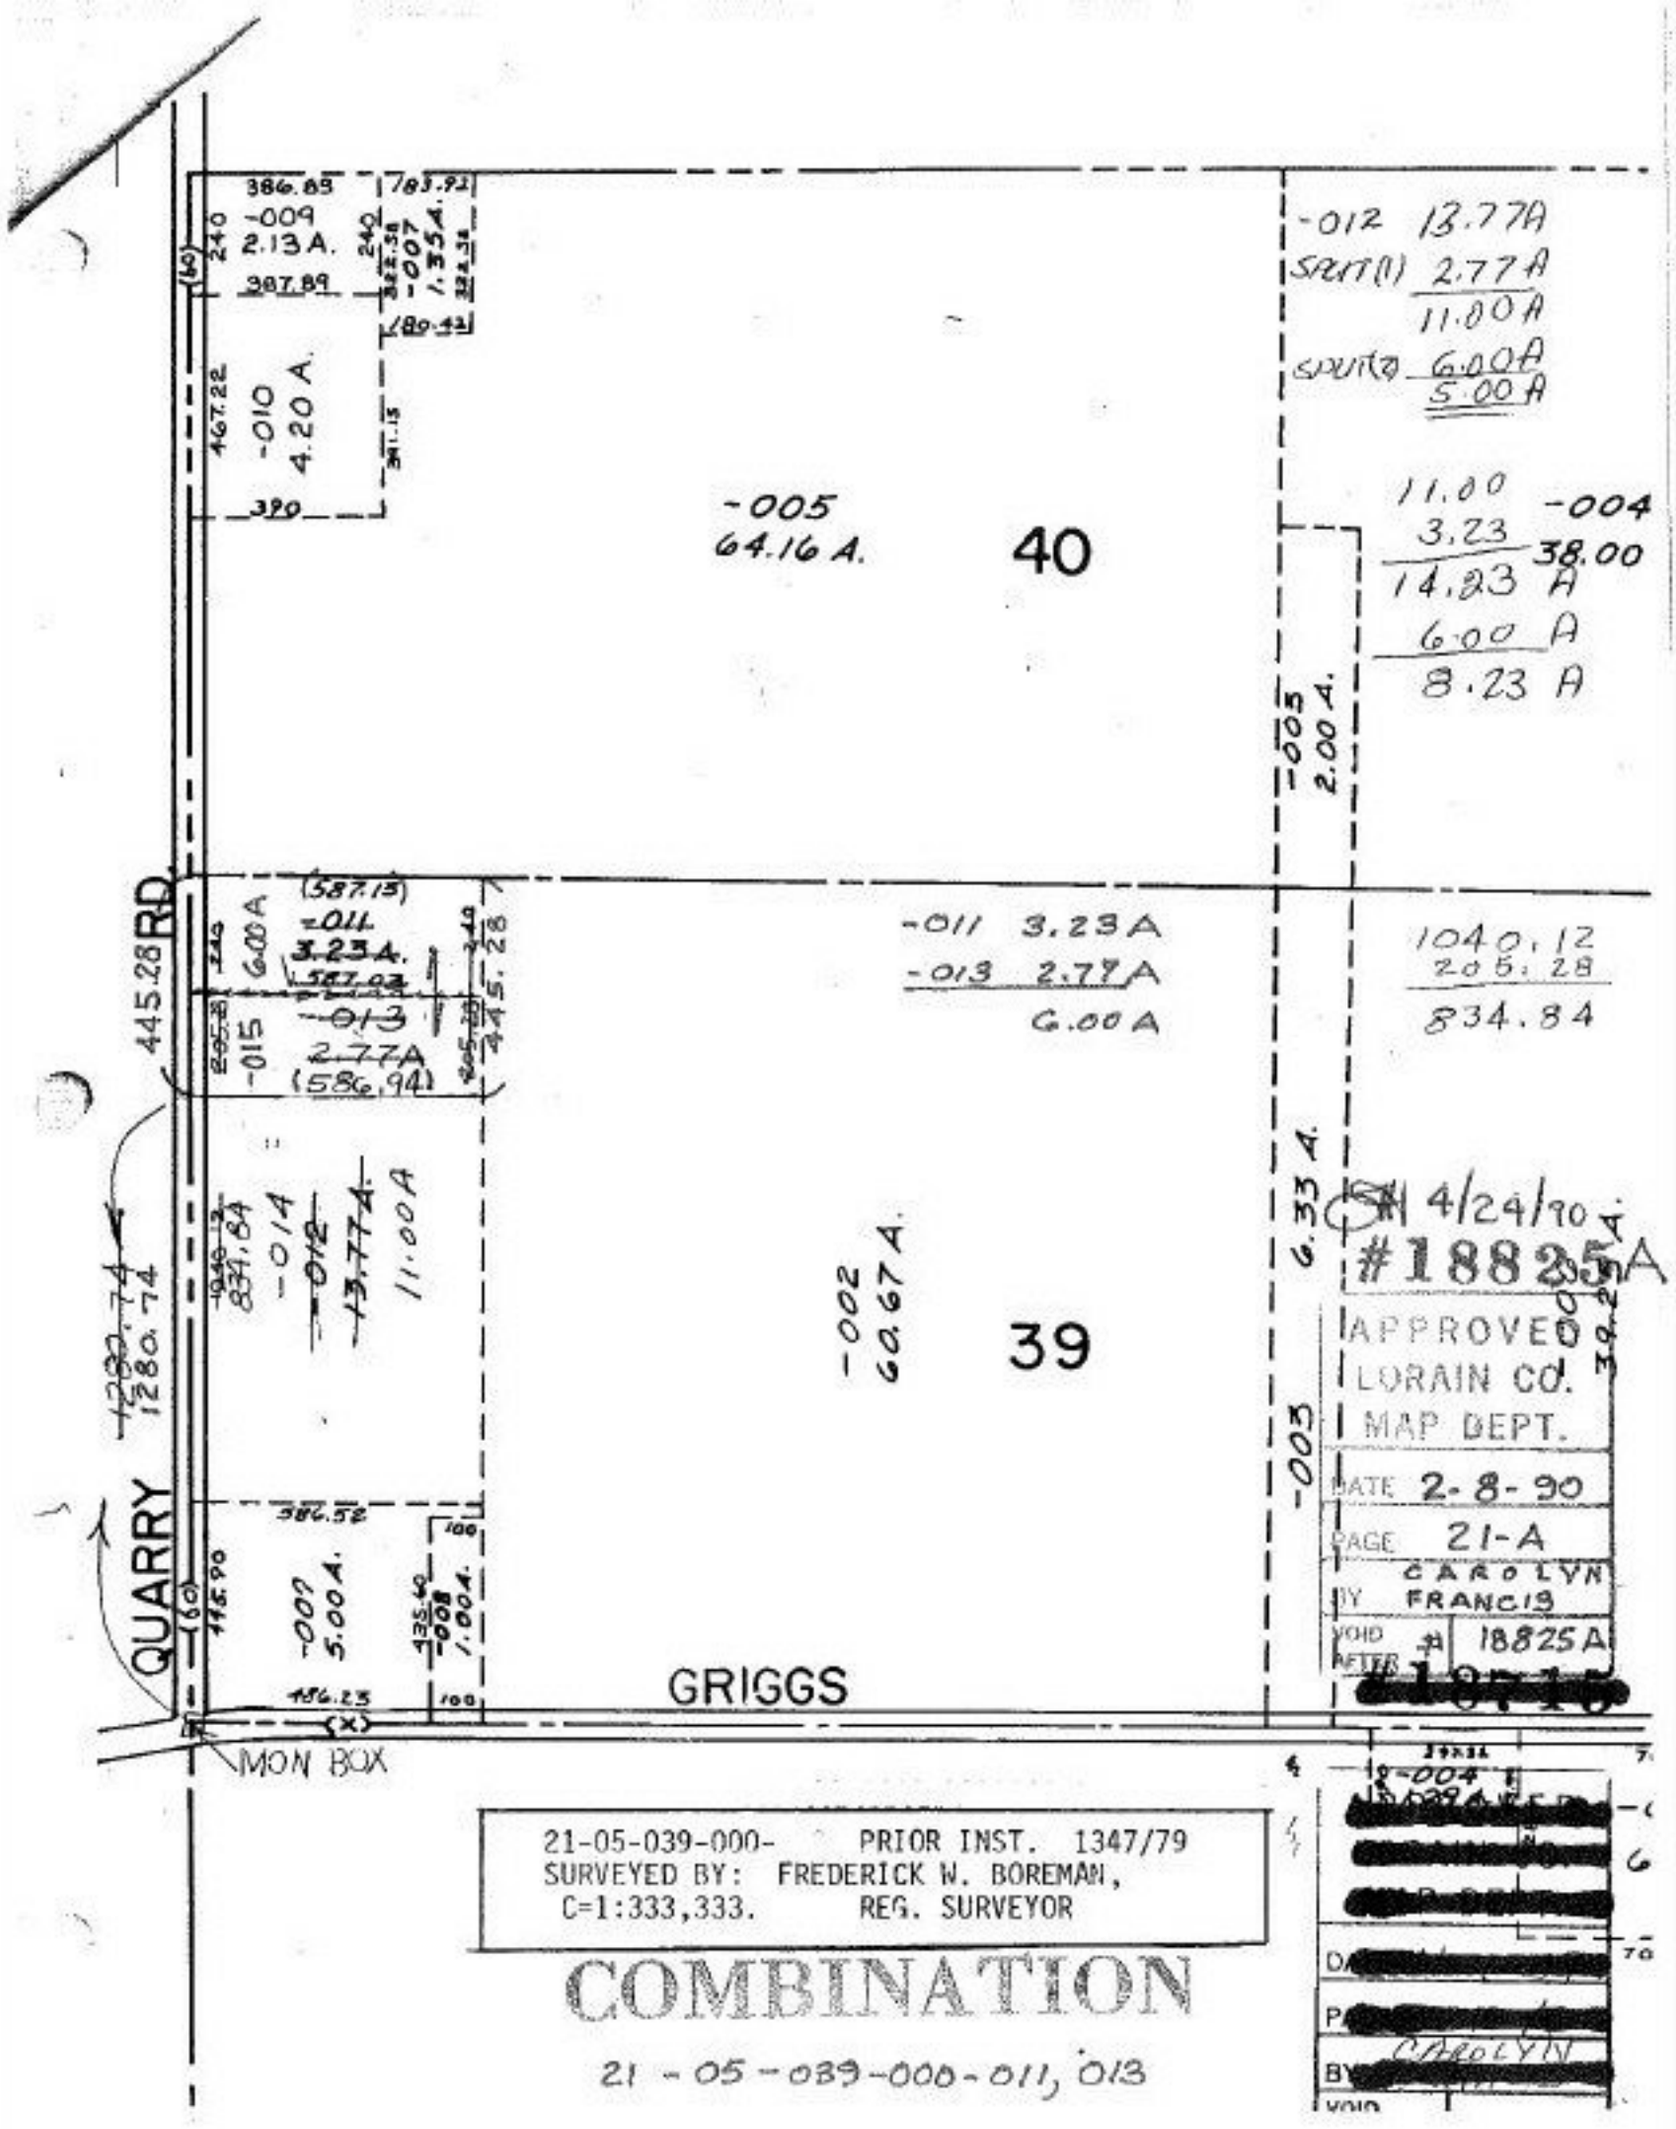
386.85
383.92
-009
2.13 A.
387.89
-007
1.354 A.
-010
4.20 A.
467.22
329
-005
64.16 A.
40
-012 13.77A
SPLIT(1) 2.77A
11.00A
SPLIT(2) 6.00A
5.00A
11.00
3.23
14.23 A
-004
38.00
6.00 A
8.23 A
-005
2.00 A.
587.13
-011
3.23A.
587.03
445.28
RD.
-013
2.77A
(586.94)
-015
6.00A
-011 3.23A
-013 2.77A
6.00A
1040.12
205.28
834.84
-014
-012
13.77A.
11.00A
834.84
1280.74
1280.74
QUARRY
-002
60.67A.
39
6.33 A.
-003
4/24/90
#18825A
APPROVED
LORAIN CO.
MAP DEPT.
DATE 2-8-90
PAGE 21-A
BY CAROLYN FRANCIS
VOID AFTER #18825A
382.52
-001
5.00A.
-008
1.00A.
135.40
100
186.23
GRIGGS
MON BOX
21-05-039-000- PRIOR INST. 1347/79
SURVEYED BY: FREDERICK W. BOREMAN,
C=1:333,333. REG. SURVEYOR
COMBINATION
21 - 05 - 039 - 000 - 011, 013