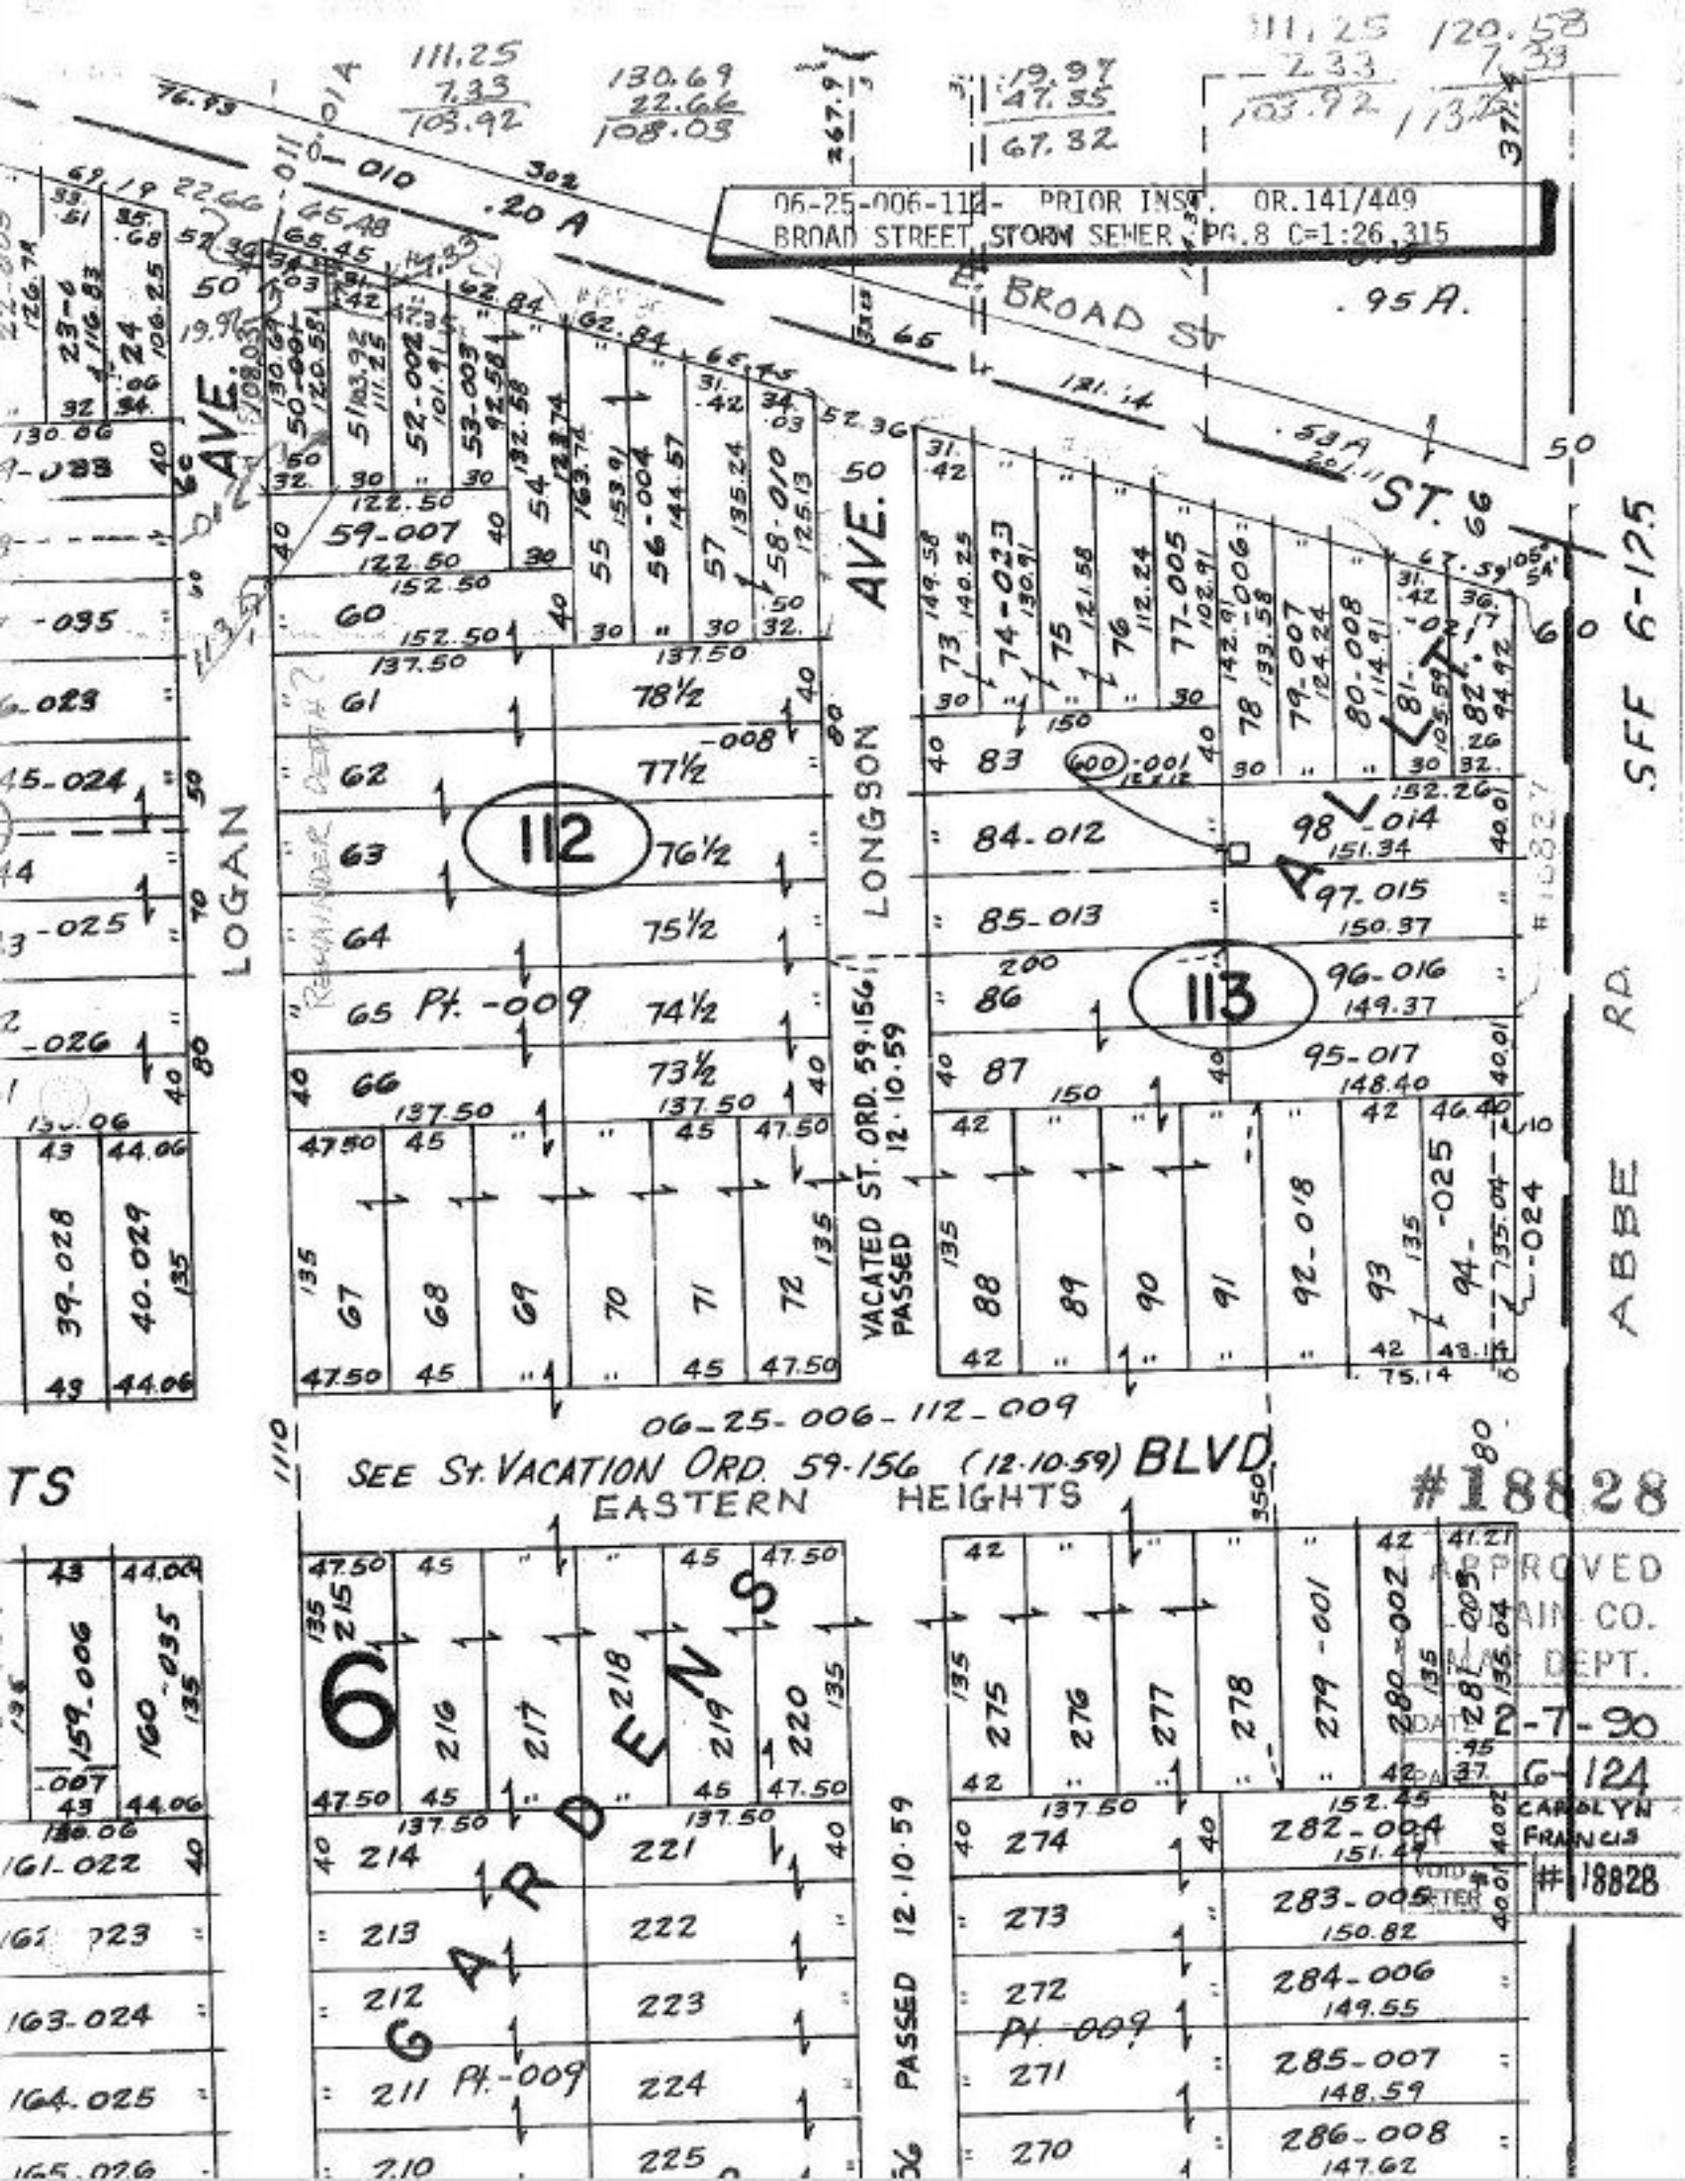
06-25-006-112- PRIOR INST. OR.141/449
BROAD STREET STORM SEWER PG.8 C=1:26,315
E. BROAD ST
.20 A
.95 A.
.53 A
LOGAN AVE.
LONGSON AVE.
ST.
ABBE RD.
112
113
VACATED ST. ORD. 59-156 PASSED 12-10-59
06-25-006-112-009
SEE ST. VACATION ORD. 59-156 (12-10-59)
EASTERN HEIGHTS BLVD.
GARDENS
PASSED 12-10-59
#18828
APPROVED
CO.
DEPT.
2-7-98
G-124
CAROLYN FRANCIS
#18828