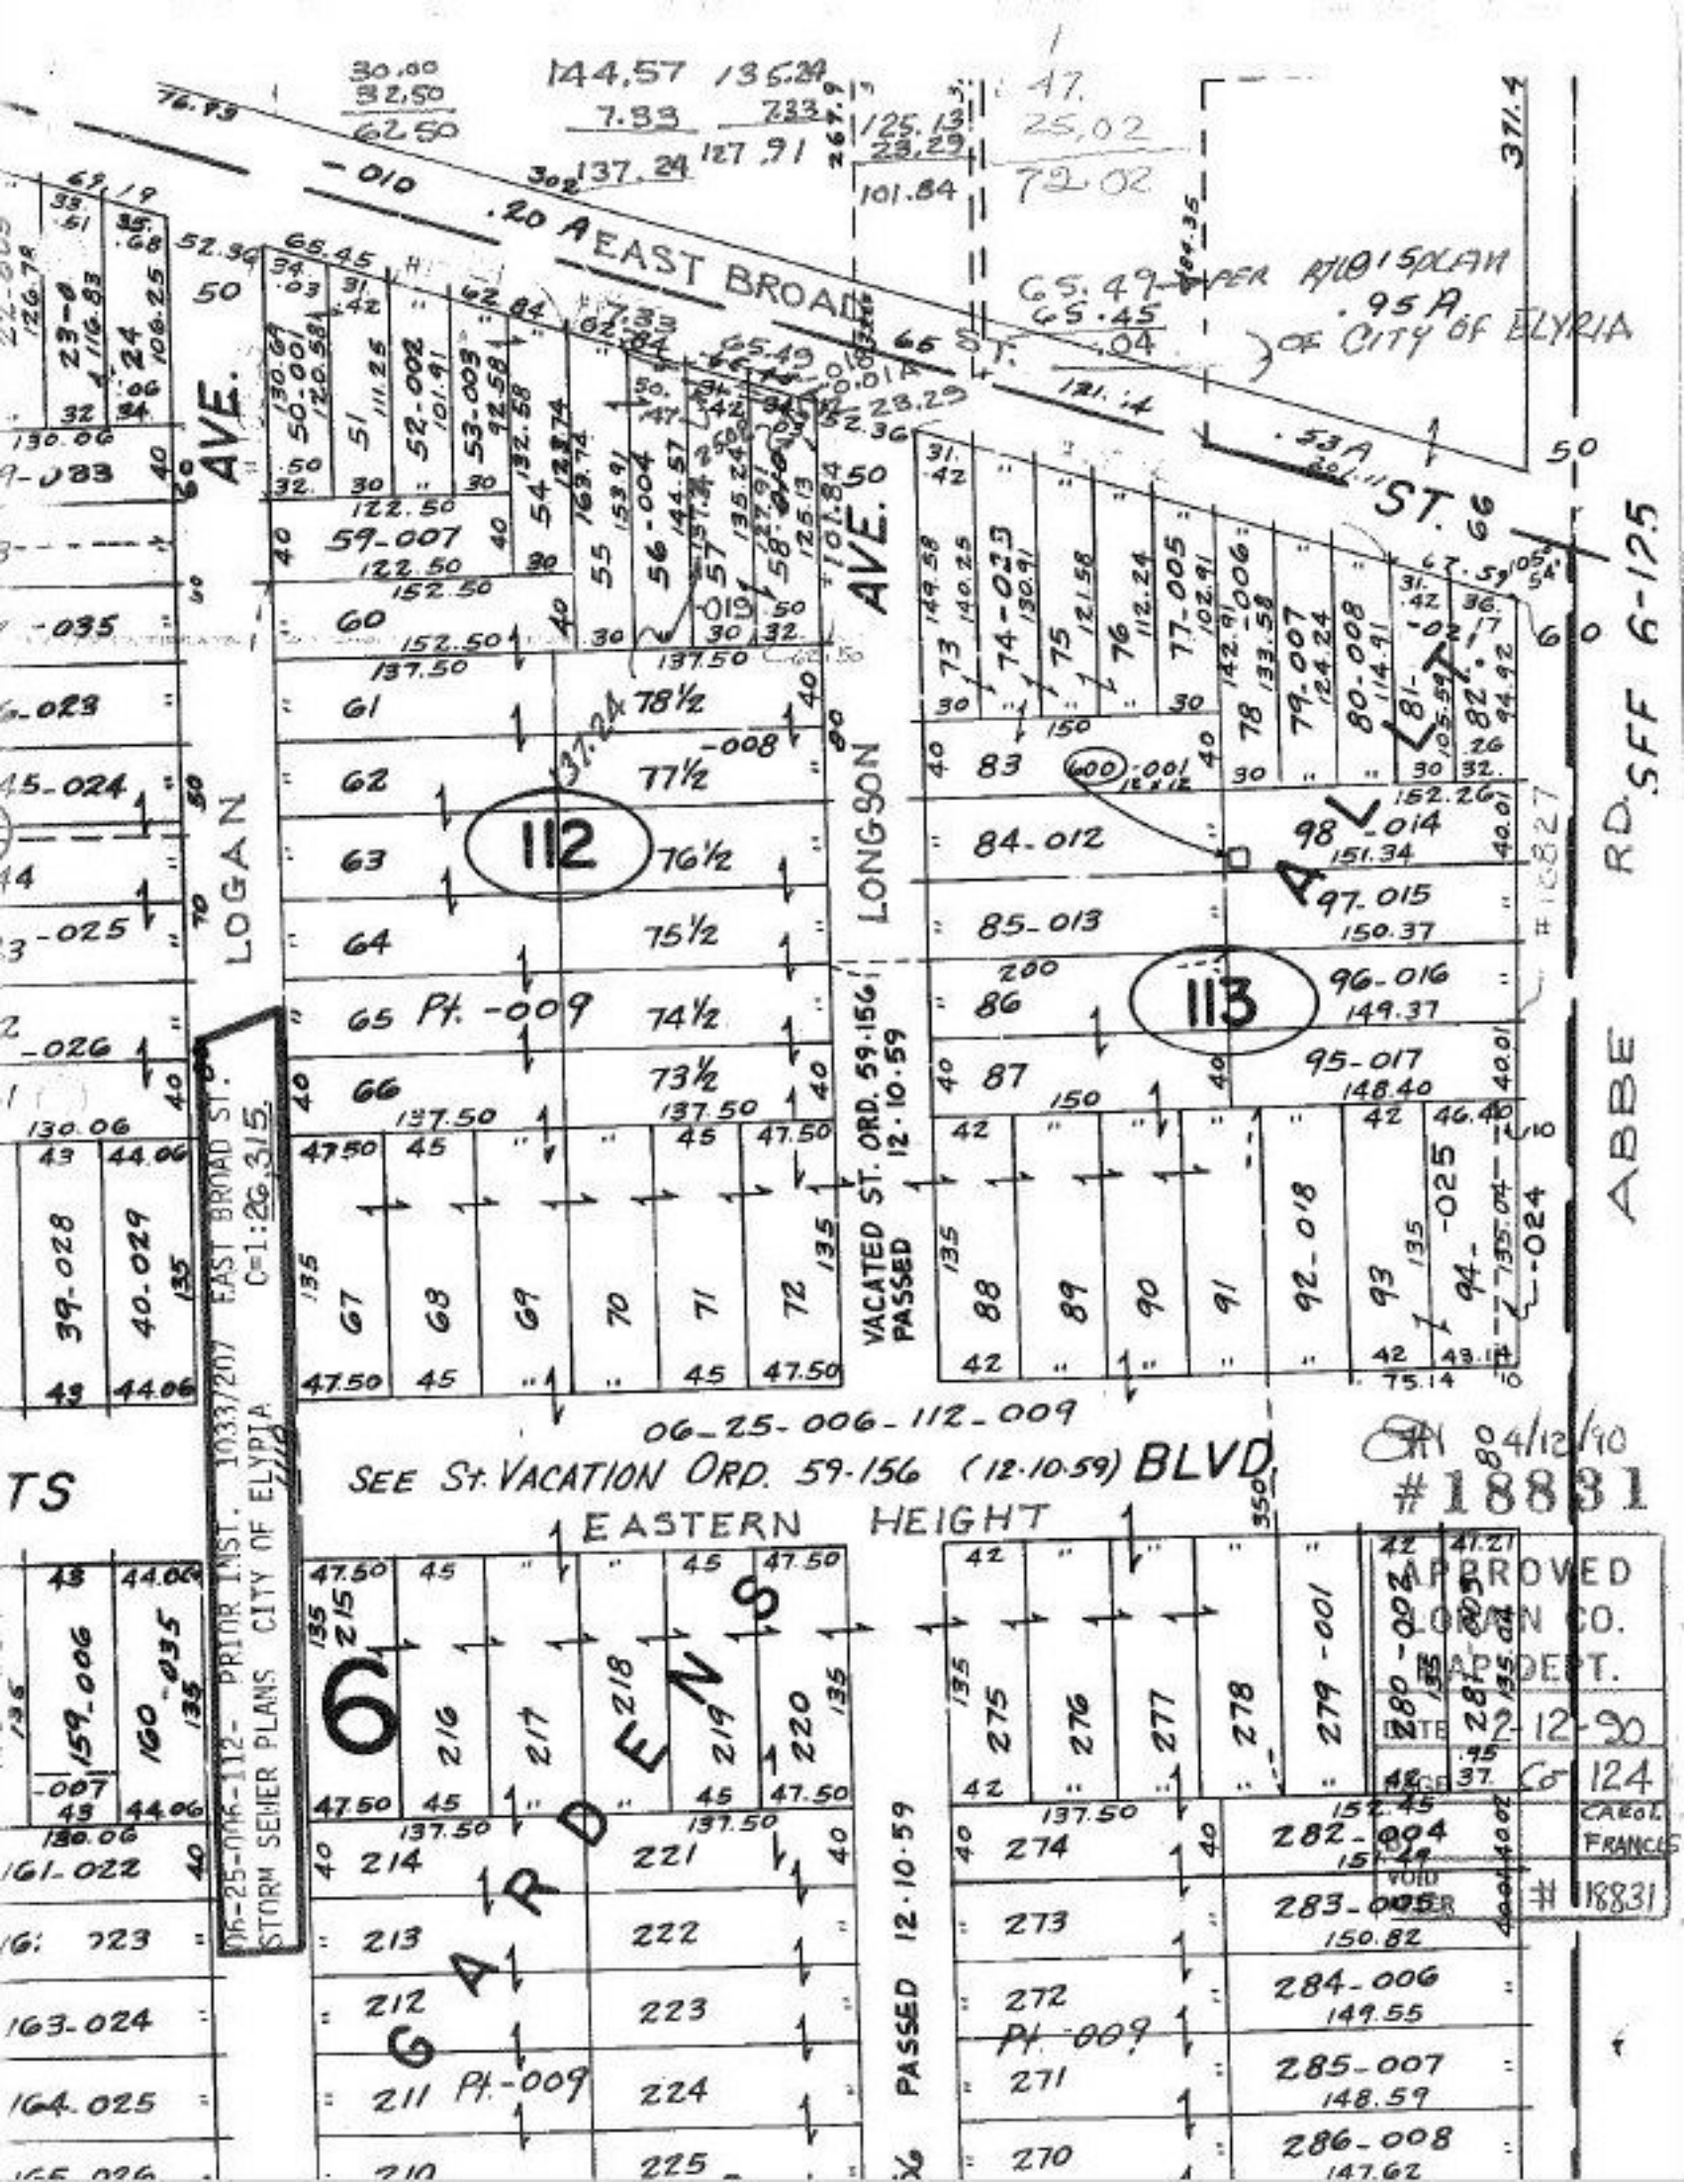
.20 A EAST BROAD ST.
.95 A
.53 A
PER PLAN OF CITY OF ELYRIA
AVE.
LOGAN
LONGSON
AVE.
ABBE
RD.
SFF 6-125
ALLEN
112
113
VACATED ST. ORD. 59-156 PASSED 12-10-59
06-25-006-112-009
SEE ST. VACATION ORD. 59-156 (12-10-59)
BLVD.
EASTERN HEIGHT
GARDENS
PASSED 12-10-59
STORM SEWER PLANS CITY OF ELYRIA
06-25-006-112- PRIOR INST. 10337/207 EAST BROAD ST.
C=1:26,315
#18827
#18831
APPROVED
LORAIN CO.
APP'DEST.
2-12-90
CAROL FRANCIS