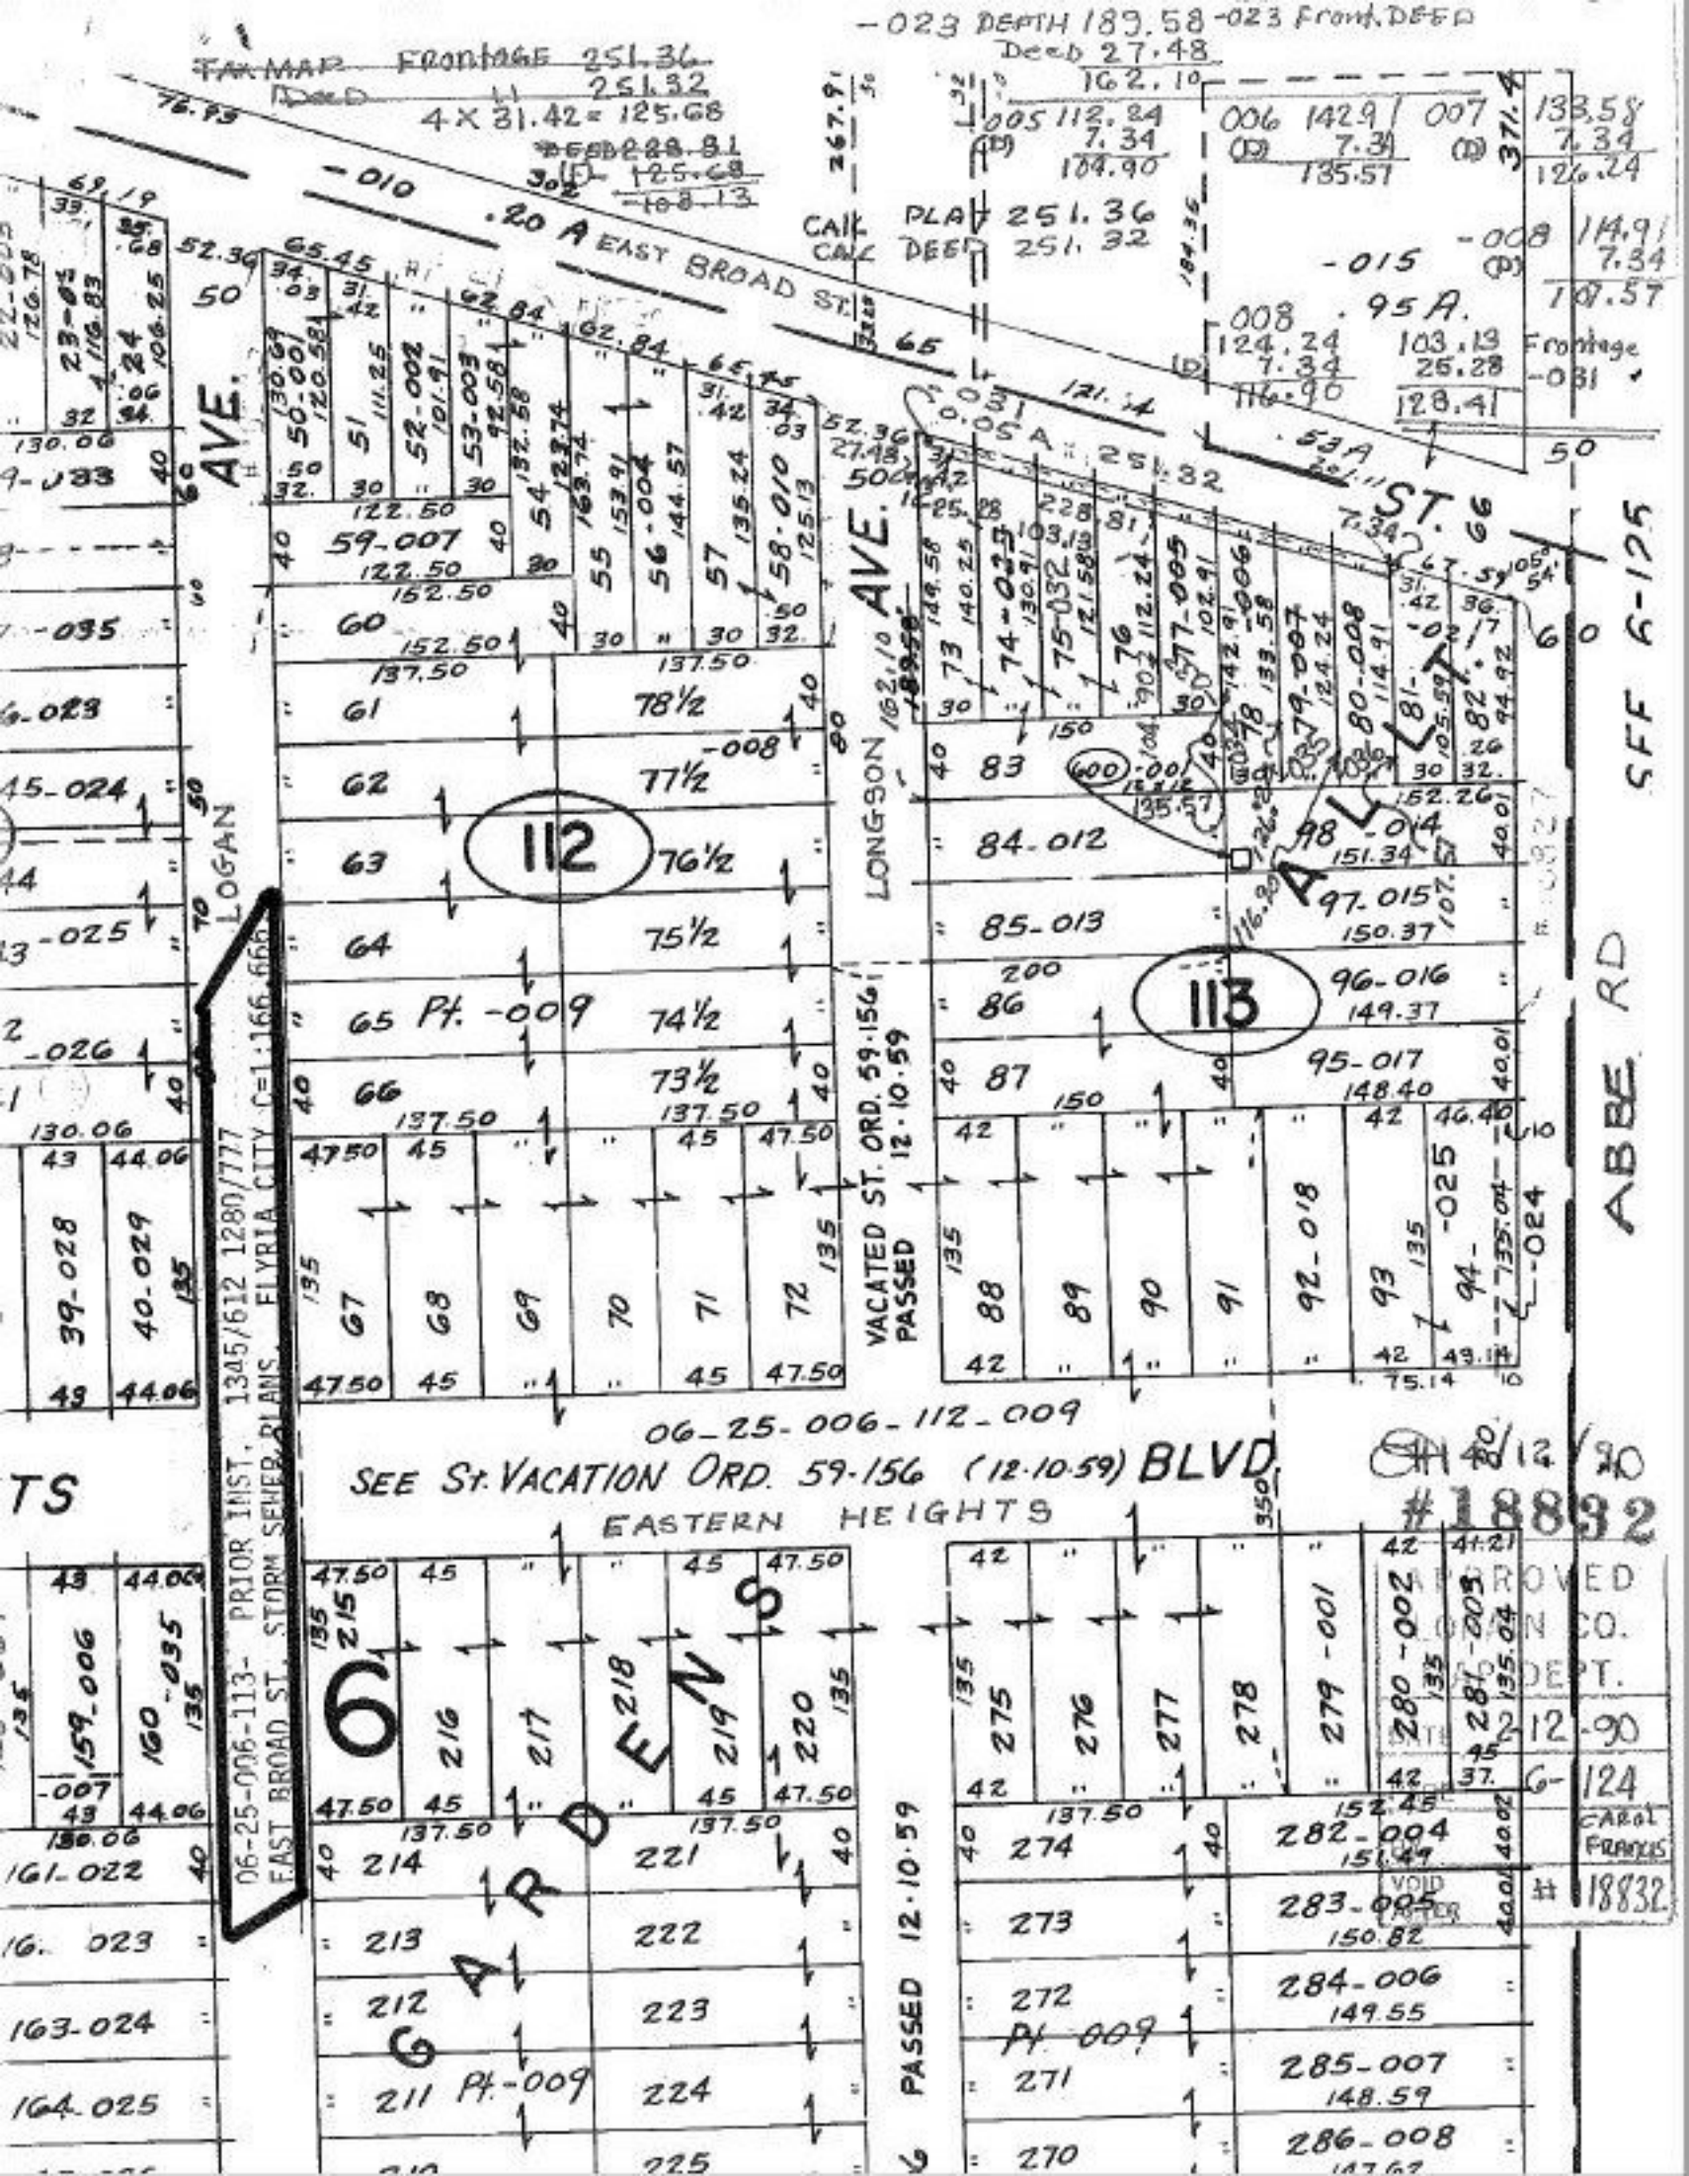

-023 DEPTH 189.58 -023 Front. DEED
Deed 27.48
162.10
TAX MAP FRONTAGE 251.36
DEED " 251.32
4 X 31.42 = 125.68
CALC PLAT 251.36
CALC DEED 251.32
.20 A EAST BROAD ST.
.95 A.
.53 A
.031
0.05 A = 251.32
ST.
AVE.
LOGAN
LONGSON
ALLT.
ABBE RD
SFF 6-125
112
113
Pt. -009
VACATED ST. ORD. 59-156 PASSED 12-10-59
06-25-006-112-009
SEE St. VACATION ORD. 59-156 (12-10-59) BLVD.
EASTERN HEIGHTS
GARDENS
6
06-25-006-113- PRIOR INST. 1345/612 1280/777
EAST BROAD ST. STORM SEWER PLANS. FLYRIA CITY C=1:166.666
PASSED 12-10-59
#18832
APPROVED
LOGAN CO.
DEPT.
2-12-90
6-124
CAROL FRANCIS
VOID
#18832