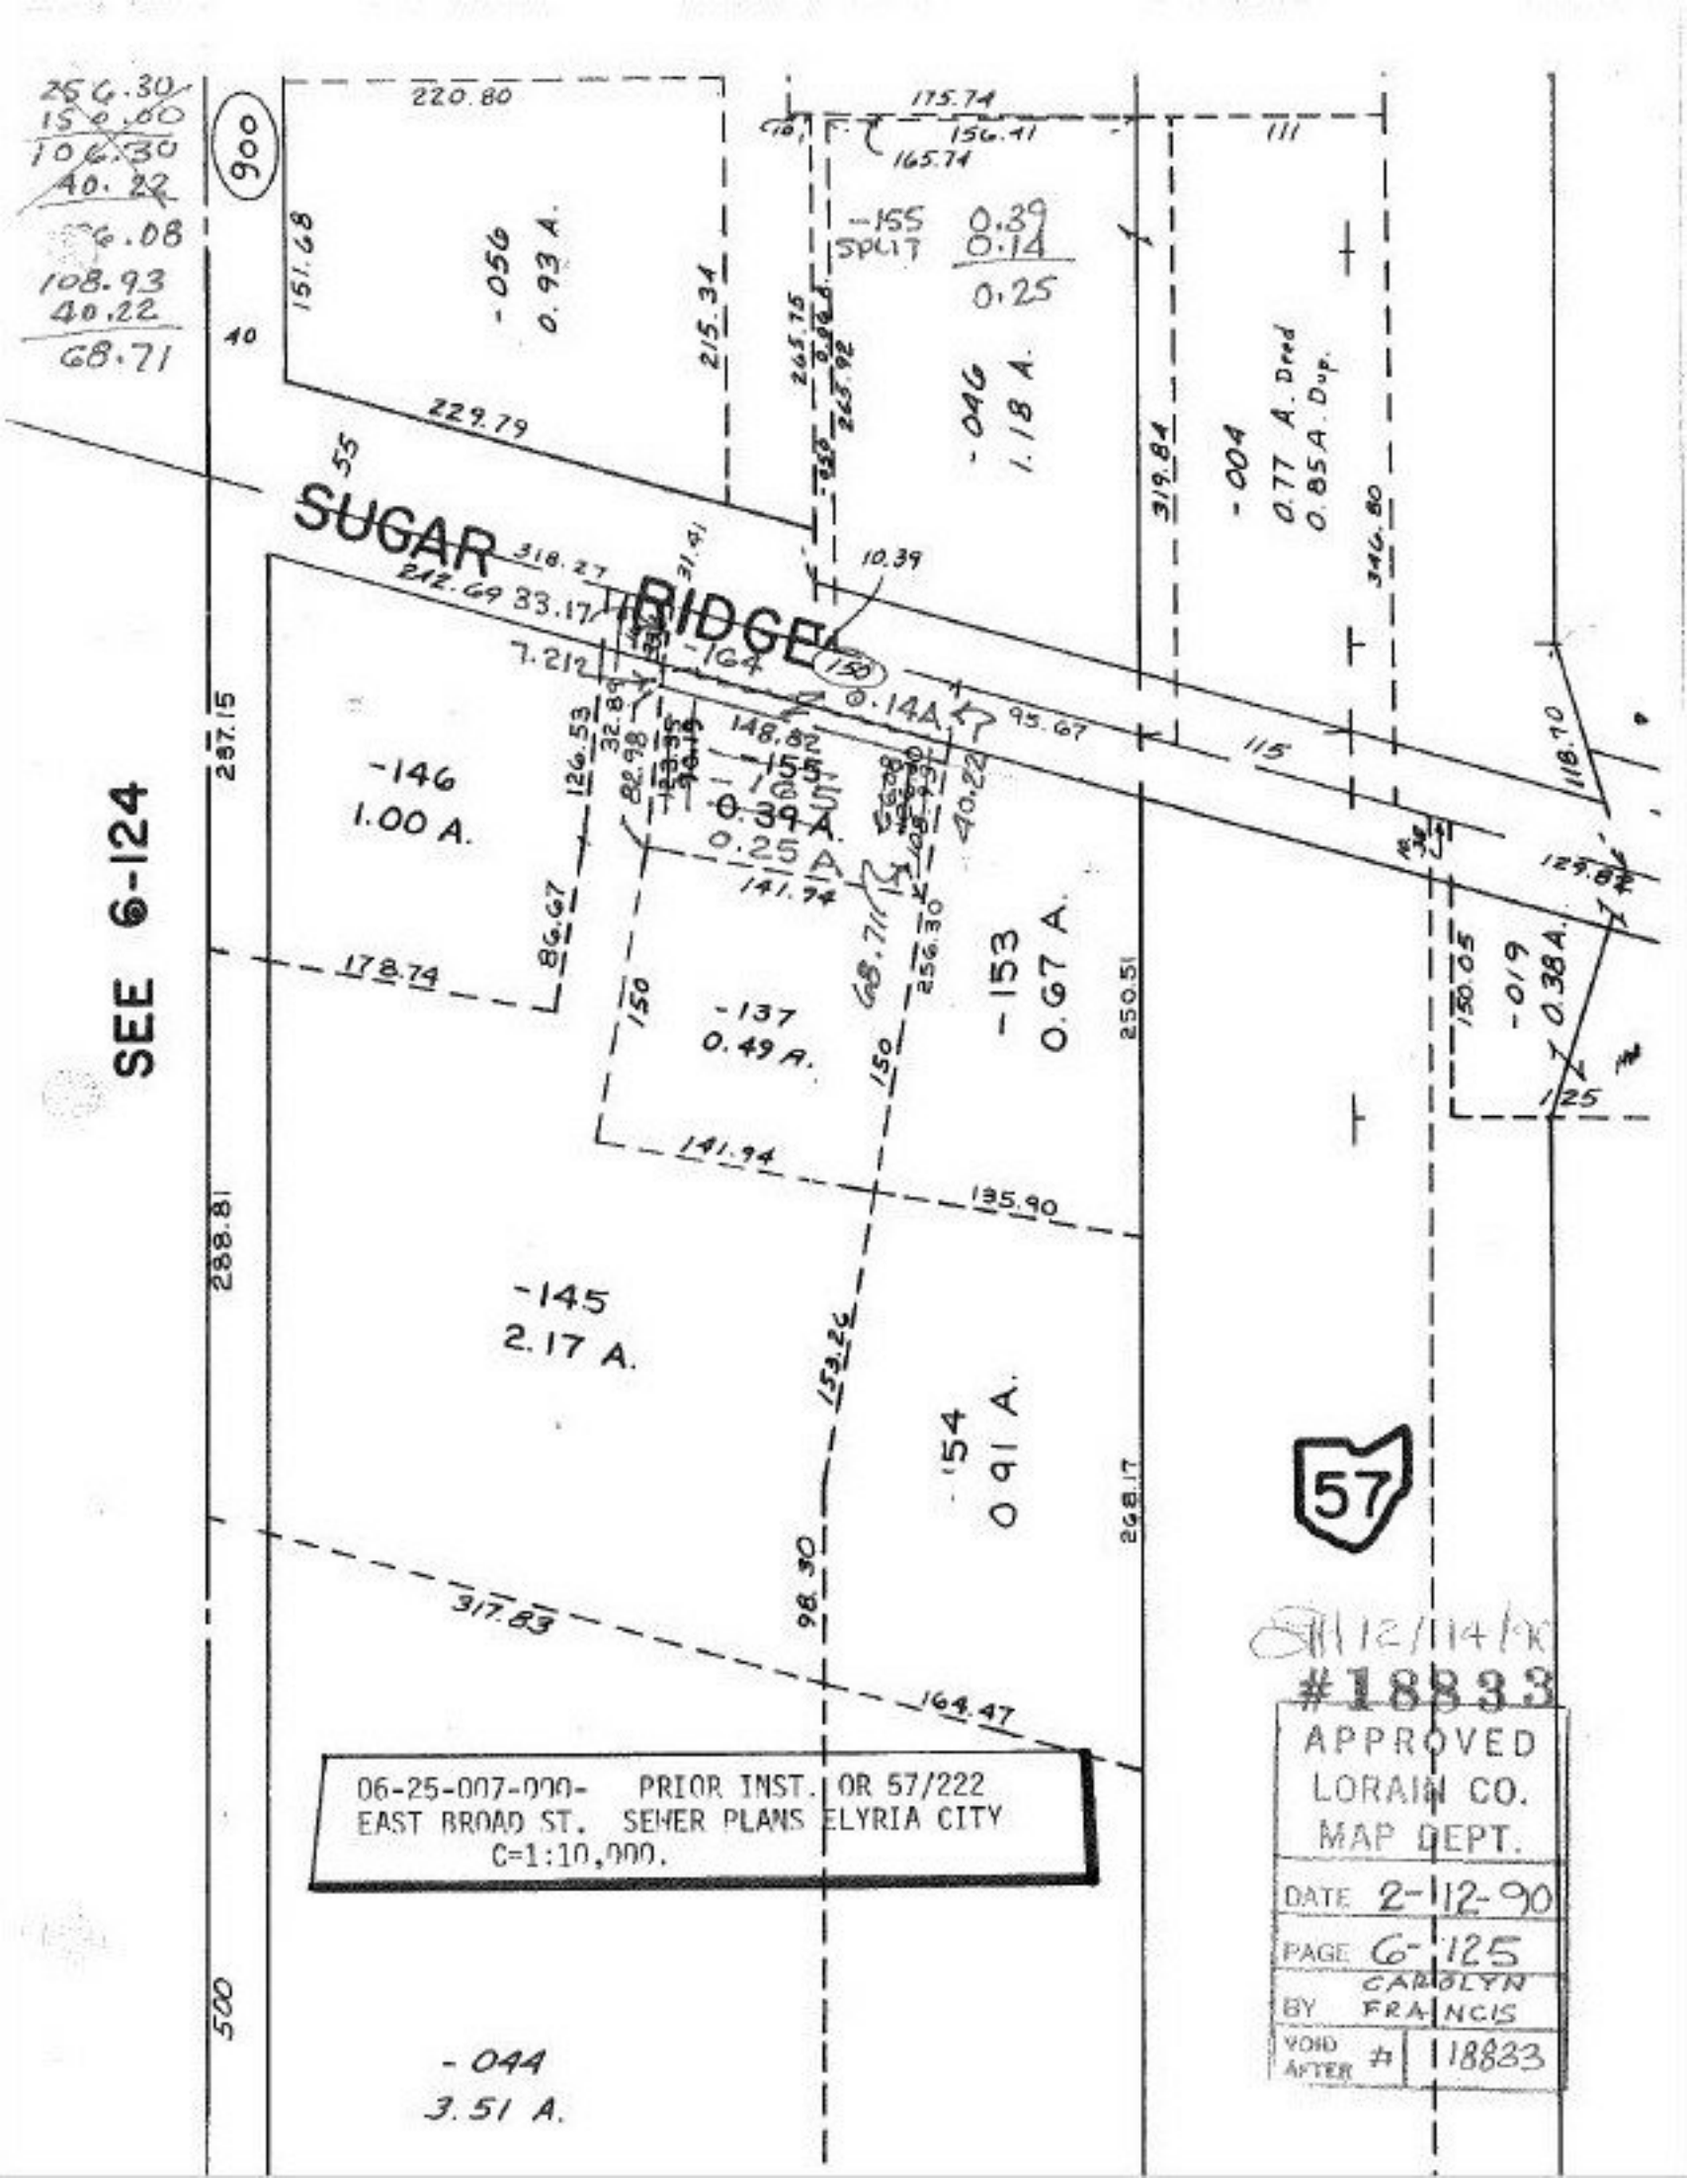
SUGAR RIDGE
SEE 6-124
-056
0.93 A.
-046
1.18 A.
-004
0.77 A. Dred
0.85A. Dup.
-164
0.14A.
-155
0.39
0.25
-146
1.00 A.
-137
0.49 A.
-153
0.67 A.
-019
0.38A.
-145
2.17 A.
-154
0.91 A.
-044
3.51 A.
57
06-25-007-000- PRIOR INST. OR 57/222
EAST BROAD ST. SEWER PLANS ELYRIA CITY
C=1:10,000.
12/14/90
#18833
APPROVED
LORAIN CO.
MAP DEPT.
DATE 2-12-90
PAGE 6-125
BY CAROLYN FRANCIS
VOID AFTER # 18833