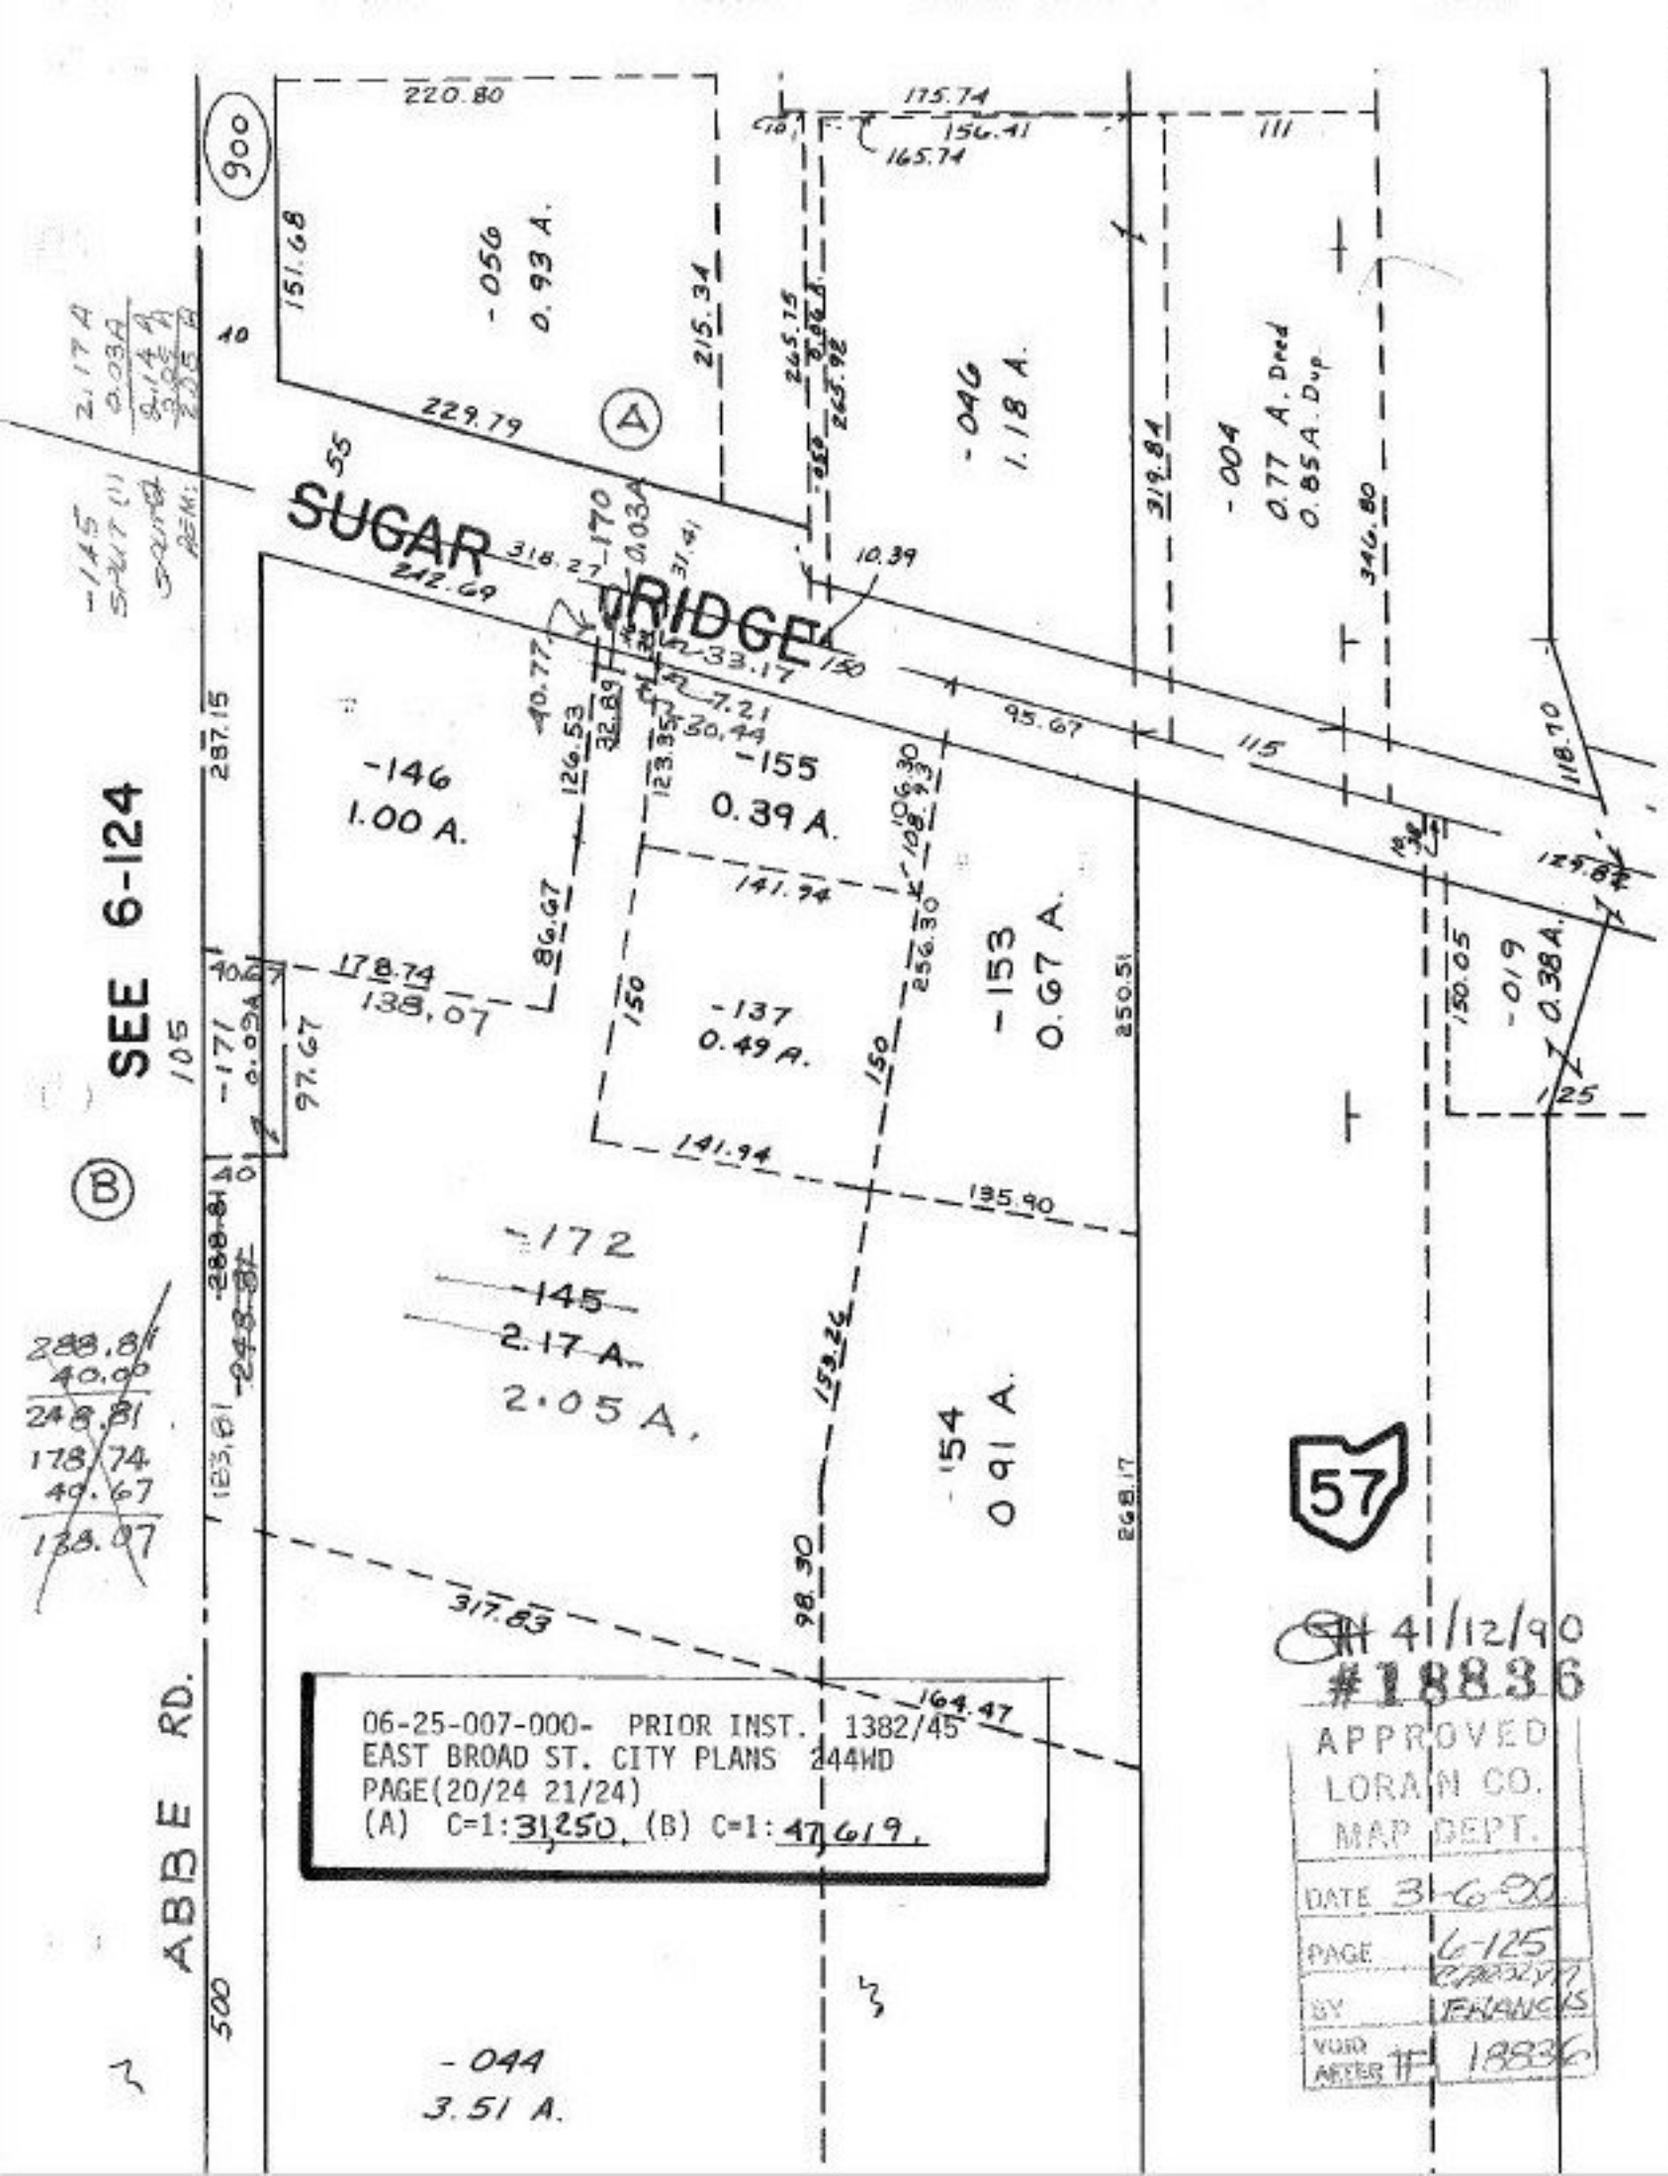
SUGAR RIDGE
SEE 6-124
ABBE RD.
900
500
105
-056
0.93 A.
-046
1.18 A.
-004
0.77 A. Dred
0.85 A. Dup.
-146
1.00 A.
-155
0.39 A.
-153
0.67 A.
-137
0.49 A.
-019
0.38 A.
-172
-145
2.17 A.
2.05 A.
-154
0.91 A.
-044
3.51 A.
-171
0.09 A.
57
220.80
151.68
215.34
229.79
319.84
346.80
287.15
242.69
318.27
95.67
118.70
125.87
141.94
135.90
317.63
164.47
268.17
250.51
06-25-007-000- PRIOR INST. 1382/45
EAST BROAD ST. CITY PLANS 244WD
PAGE(20/24 21/24)
(A) C=1: 31,250. (B) C=1: 47,619.
APPROVED
LORAIN CO.
MAP DEPT.
DATE 3-6-92
PAGE 6-125
BY JFRANCIS
VOID AFTER 11
#18836
4/12/90
#18836