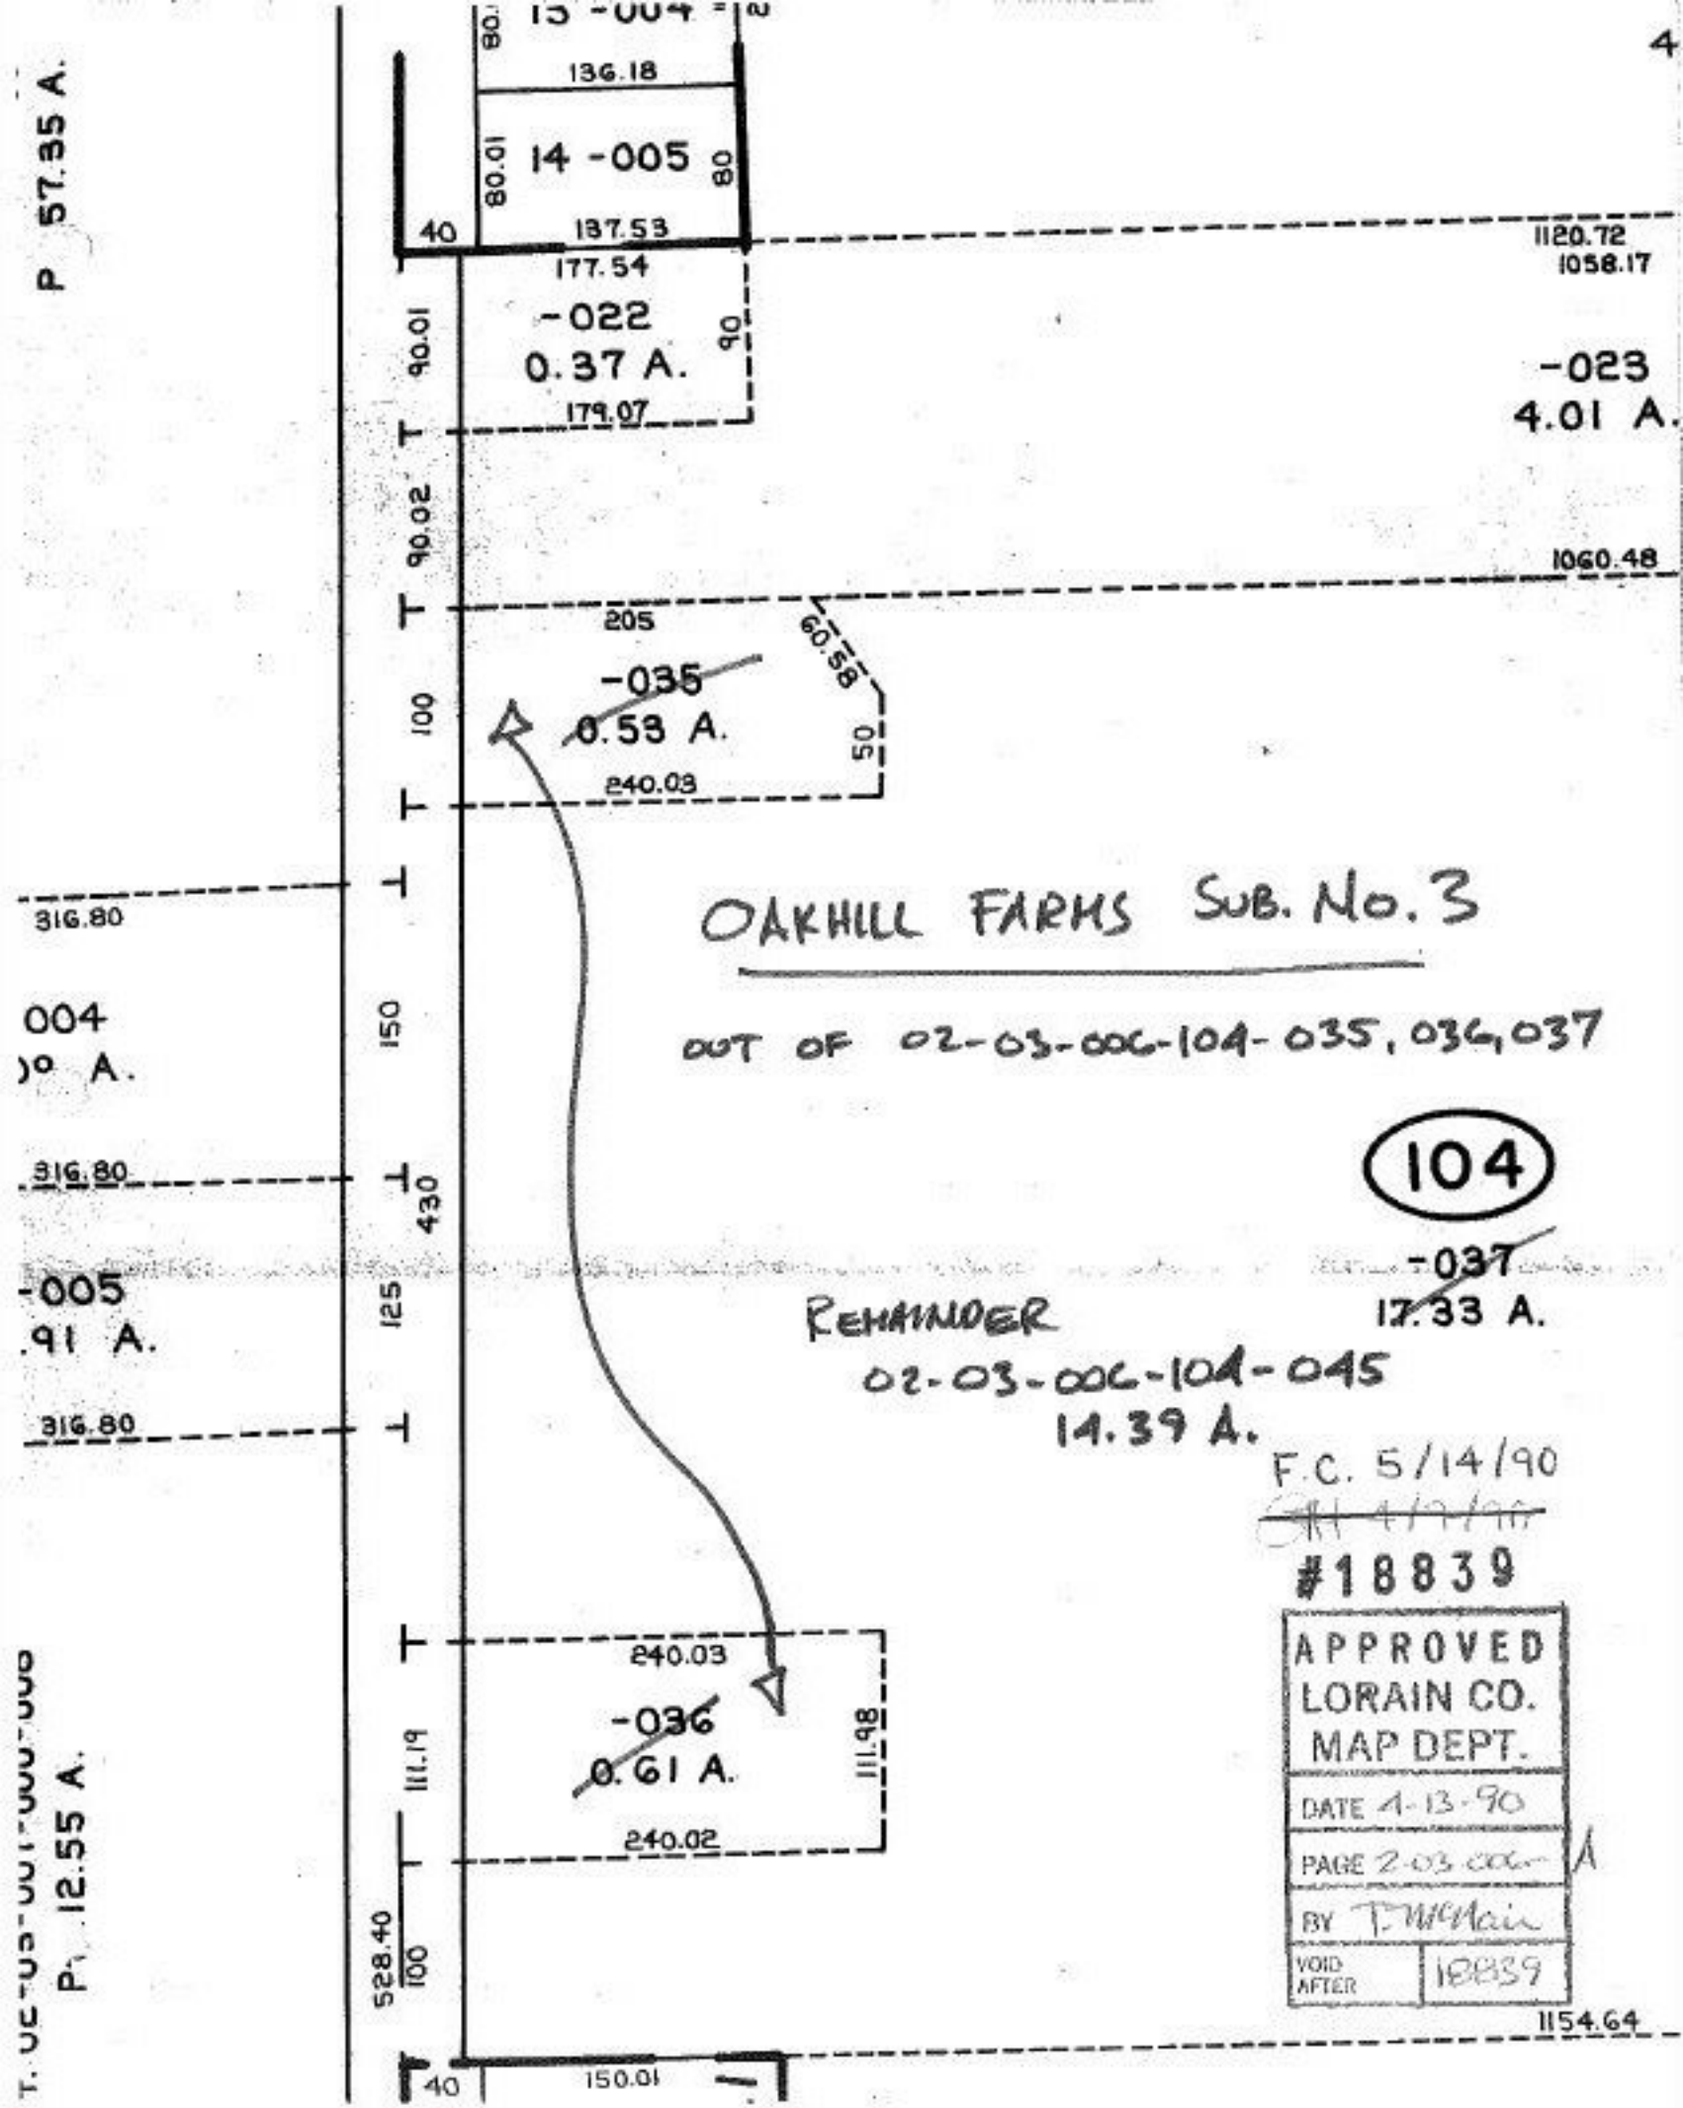
P 57.35 A.
13 -004
136.18
14 -005
80.01
80
40
187.53
177.54
1120.72
1058.17
-022
0.37 A.
179.07
90.01
90
-023
4.01 A.
90.02
1060.48
205
-035
0.53 A.
60.58
85.09
100
50
240.03
316.80
OAKHILL FARMS SUB. No. 3
OUT OF 02-03-00C-104-035, 036, 037
004
)0 A.
150
316.80
104
-037
17.33 A.
430
-005
.91 A.
125
REMAINDER
02-03-00C-104-045
14.39 A.
316.80
F.C. 5/14/90
#18839
APPROVED
LORAIN CO.
MAP DEPT.
DATE 1-13-90
PAGE 2-03 00C
BY T. McMain
VOID AFTER 18839
240.03
-036
0.61 A.
111.98
111.19
240.02
528.40
100
P 12.55 A.
1154.64
40
150.01