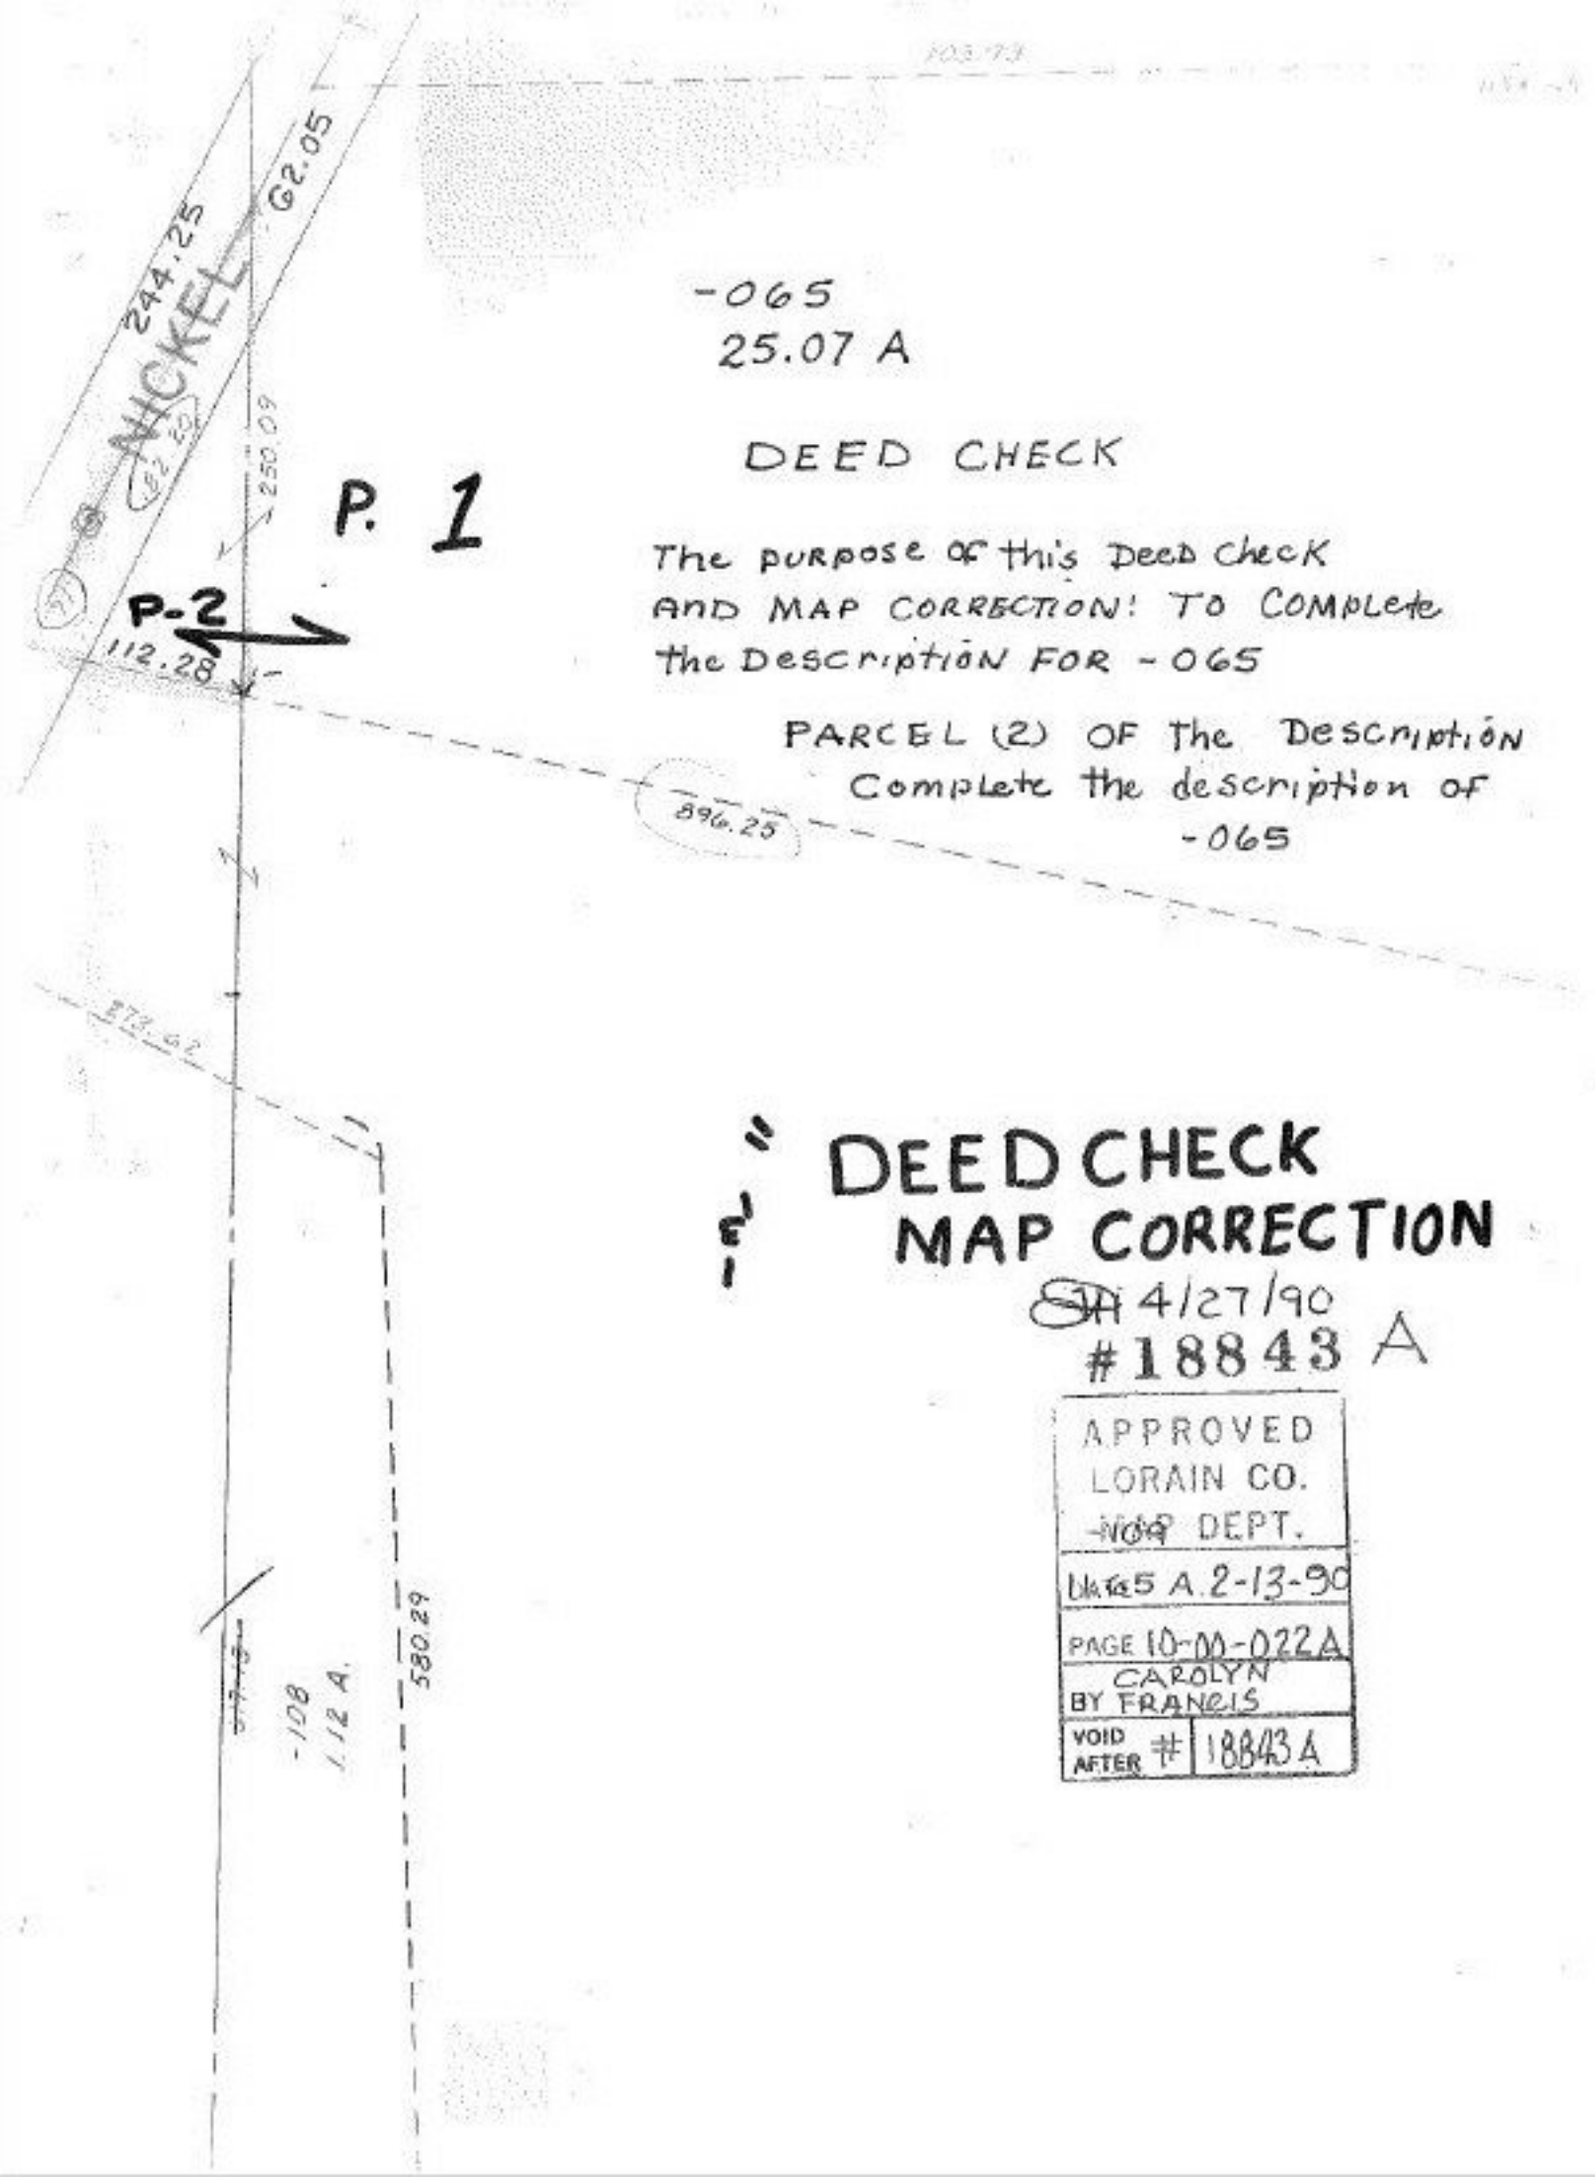
-065
25.07 A
DEED CHECK
The purpose of this Deed Check
AND MAP CORRECTION! TO Complete
the Description FOR -065
PARCEL (2) OF The Description
Complete the description of
-065
P. 1
P-2
112.28
244.25
62.05
NICKEL
250.09
896.25
580.29
-108
1.12 A.
DEED CHECK
MAP CORRECTION
4/27/90
#18843 A
APPROVED
LORAIN CO.
MAP DEPT.
Maps A 2-13-90
PAGE 10-00-022A
CAROLYN
BY FRANCIS
VOID
AFTER # 18843A