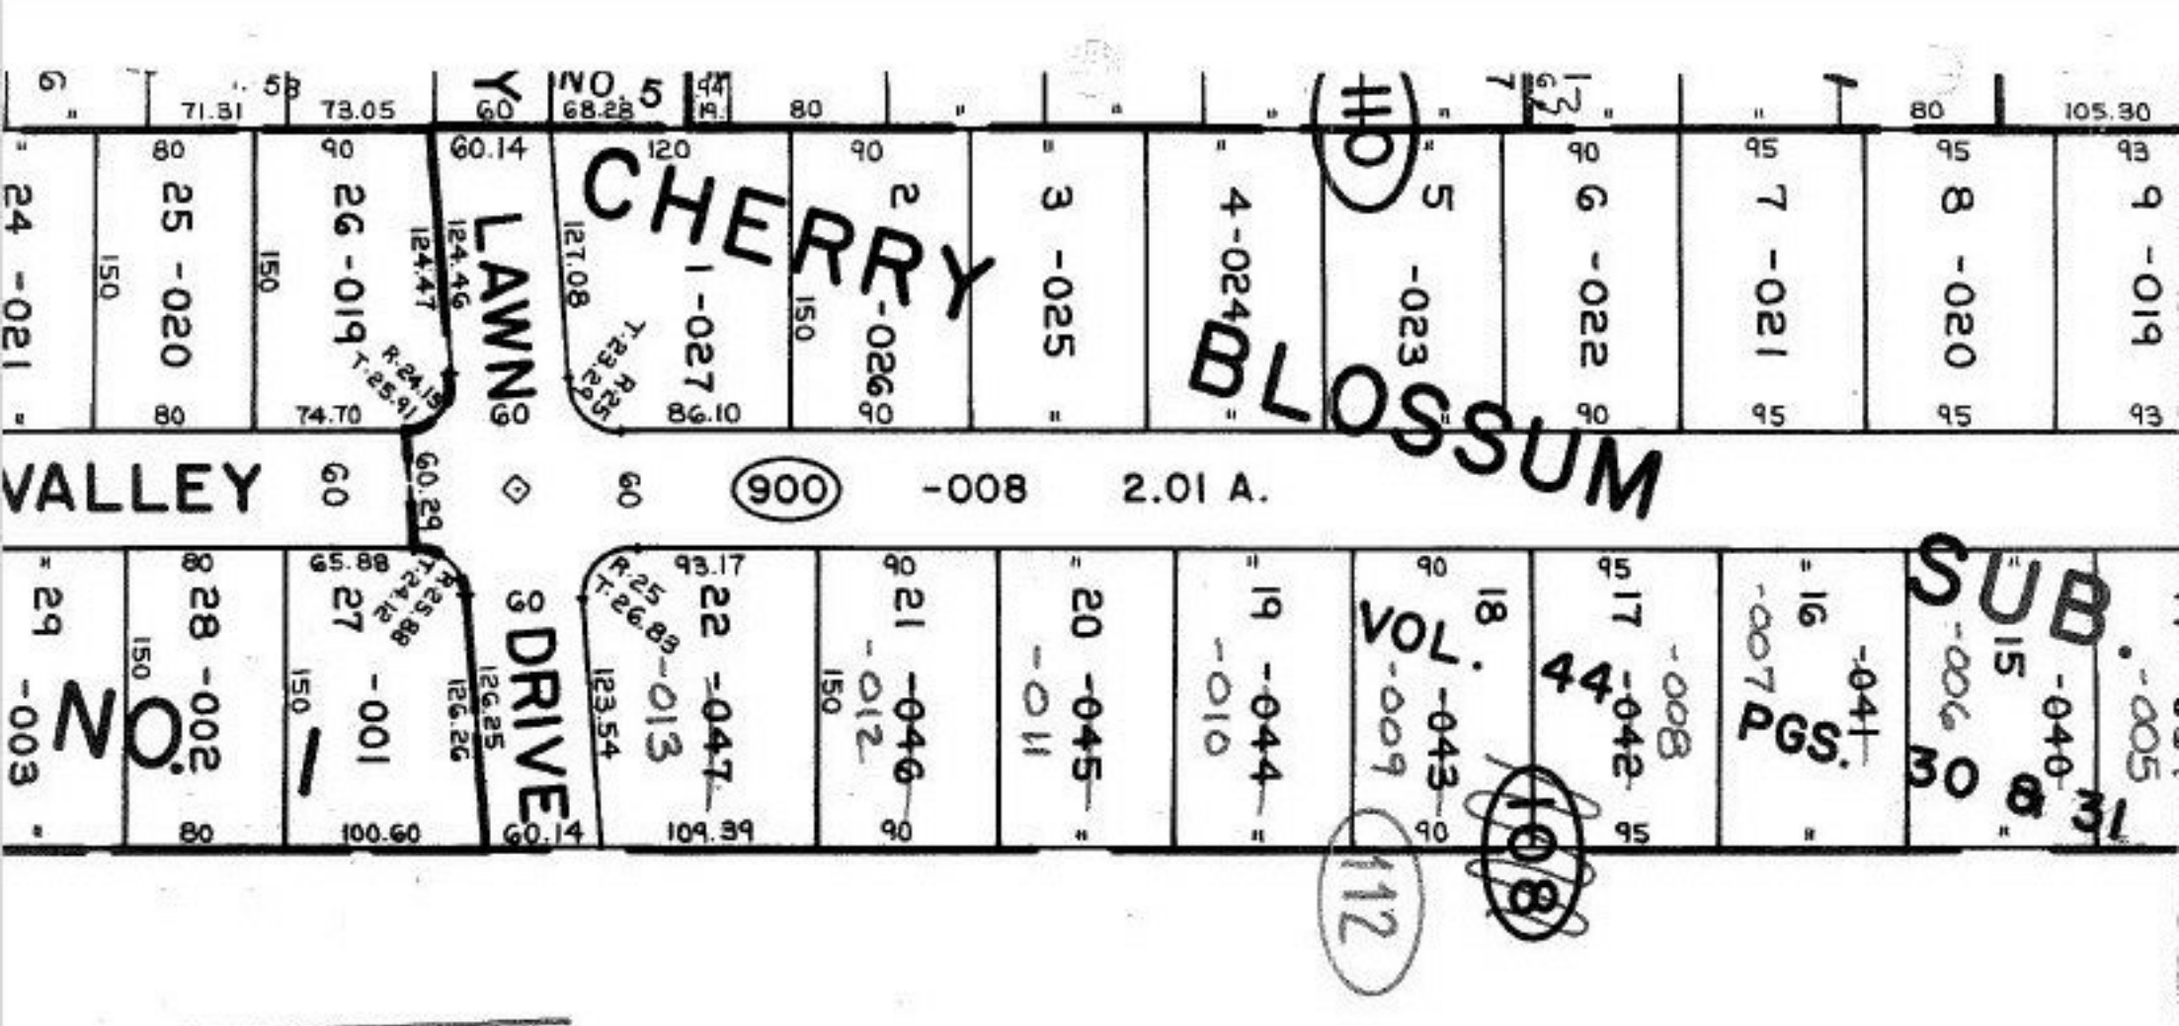
CHERRY BLOSSUM
VALLEY
NO. 1
DRIVE
SUB.
VOL. 44 PGS. 30 & 31
900
-008 2.01 A.
-048
15.19 A.
2092.50
108
112
PARCEL/ BLOCK NO. CORRECTION
#18844
5/15/90
#18844-A
APPROVED LORAIN CO. MAP DEPT.
DATE 2-21-90
PARCEL NO. 057-B
BY TMW