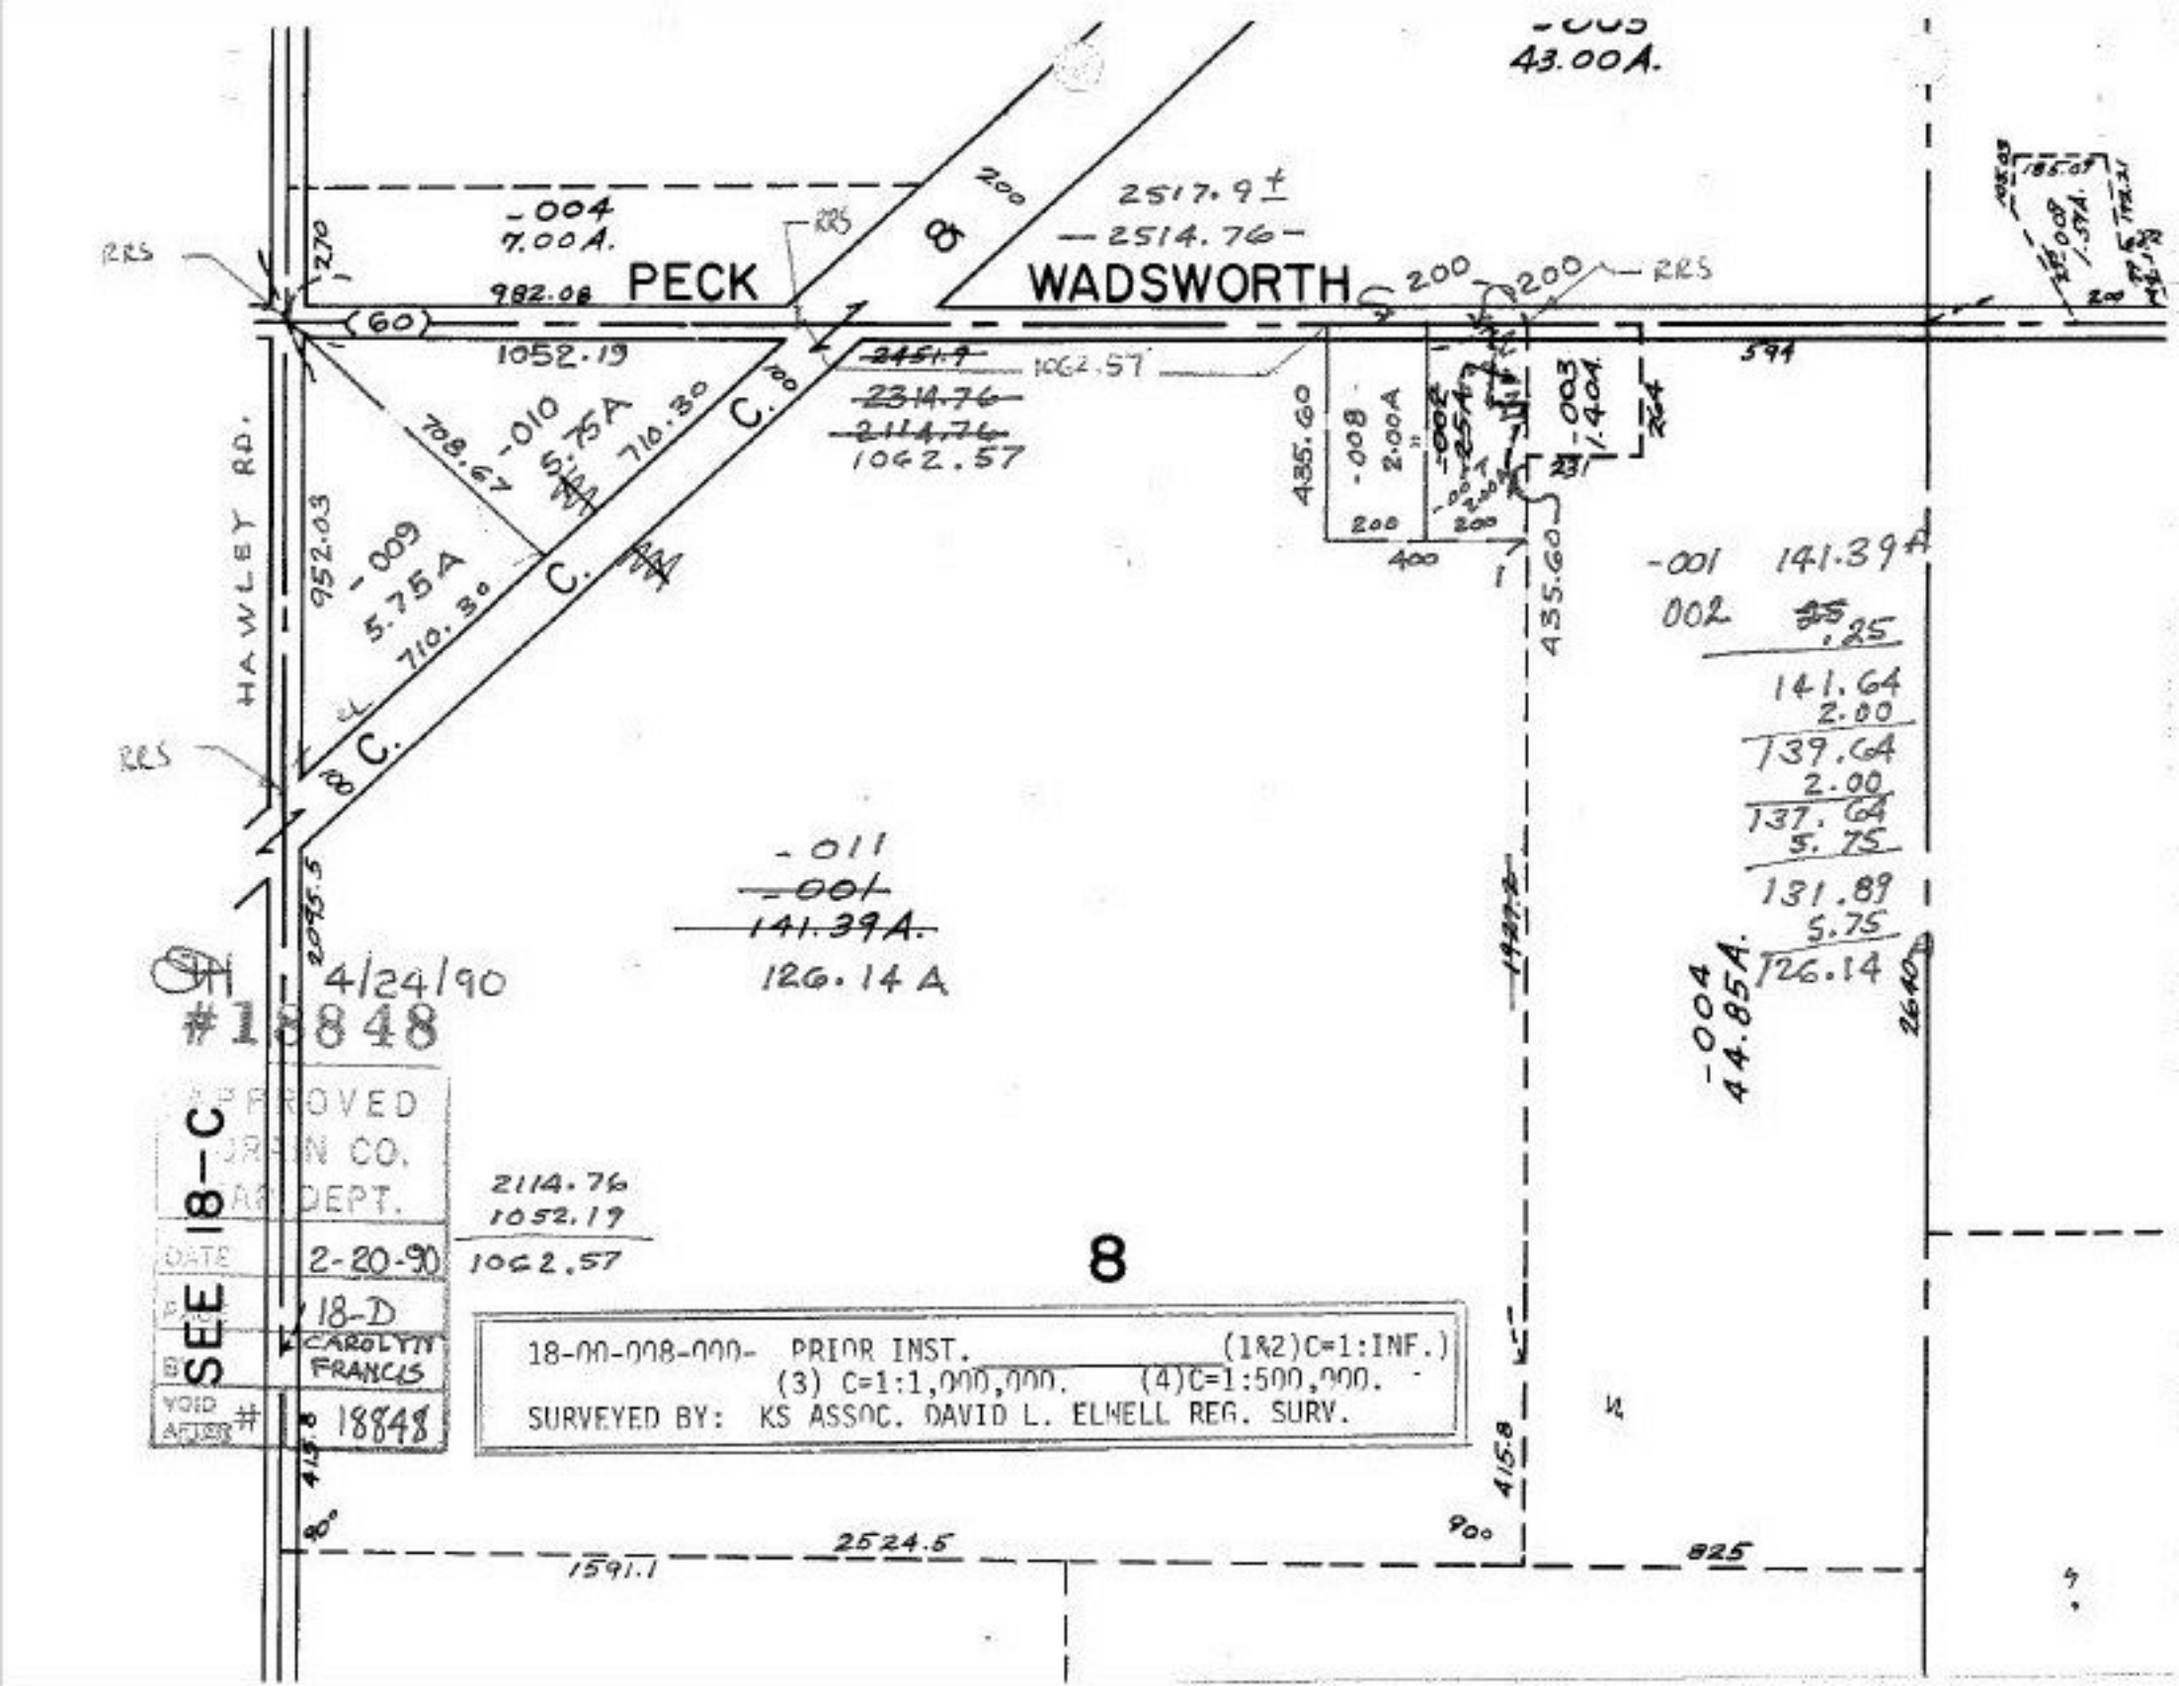
-003
43.00A.
-004
7.00A.
982.08
PECK
WADSWORTH
2517.9±
2514.76
1052.19
1062.57
2451.9
2314.76
2114.76
1062.57
-010
5.75A
710.30
708.67
-009
5.75A
710.30
952.03
HAWLEY RD.
RRS
C.
C.
C.
60
200
200
591
435.60
-008
2.00A
200
400
-002
-003
1.40A.
224
435.60
-001 141.39A
002 .25
141.64
2.00
139.64
2.00
137.64
5.75
131.89
5.75
126.14
-004
44.85A.
2640
-011
-001
141.39A.
126.14 A
2075.5
1927.2
415.8
90°
2524.5
1591.1
825
4/24/90
#18848
SEE 18-C
APPROVED
COUNTY CO.
ASSR DEPT.
DATE 2-20-90
BY CAROLYN FRANCIS
VOID AFTER # 18848
2114.76
1052.19
1062.57
8
18-00-008-000- PRIOR INST. (1&2)C=1:INF.)
(3) C=1:1,000,000. (4)C=1:500,000.
SURVEYED BY: KS ASSOC. DAVID L. ELNELL REG. SURV.