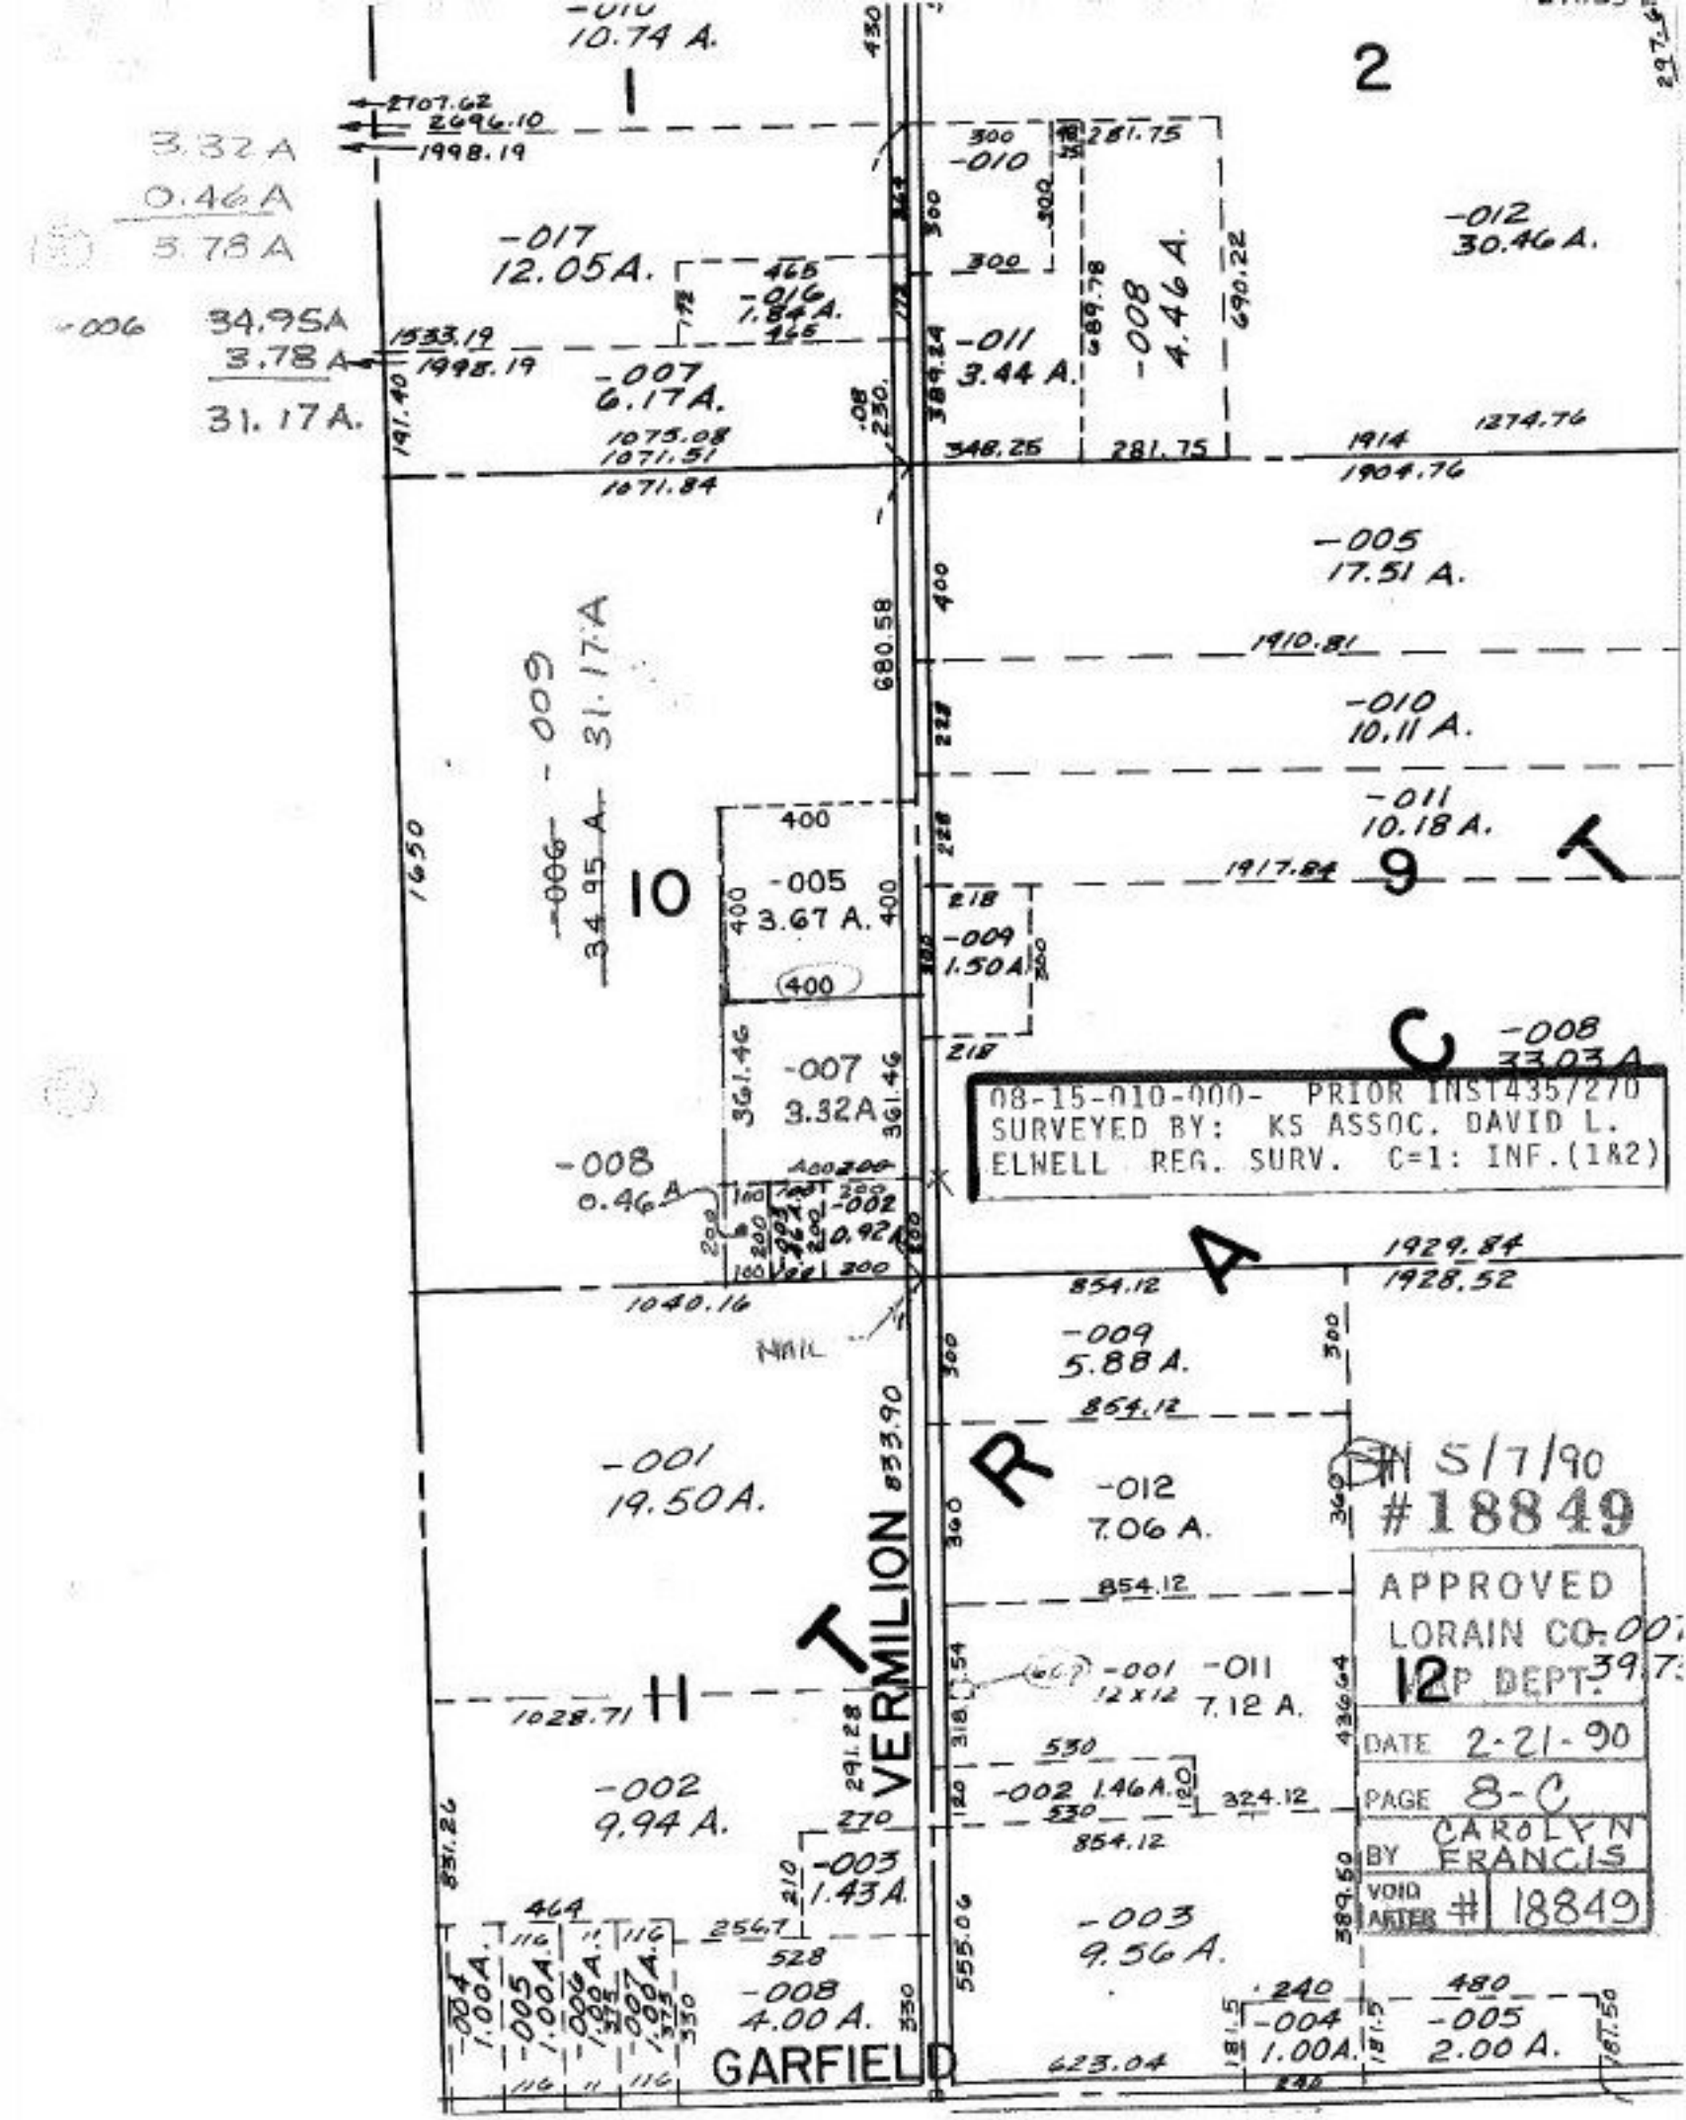
10.74 A.
1
2
3.32 A
0.46 A
5.78 A
34.95A
3.78 A
31.17A.
-017
12.05A.
-016
1.84A.
-007
6.17A.
-010
-011
3.44 A.
-008
4.46 A.
-012
30.46 A.
-005
17.51 A.
-010
10.11 A.
-011
10.18 A.
-008
33.03 A
-009
31.17A
-006
34.95 A
10
-005
3.67 A.
-009
1.50A
-007
3.32A
-008
0.46A
-002
0.92A
08-15-010-000- PRIOR INST435/270
SURVEYED BY: KS ASSOC. DAVID L.
ELWELL REG. SURV. C=1: INF.(1&2)
-009
5.88 A.
-012
7.06 A.
-001
19.50A.
-001 -011
12x12 7.12 A.
-002
9.94 A.
-002 1.46A.
-003
1.43A.
-003
9.56 A.
-004
1.00A.
-005
1.00A.
-006
1.00A.
-007
1.00A.
-008
4.00 A.
-004
1.00A.
-005
2.00 A.
VERMILION
GARFIELD
NAIL
RECEIVED 5/7/90
#18849
APPROVED
LORAIN CO. 007
MAP DEPT. 39.7
12
DATE 2-21-90
PAGE 8-C
BY CAROLYN FRANCIS
VOID AFTER # 18849