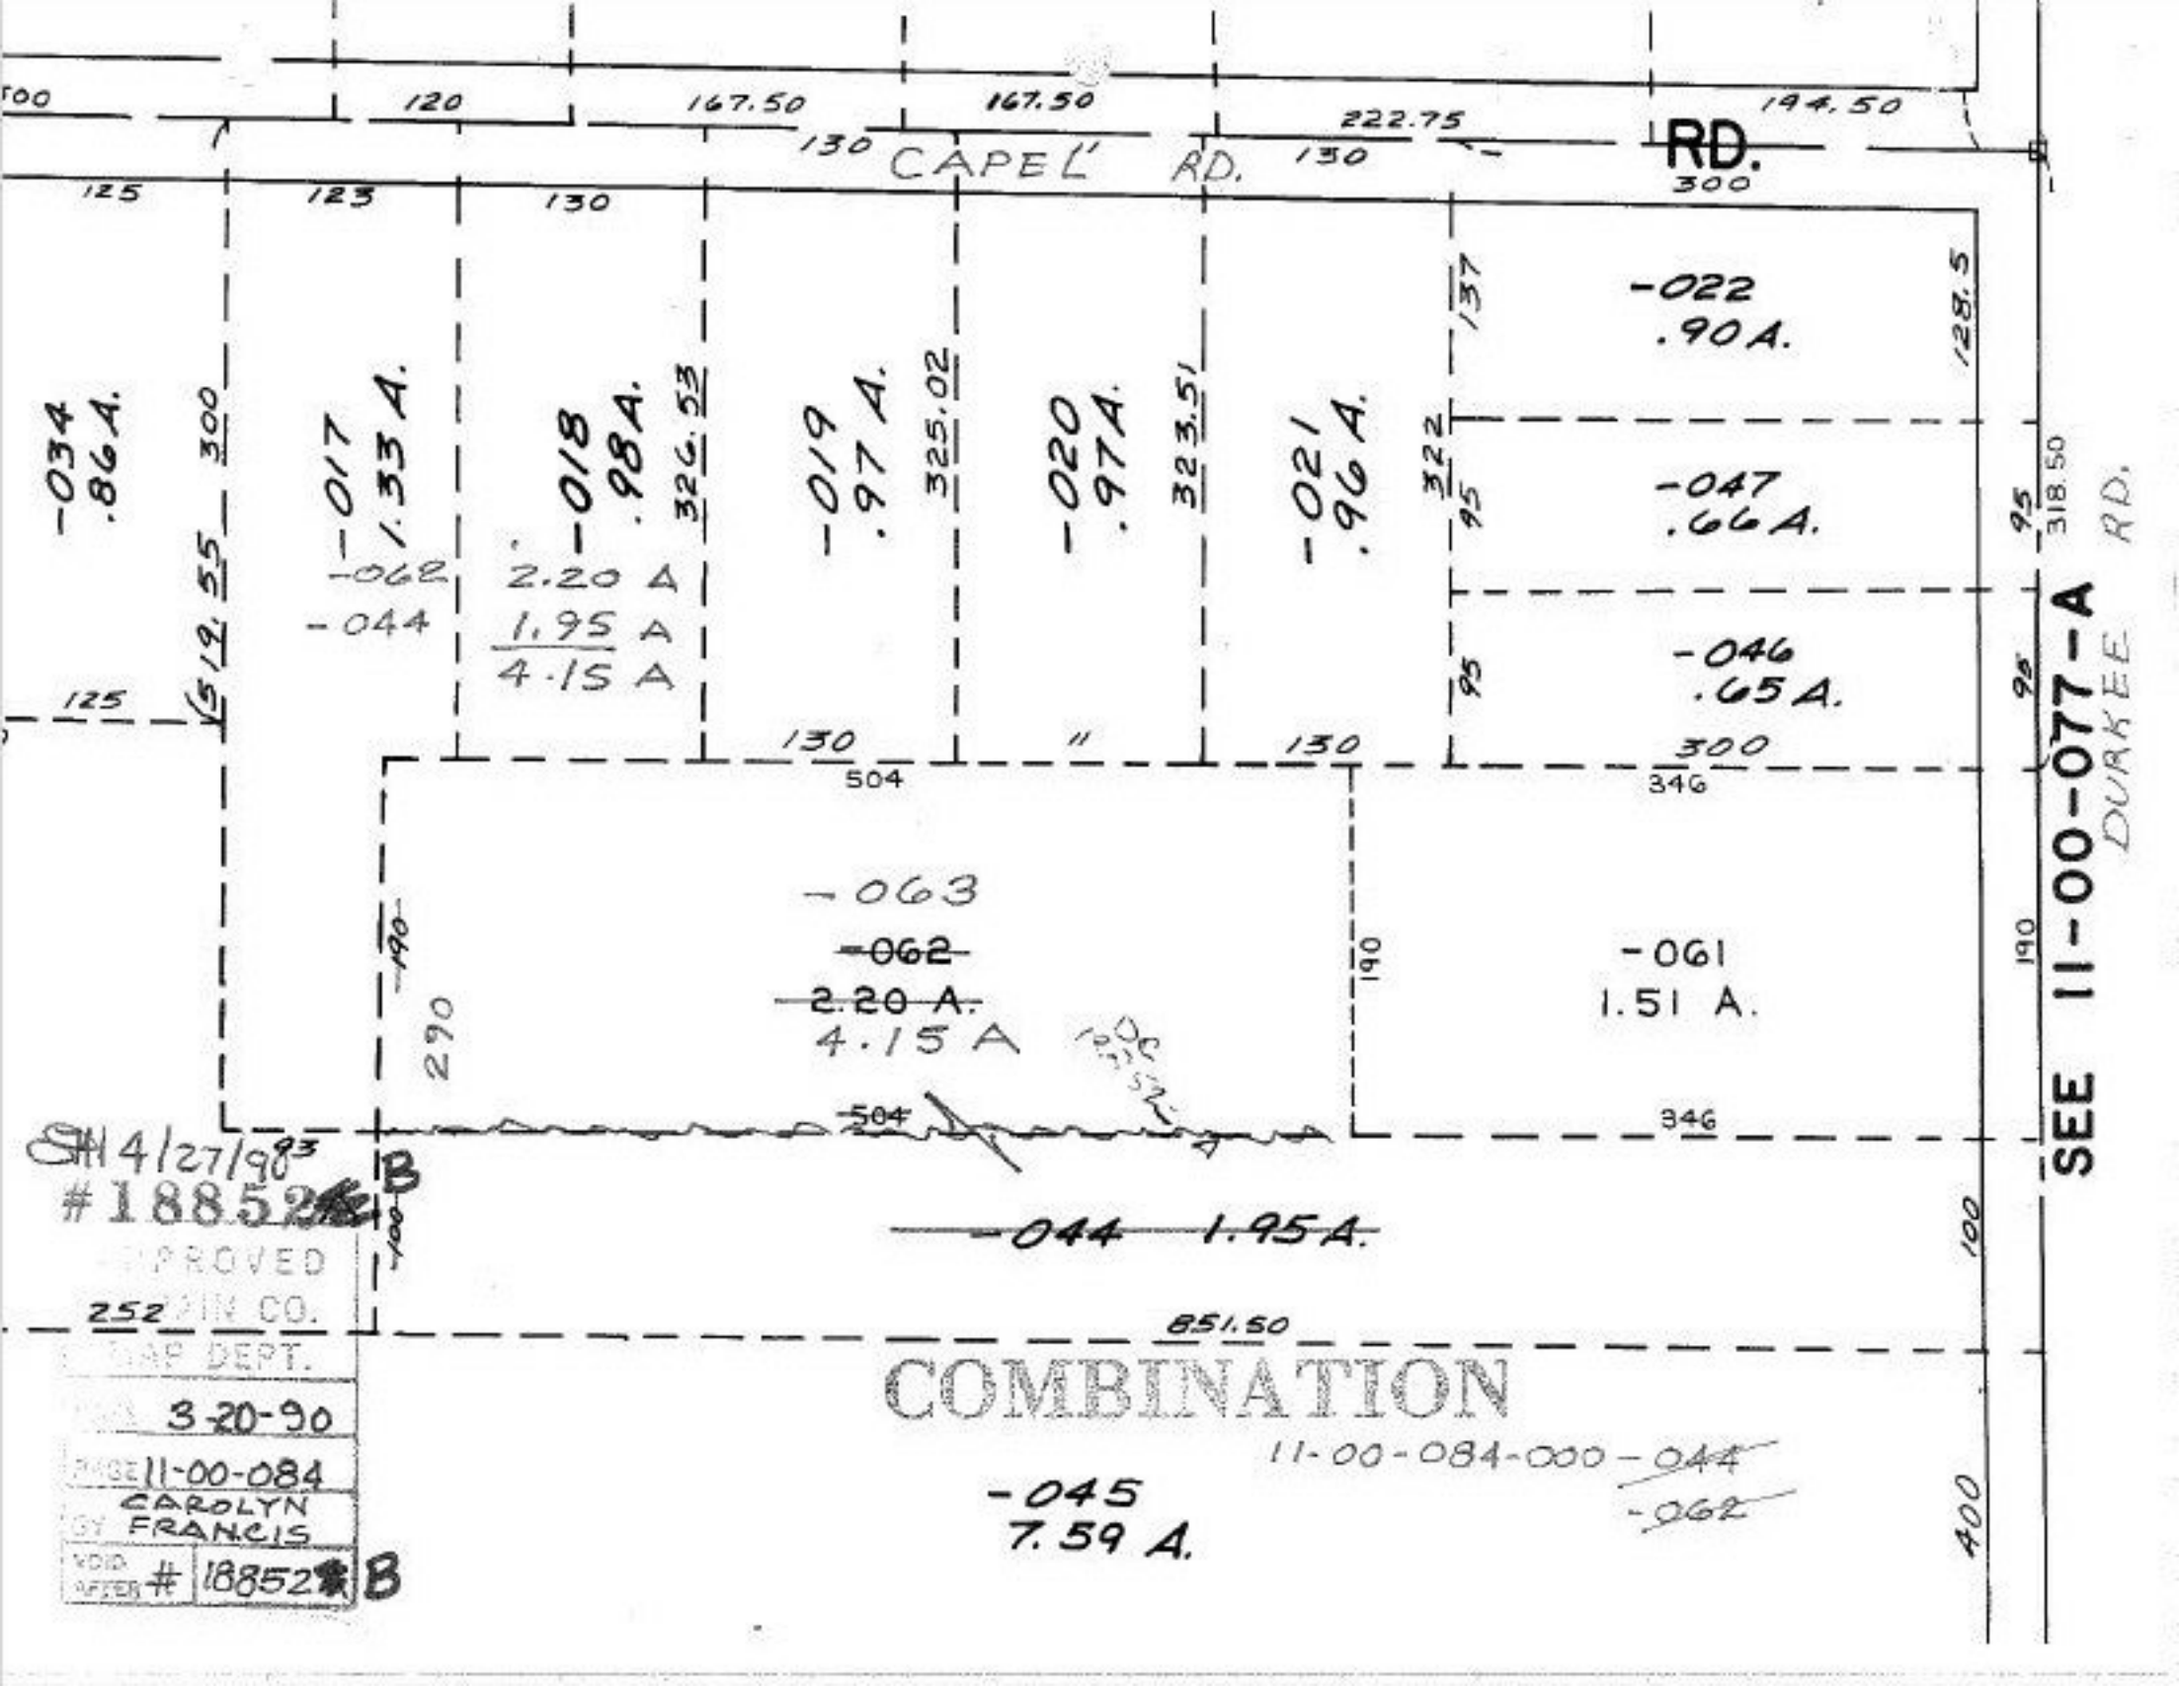
CAPEL' RD.
RD.
-034 .86A.
-017 1.33 A.
-062
-044
2.20 A
1.95 A
4.15 A
-018 .984.
-019 .97 A.
-020 .97A.
-021 .96 A.
-022 .90 A.
-047 .66 A.
-046 .65 A.
-063
-062
2.20 A.
4.15 A
-061
1.51 A.
-044 1.95 A.
-045
7.59 A.
COMBINATION
11-00-084-000-044
-062
SEE 11-00-077-A
DURKEE RD.
4/27/93
#18852 B
APPROVED
COUNTY CO.
MAP DEPT.
3-20-90
PAGE 11-00-084
BY CAROLYN FRANCIS
VOID AFTER # 18852 B