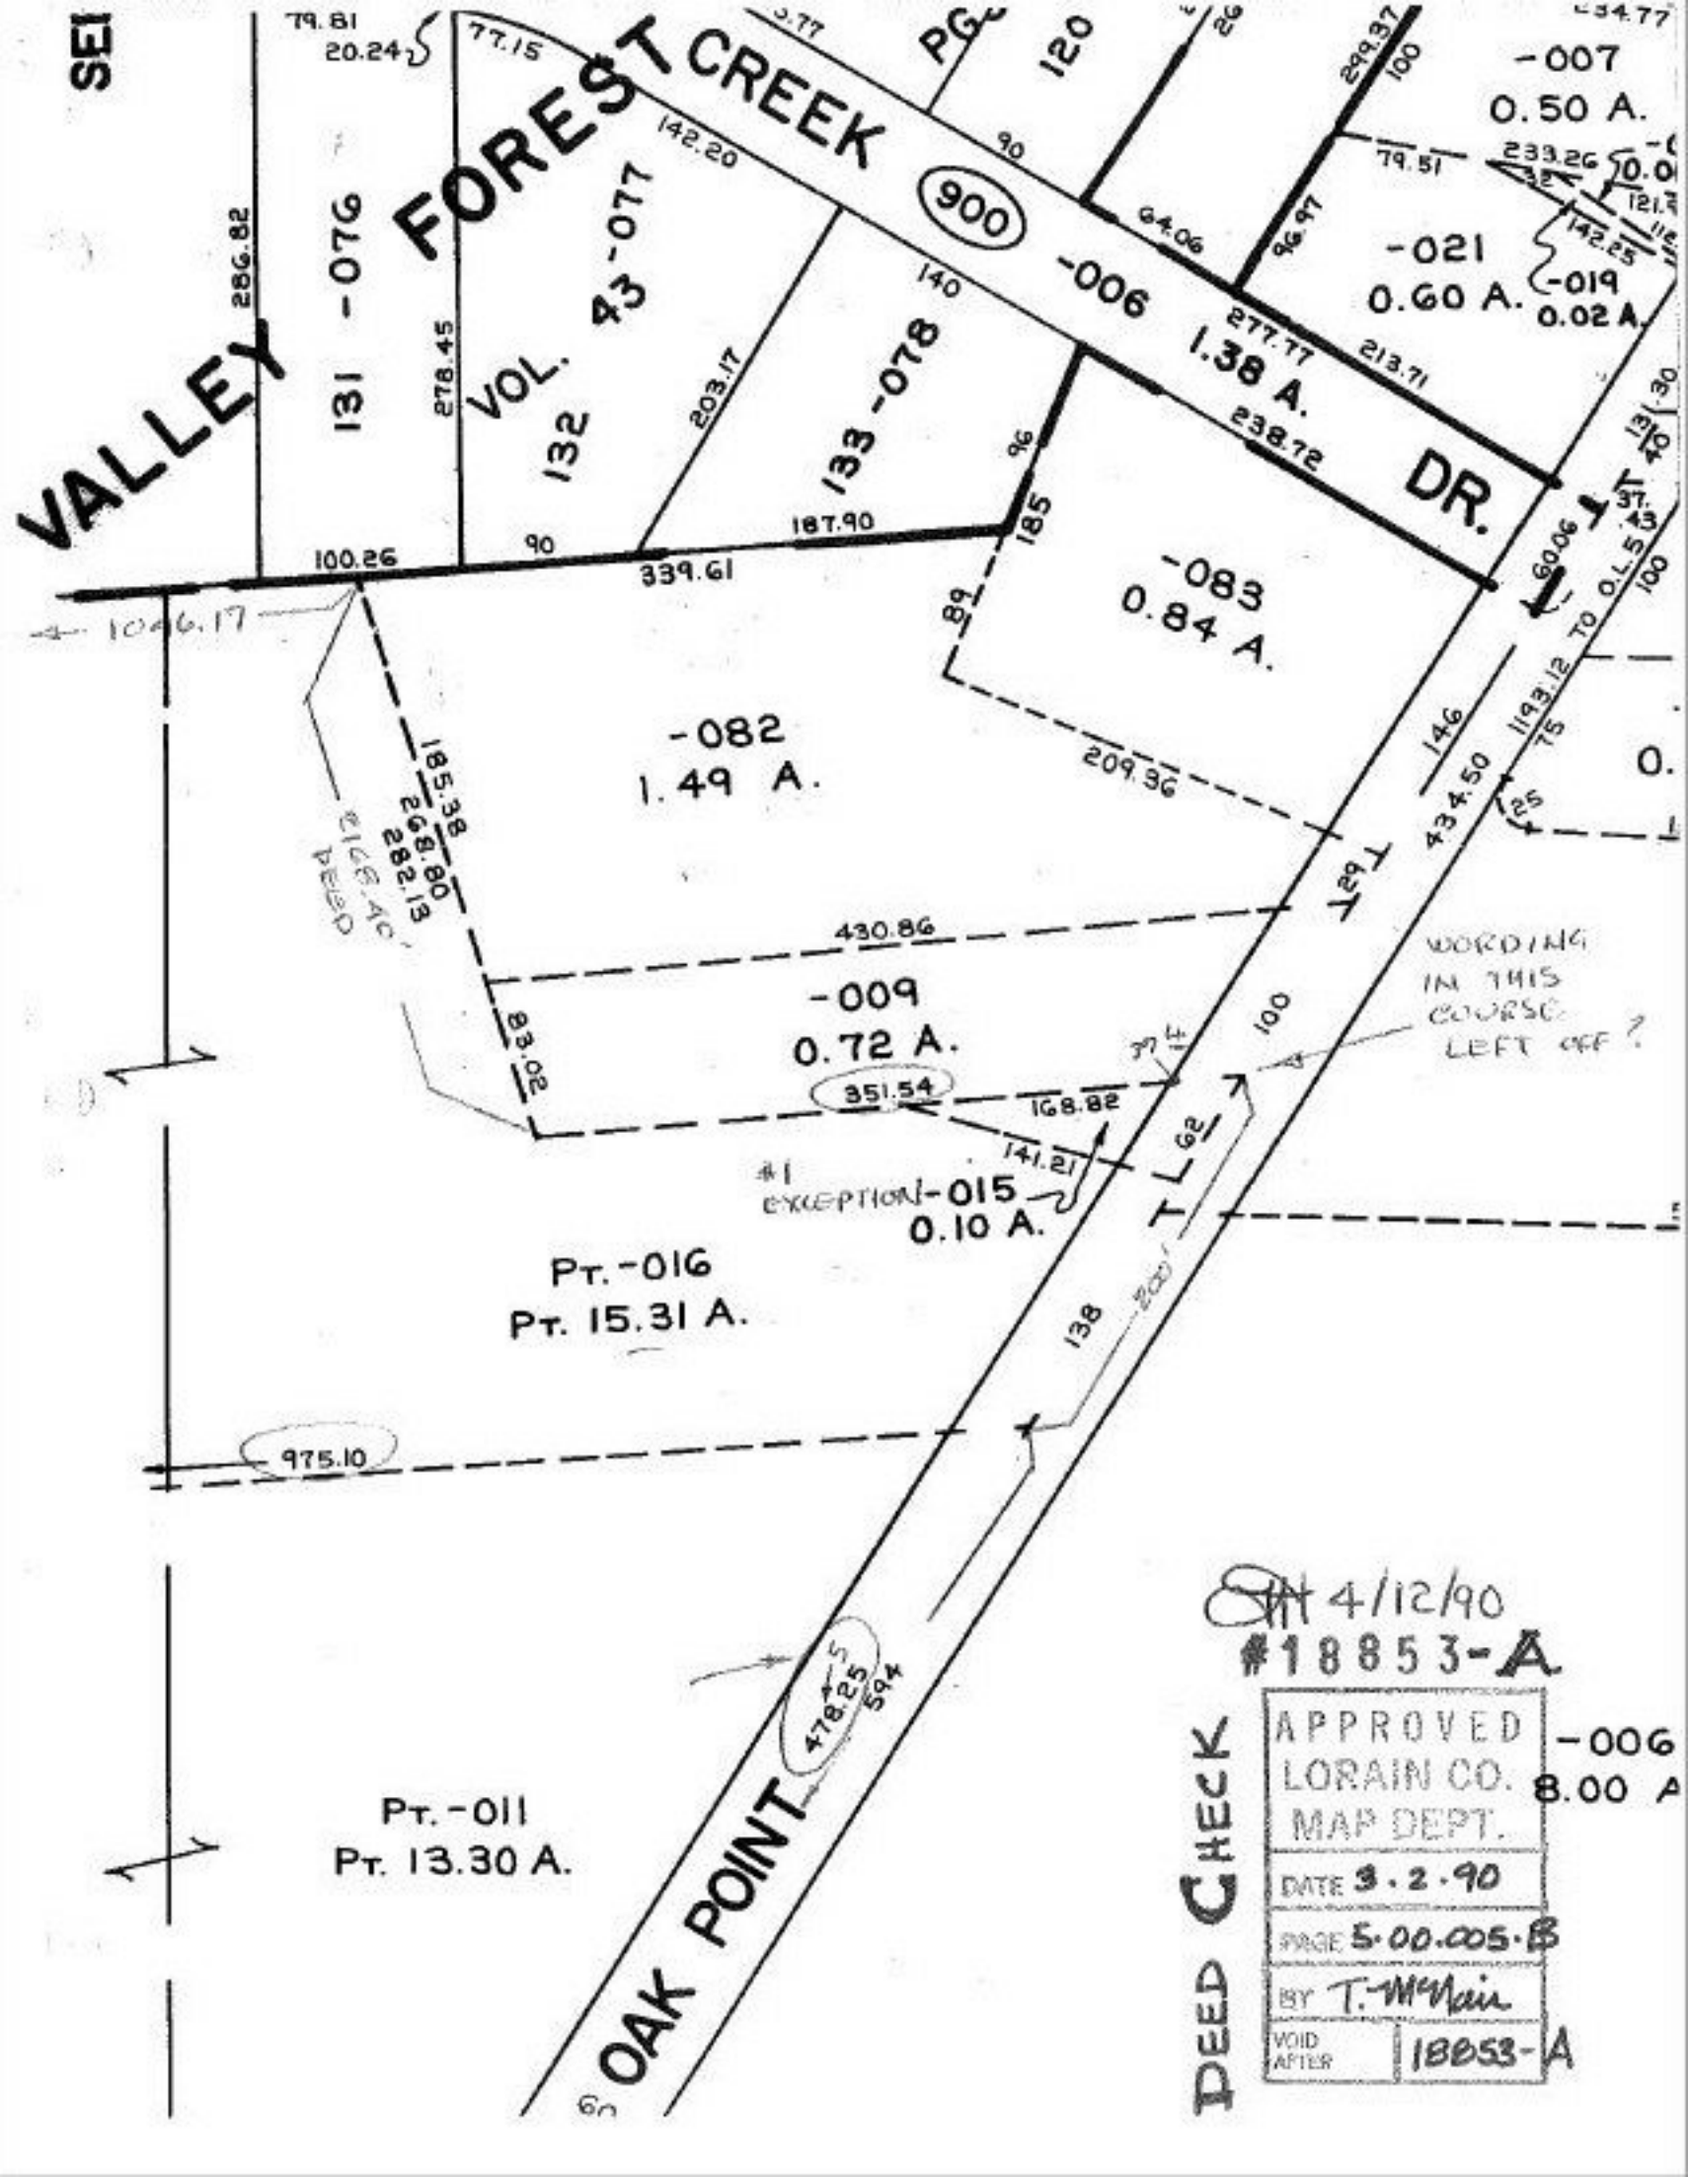
VALLEY FOREST CREEK DR.
OAK POINT
VOL. 43
131 -076
132 -077
133 -078
900
-006
1.38 A.
-007
0.50 A.
-021
0.60 A.
-019
0.02 A.
-083
0.84 A.
-082
1.49 A.
-009
0.72 A.
-015
0.10 A.
Pt. -016
Pt. 15.31 A.
Pt. -011
Pt. 13.30 A.
-006
8.00 A
1046.17
1193.12 TO O.L.5
WORDING IN THIS COURSE LEFT OFF?
#1 EXCEPTION
DEED CHECK
4/12/90
#18853-A
APPROVED
LORAIN CO.
MAP DEPT.
DATE 3.2.90
PAGE 5.00.005.B
BY T. McNair
VOID AFTER 18853-A