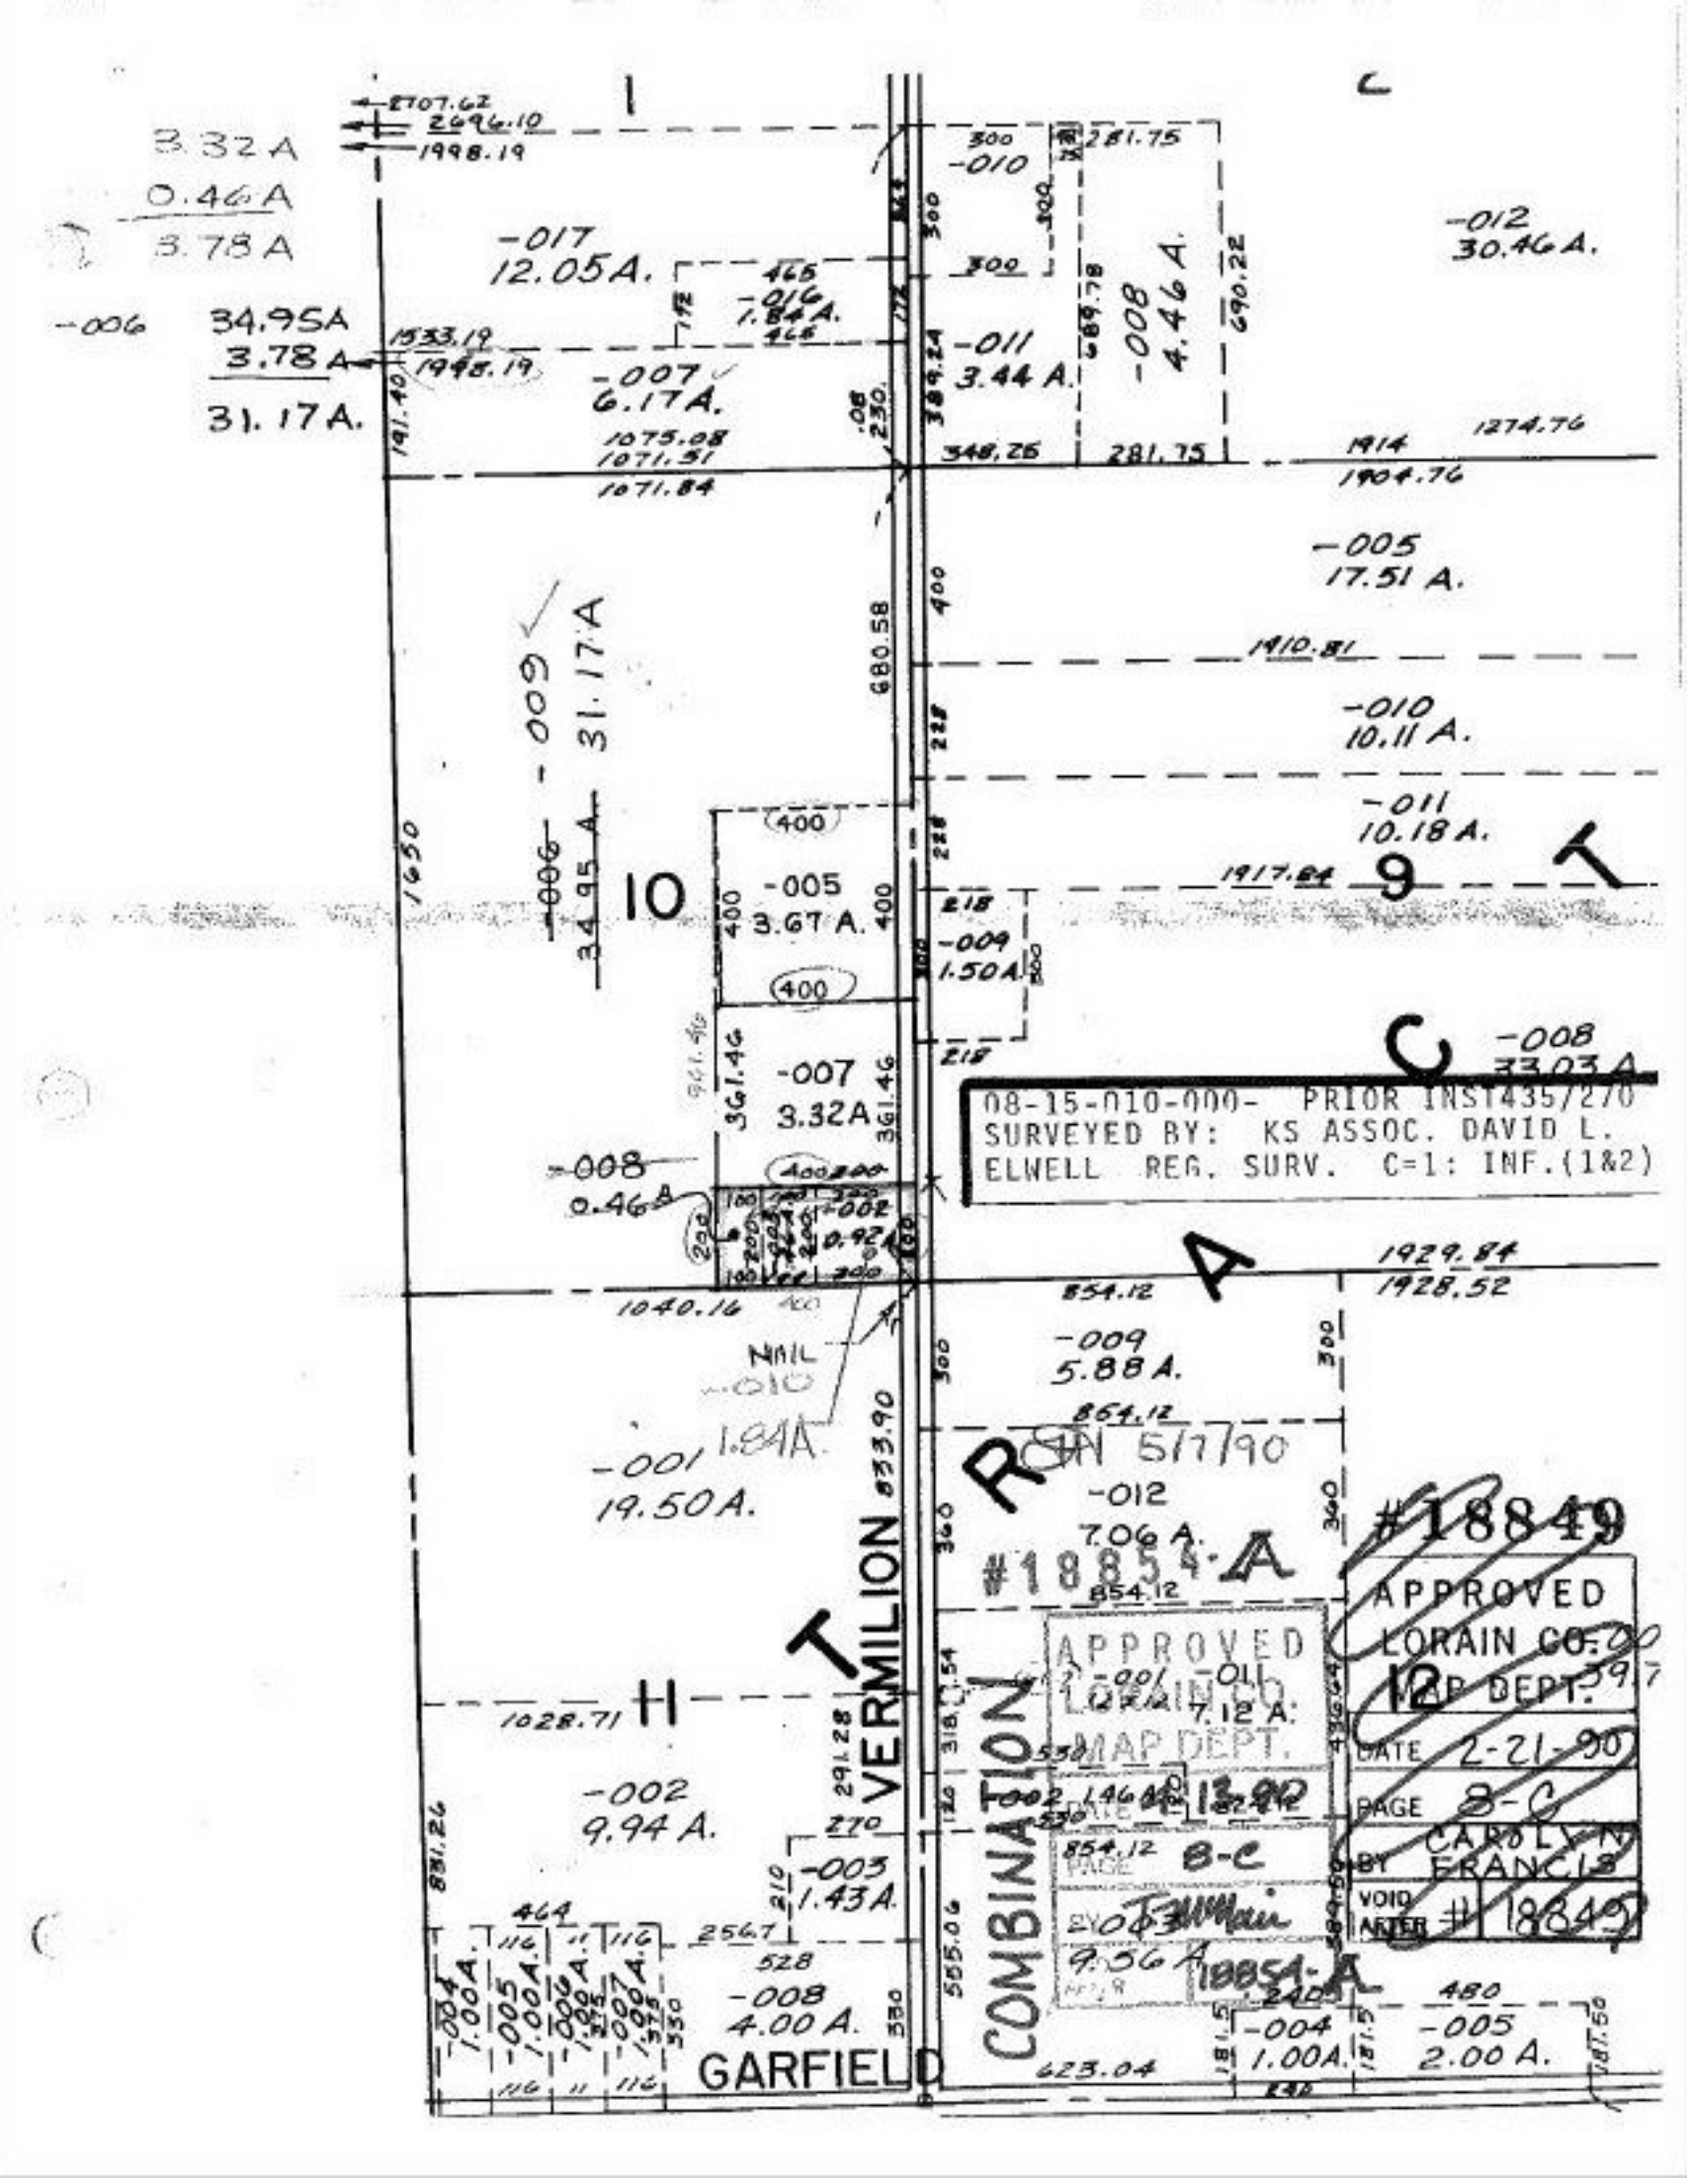

08-15-010-000- PRIOR INST435/270
SURVEYED BY: KS ASSOC. DAVID L.
ELWELL REG. SURV. C=1: INF.(1&2)
VERMILION
GARFIELD
COMBINATION
TRACT
#18849
APPROVED
LORAIN CO.
MAP DEPT.
DATE 2-21-90
PAGE 8-C
BY CAROLYN FRANCIS
VOID AFTER #18849
#18854-A
APPROVED
LORAIN CO.
MAP DEPT.
DATE 13-90
PAGE 8-C
BY
9.56 A
18854-A
-017
12.05A.
-016
1.84A.
-007
6.17A.
-008
4.46 A.
-011
3.44 A.
-012
30.46 A.
-005
17.51 A.
-010
10.11 A.
-011
10.18 A.
-009
1.50A.
-008
33.03 A.
-005
3.67 A.
-007
3.32A
-008
0.46A
-002
0.92A
-009
5.88 A.
-001
19.50A.
-012
7.06 A.
-011
7.12 A.
-002
9.94 A.
-003
1.43A.
-008
4.00 A.
-004
1.00A.
-005
2.00 A.
-006
34.95A
3.78A
31.17A.
-009
31.17A