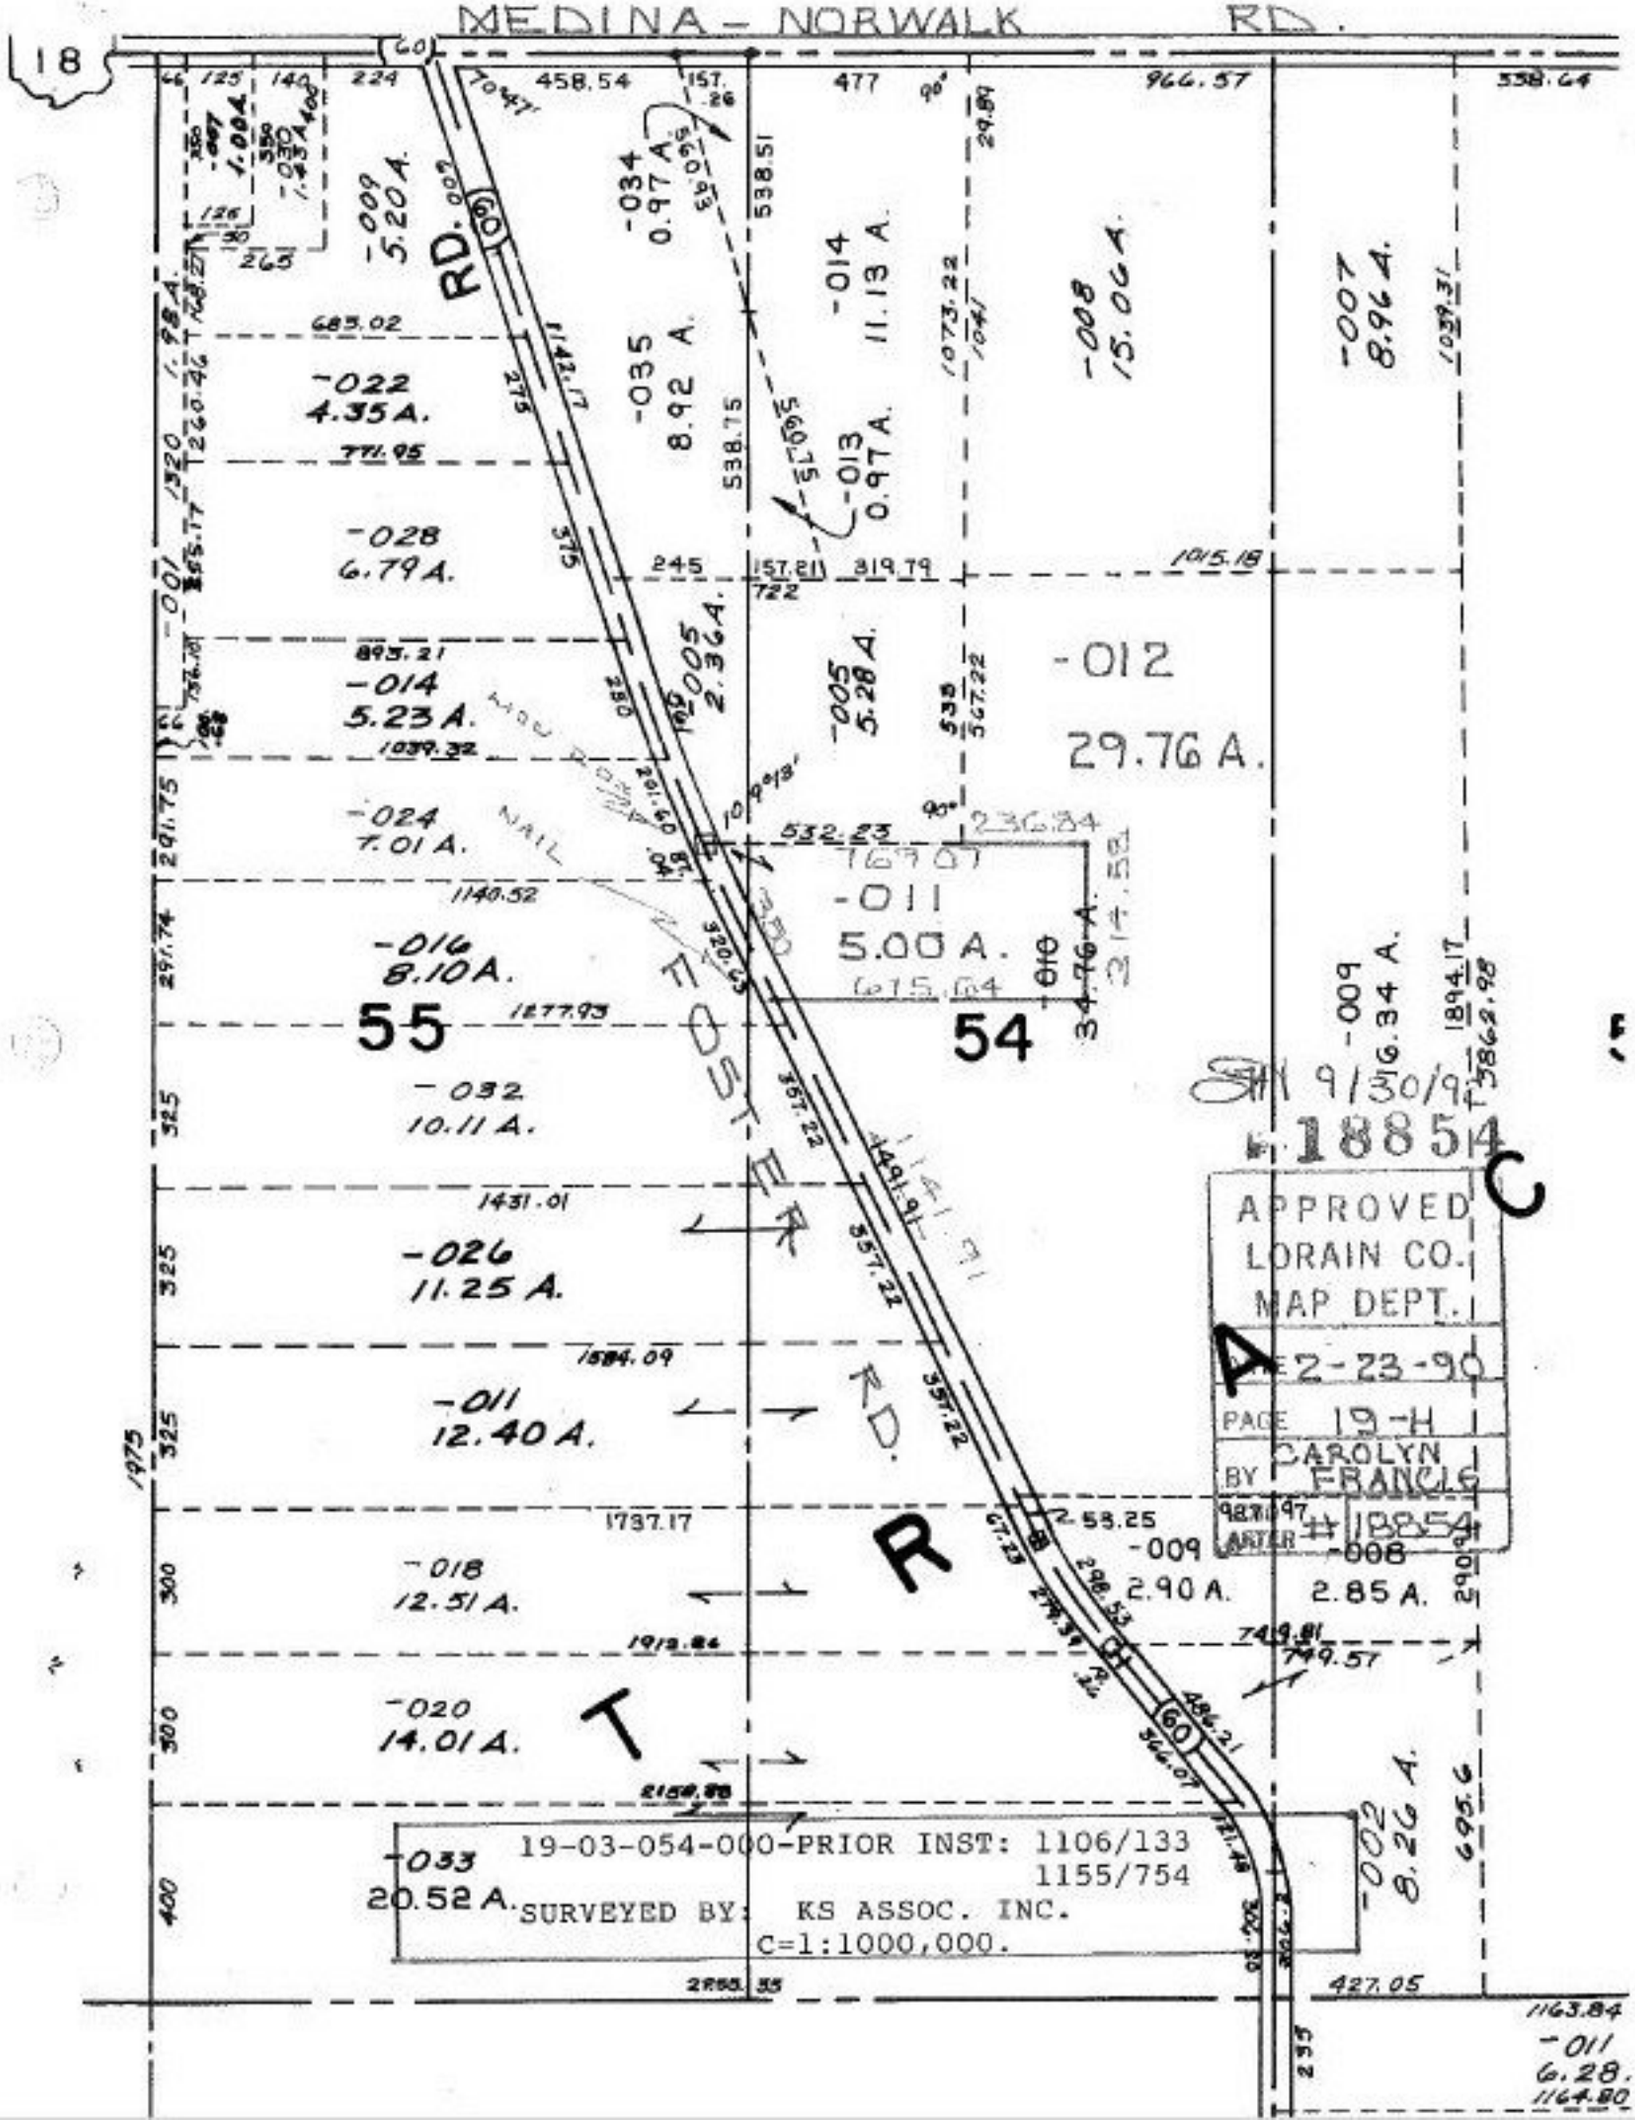
MEDINA - NORWALK RD.
18
RD.
-009 5.20 A.
-034 0.97 A.
-035 8.92 A.
-014 11.13 A.
-013 0.97 A.
-008 15.06 A.
-007 8.96 A.
-022 4.35 A.
-028 6.79 A.
-014 5.23 A.
-005 2.36 A.
-005 5.28 A.
-012 29.76 A.
-024 7.01 A.
-011 5.00 A.
-016 8.10 A.
55
54
-032 10.11 A.
-026 11.25 A.
-011 12.40 A.
-018 12.51 A.
-020 14.01 A.
-033 20.52 A.
-009 16.34 A.
-009 2.90 A.
-008 2.85 A.
-002 8.26 A.
-011 6.28.
FOSTER RD.
T R A C
19-03-054-000-PRIOR INST: 1106/133
1155/754
SURVEYED BY: KS ASSOC. INC.
C=1:1000,000.
9/30/97
18854
APPROVED
LORAIN CO.
MAP DEPT.
2-23-90
PAGE 19-H
BY CAROLYN FRANCIS
ARTER # 18854