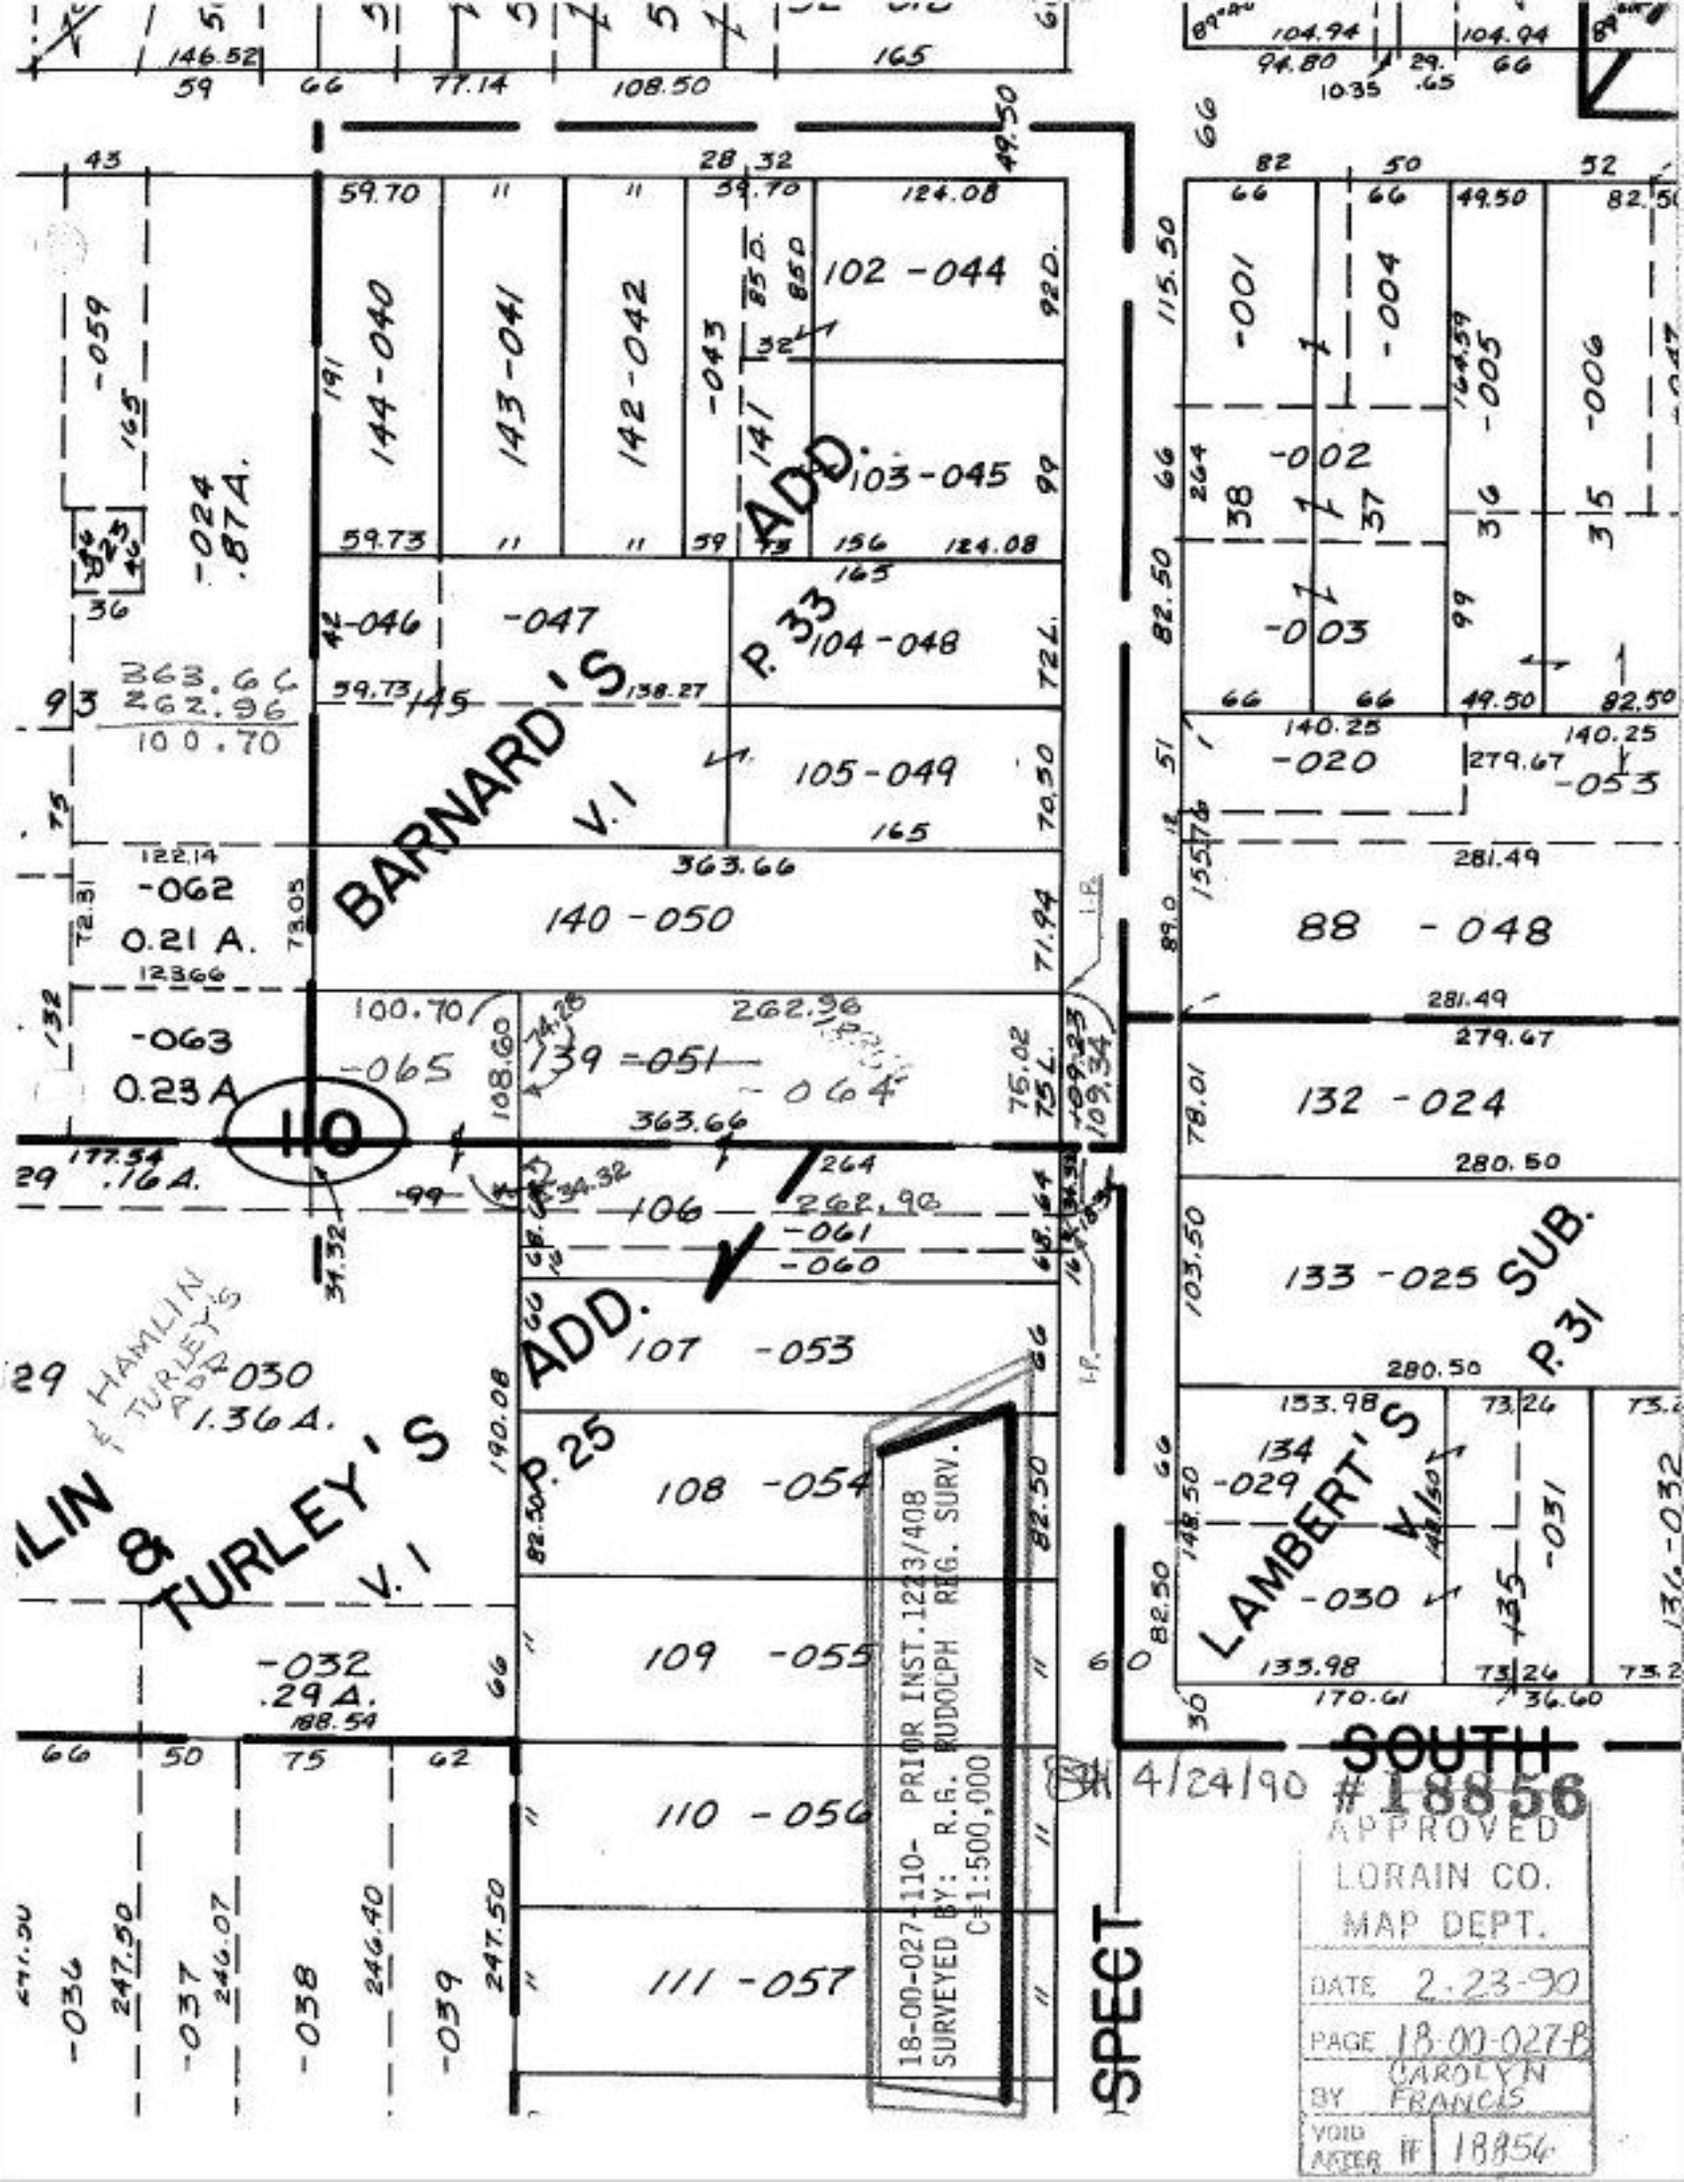
BARNARD'S ADD. V.1
P. 33
102 -044
103 -045
104 -048
105 -049
140 -050
144 -040
143 -041
142 -042
-043
-046
-047
-024 .87A.
-059
-062 0.21 A.
-063 0.23A
-065
139 -051
-064
106
-061
-060
107 -053
108 -054
109 -055
110 -056
111 -057
-032 .29A.
-030 1.36A.
HAMLIN & TURLEY'S ADD. V.1
P. 25
-001
-004
-005
-006
-002
-003
-020
-053
88 -048
132 -024
133 -025 SUB. P. 31
LAMBERT'S
134 -029
-030
-031
135
SOUTH
SPECT
18-00-027-110- PRIOR INST. 1223/408
SURVEYED BY: R.G. RUDOLPH REG. SURV.
C=1:500,000
4/24/90
#18856
APPROVED
LORAIN CO.
MAP DEPT.
DATE 2-23-90
PAGE 18-00-027-B
BY CAROLYN FRANCIS
VOID AFTER 18856