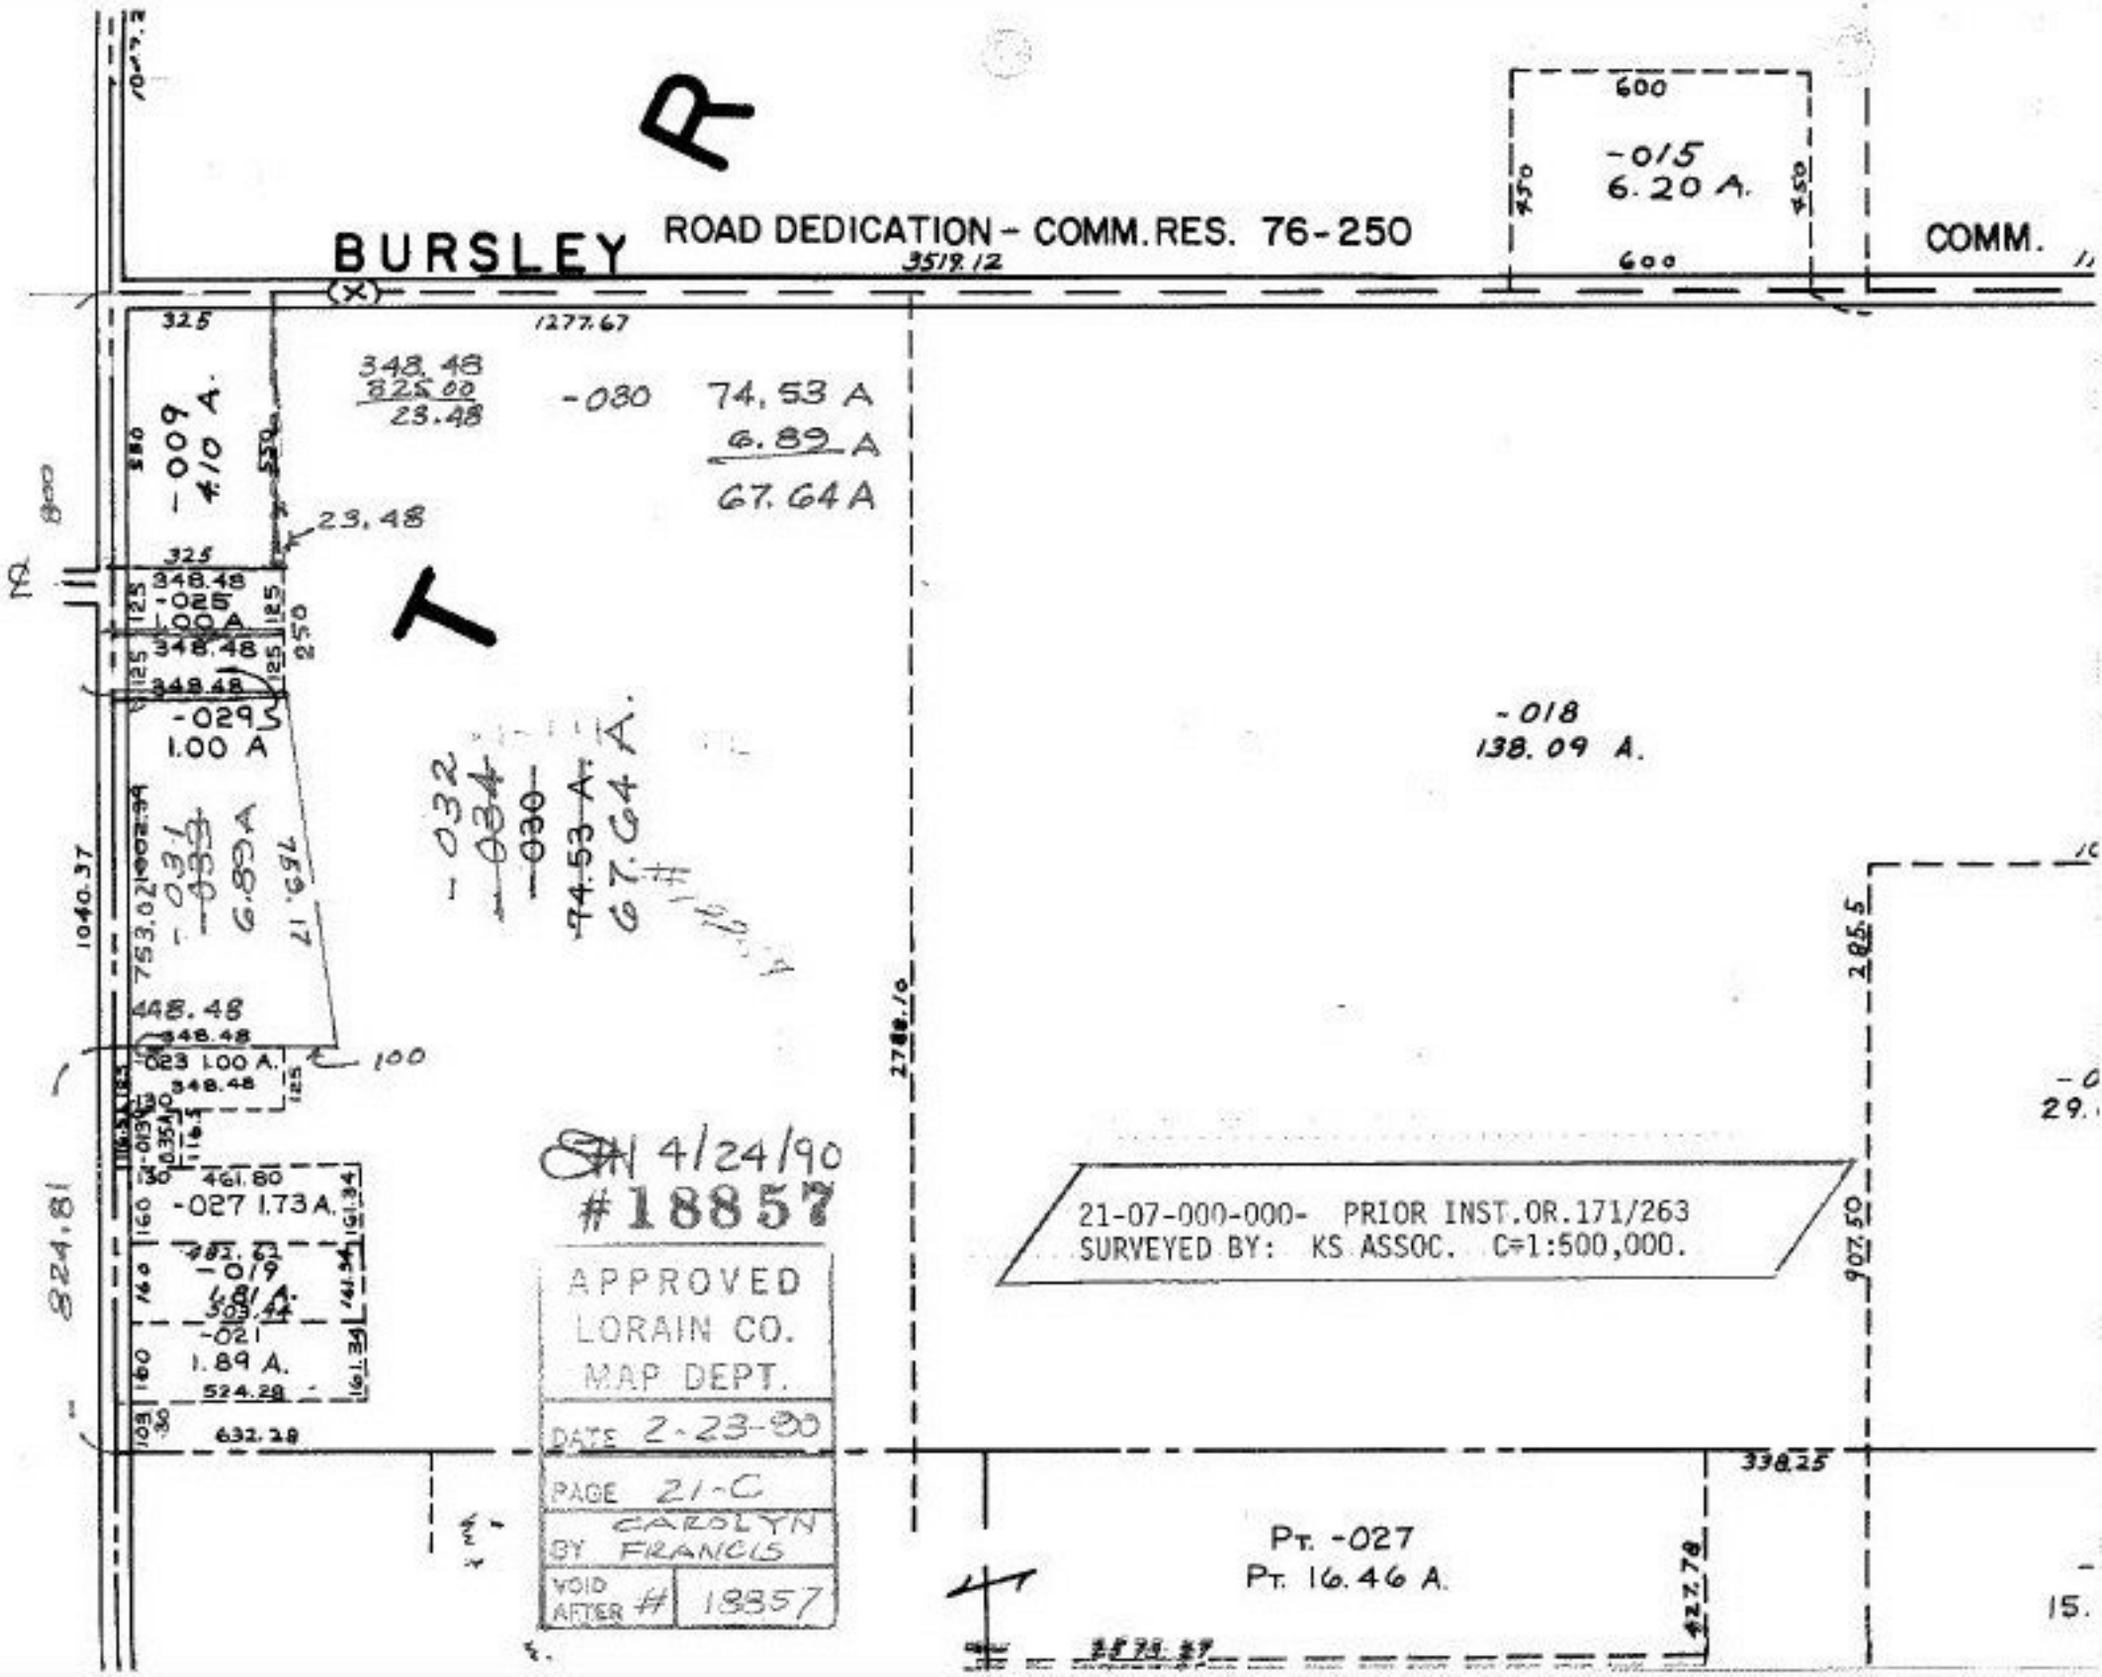

BURSLEY
ROAD DEDICATION - COMM. RES. 76-250
COMM.
R
T
600
-015
6.20 A.
450
600
3519.12
325
1277.67
348.48
825.00
23.48
-030
74.53 A
6.89 A
67.64 A
-009
4.10 A.
23.48
325
348.48
-025
1.00 A.
348.48
348.48
-029
1.00 A
-032
-034
-030
74.53 A.
67.64 A.
-018
138.09 A.
1040.37
753.02
-031
-033
6.89 A
759.17
448.48
348.48
-023 1.00 A.
348.48
100
2788.10
285.5
461.80
-027 1.73 A.
482.62
-019
1.81 A.
503.44
-021
1.89 A.
524.28
632.28
824.81
907.50
338.25
427.78
Pt. -027
Pt. 16.46 A.
15.
4/24/90
#18857
APPROVED
LORAIN CO.
MAP DEPT.
DATE 2-23-90
PAGE 21-C
BY CAROLYN FRANCIS
VOID AFTER # 18857
21-07-000-000- PRIOR INST.OR.171/263
SURVEYED BY: KS ASSOC. C=1:500,000.