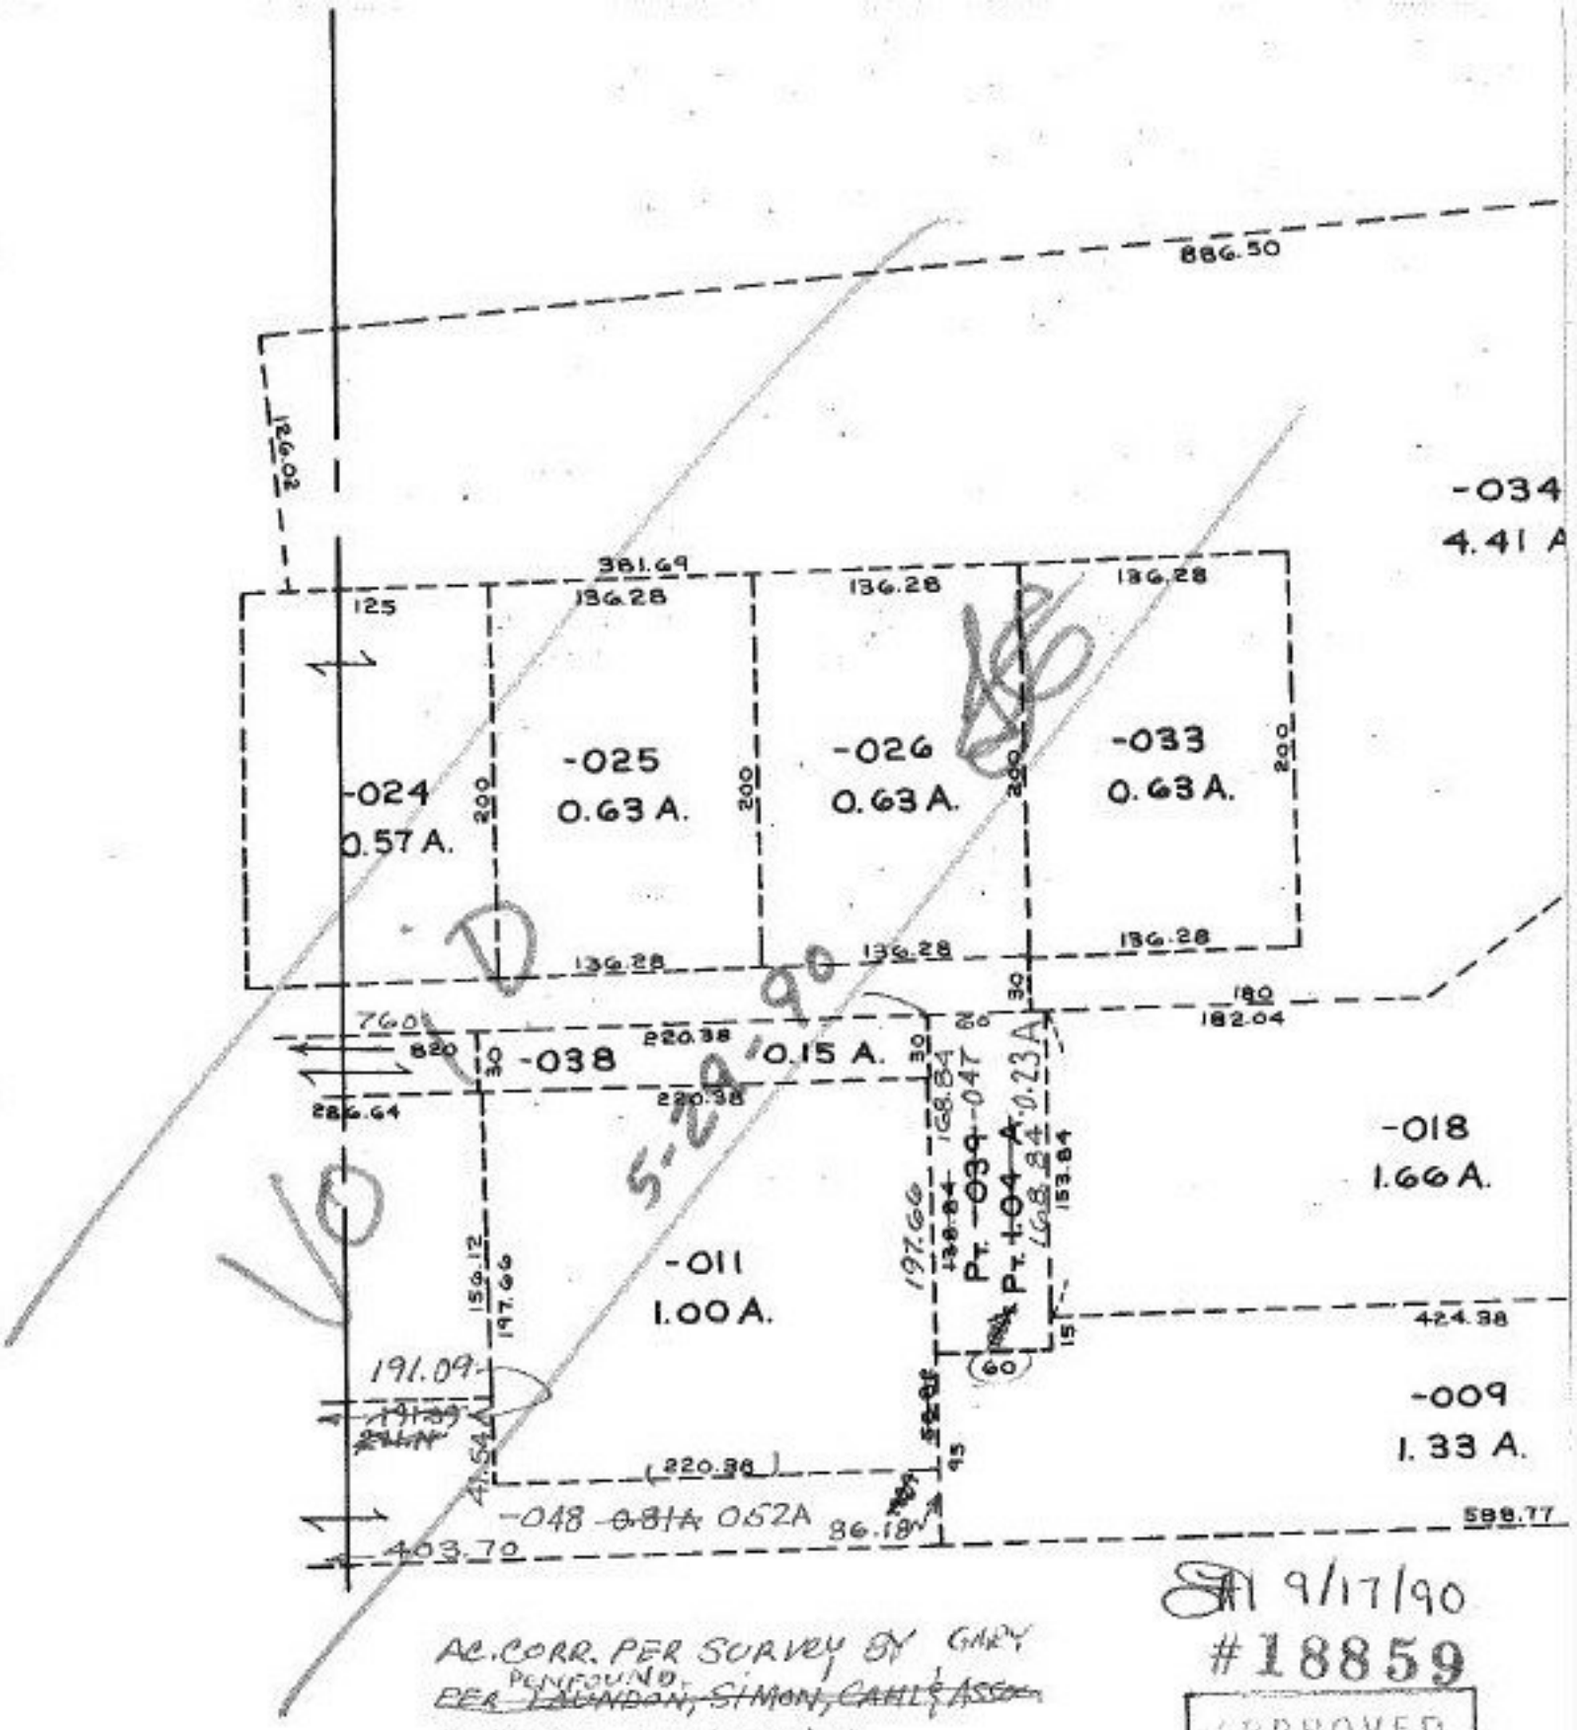

AC. CORR. PER SURVEY BY GARY PENFOUND.
~~PER LAUDON, SIMON, CAHL & ASSOC.~~

C=1! INF PARCEL (1) & (2)

9/17/90
#18859

10-00-015-101- PRIOR INST. 222/492 C=1: INF
TAKEN FROM SURVEY MAP DONE BY: GARY E. PENFOUND
REG. SURVEYOR. ADDITIONAL INFORMATION BY:
LAUDON, SIMON, CAHL & ASSOC.

APPROVED
LORAIN CO.
MAP DEPT.
DATE 2-28-90
CASE 10-00-015-A
BY CAROLYN Francis
VOID AFTER # 18859