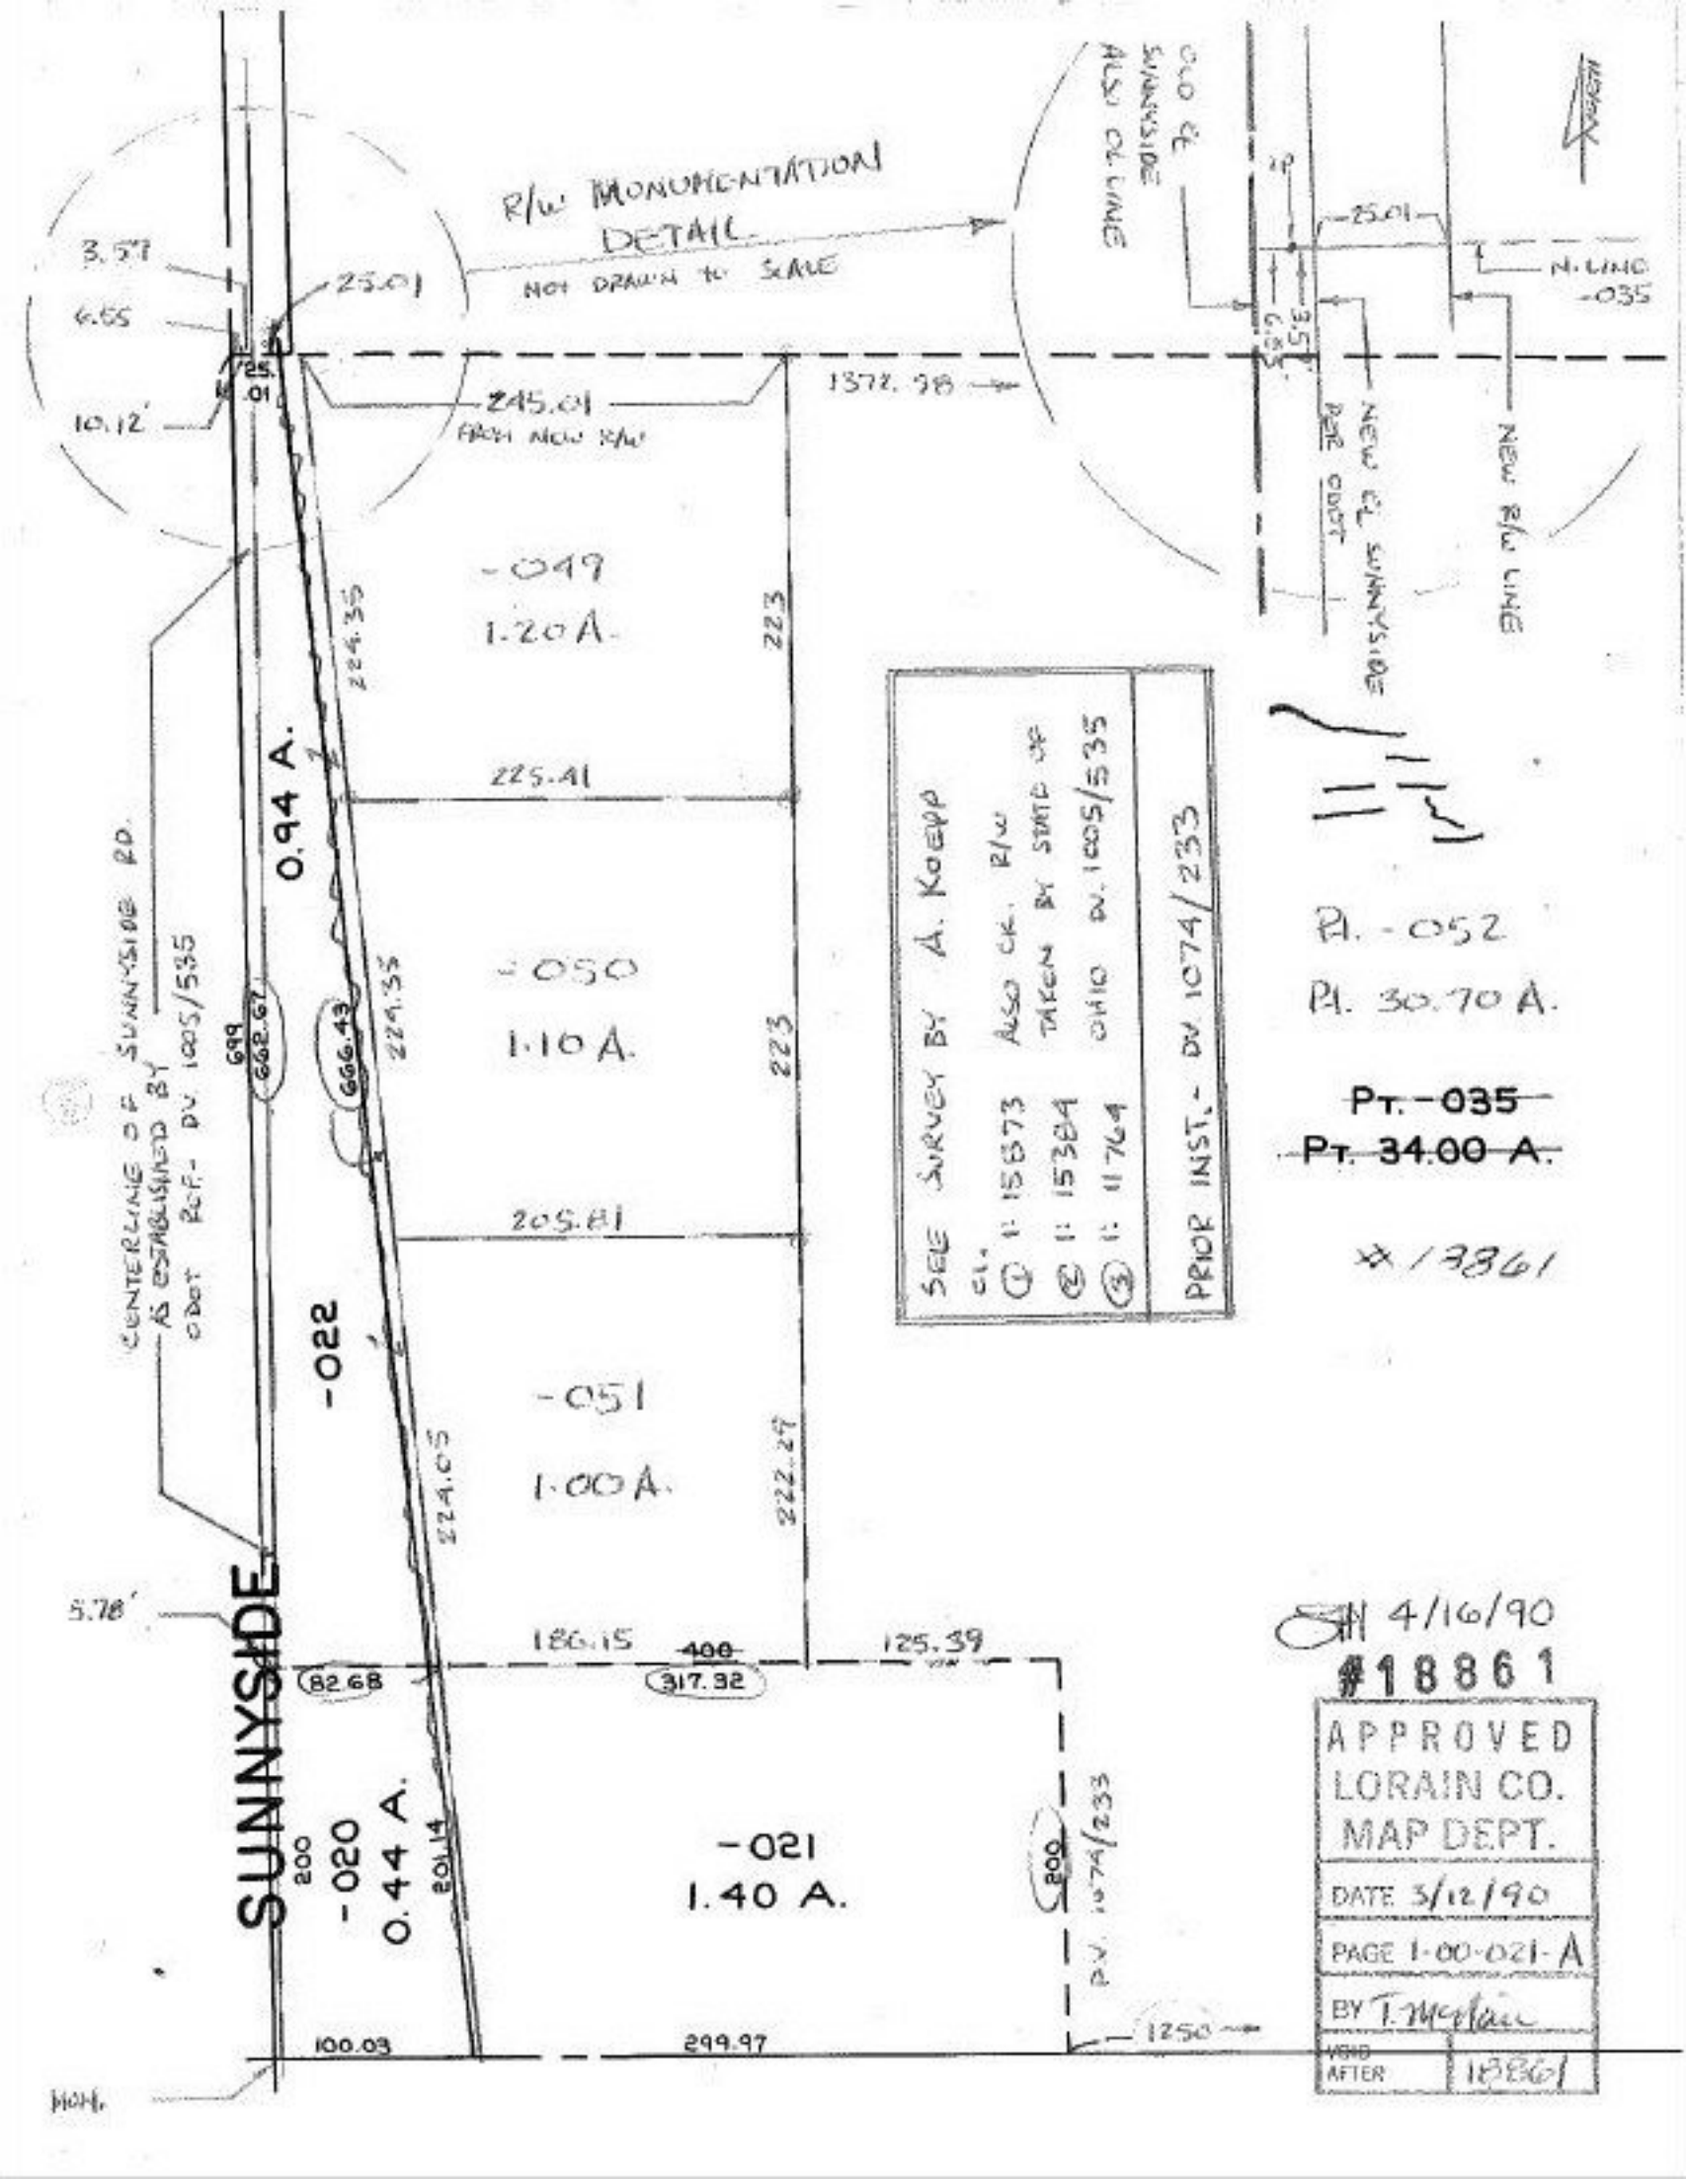
R/W MONUMENTATION DETAIL
NOT DRAWN TO SCALE
3.57
6.55
10.12'
25.01
245.01
FROM NEW R/W
1372.98
-049
1.20 A.
224.35
223
225.41
0.94 A.
-050
1.10 A.
224.35
223
205.81
-022
-051
1.00 A.
224.05
222.29
5.78'
186.15
400
125.39
82.68
317.32
SUNNYSIDE
200
-020
0.44 A.
201.14
-021
1.40 A.
800
P.V. 1074/233
100.03
299.97
1250
MON.
CENTERLINE OF SUNNYSIDE RD.
AS ESTABLISHED BY
ODOT REF.- DV. 1005/535
699
662.67
666.43
224.35
SEE SURVEY BY A. KOEPP
CL.
① I: 15873 ALSO CK. R/W
② I: 15384 TAKEN BY STATE OF
③ I: 11764 OHIO DV. 1005/535
PRIOR INST.- DV 1074/233
OLD CL SUNNYSIDE RD.
ALSO TO BE
NEW CL SUNNYSIDE RD.
NEW R/W LINE
N. LINE -035
25.01
3.57
2.68
Pt. -052
Pt. 30.70 A.
~~Pt. -035~~
~~Pt. 34.00 A.~~
#18861
4/16/90
#18861
APPROVED
LORAIN CO.
MAP DEPT.
DATE 3/12/90
PAGE 1-00-021-A
BY T. McClain
VOID AFTER 18861