2X 287.61 = 575.22
750.00
1325.22

-016 21.92 A
SPLT 5.25A
REM: 16.67 A

918.42
305.15
1223.57

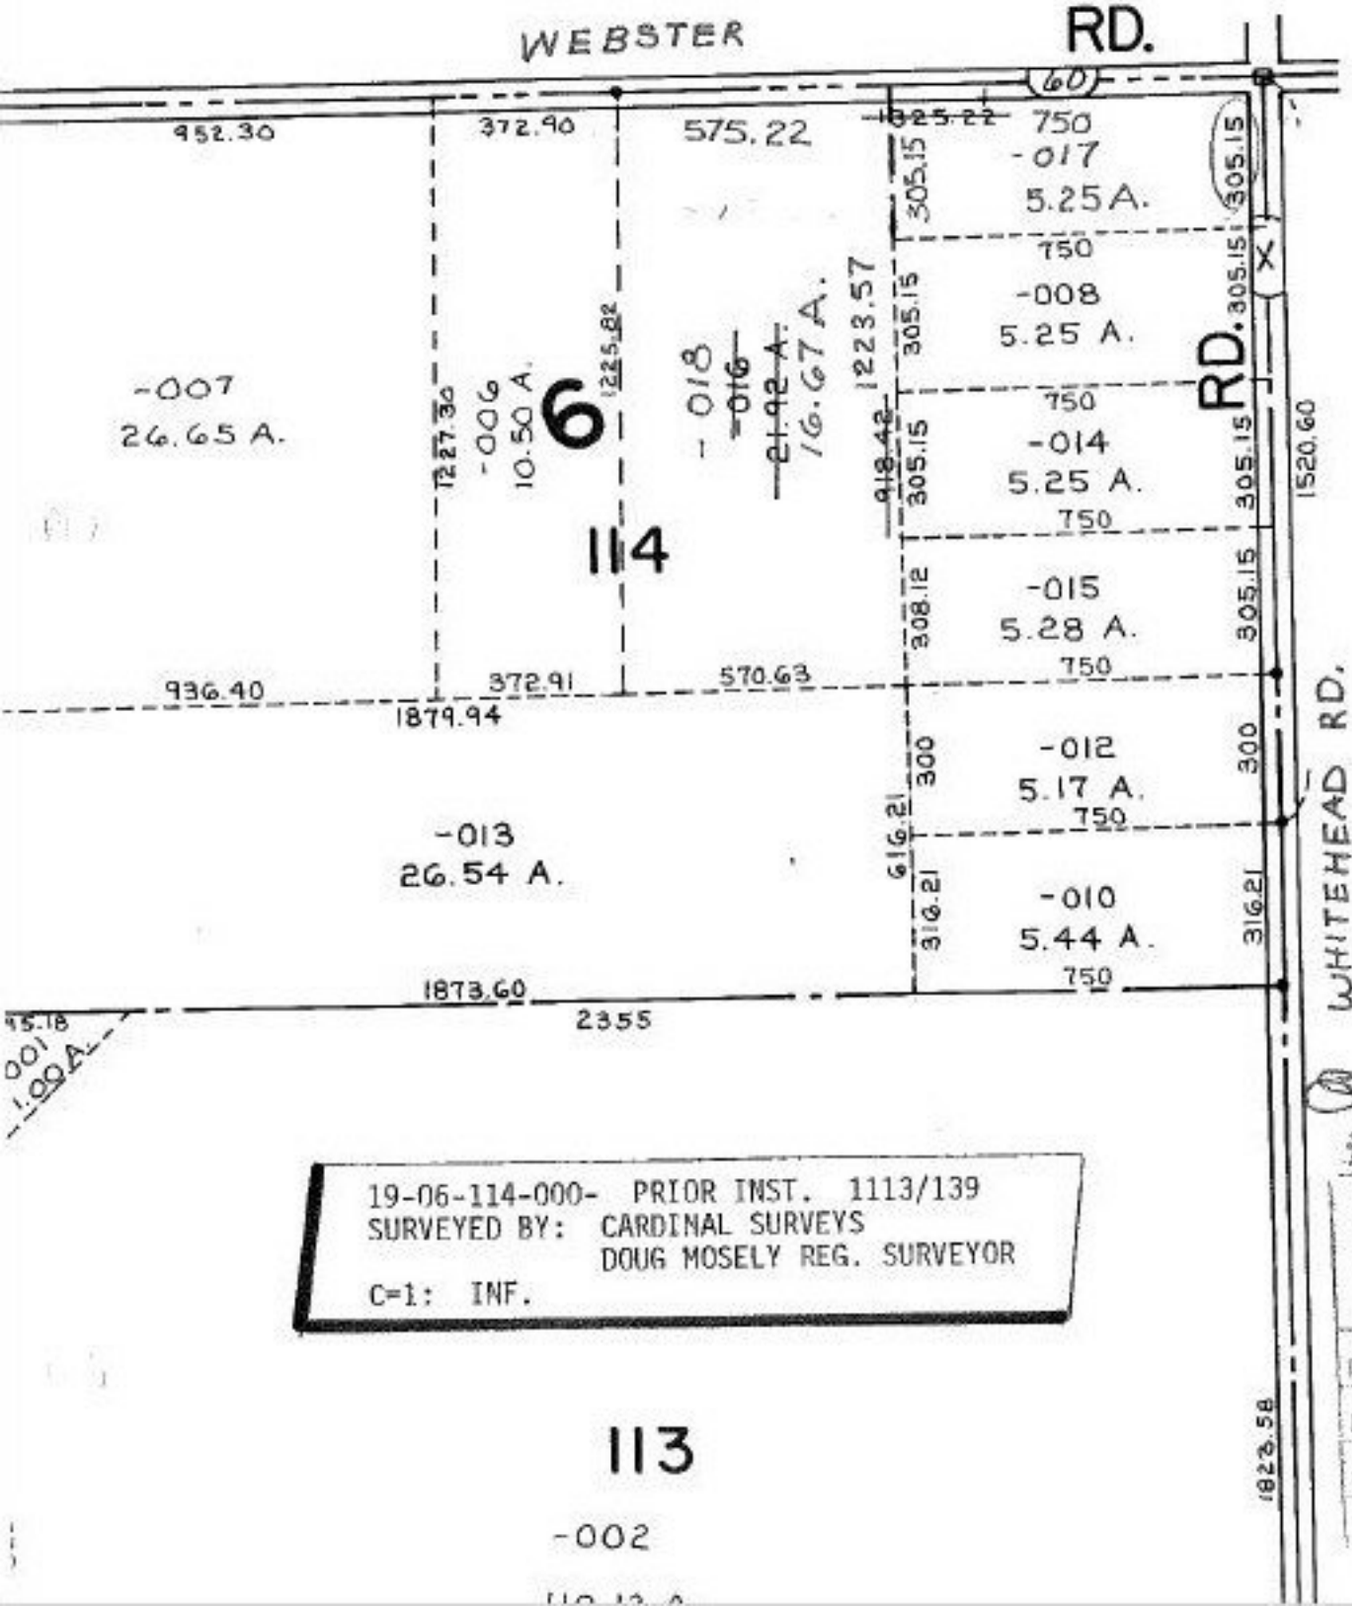

114

113

-002

19-06-114-000- PRIOR INST. 1113/139
SURVEYED BY: CARDINAL SURVEYS
DOUG MOSELY REG. SURVEYOR
C=1: INF.

4/24/90
#18862

APPROVED
LORAIN CO.
MAP DEPT.
DATE 3-6-90
PAGE 19-A
BY CAROLYN FRANCIS
VOID AFTER # 18862