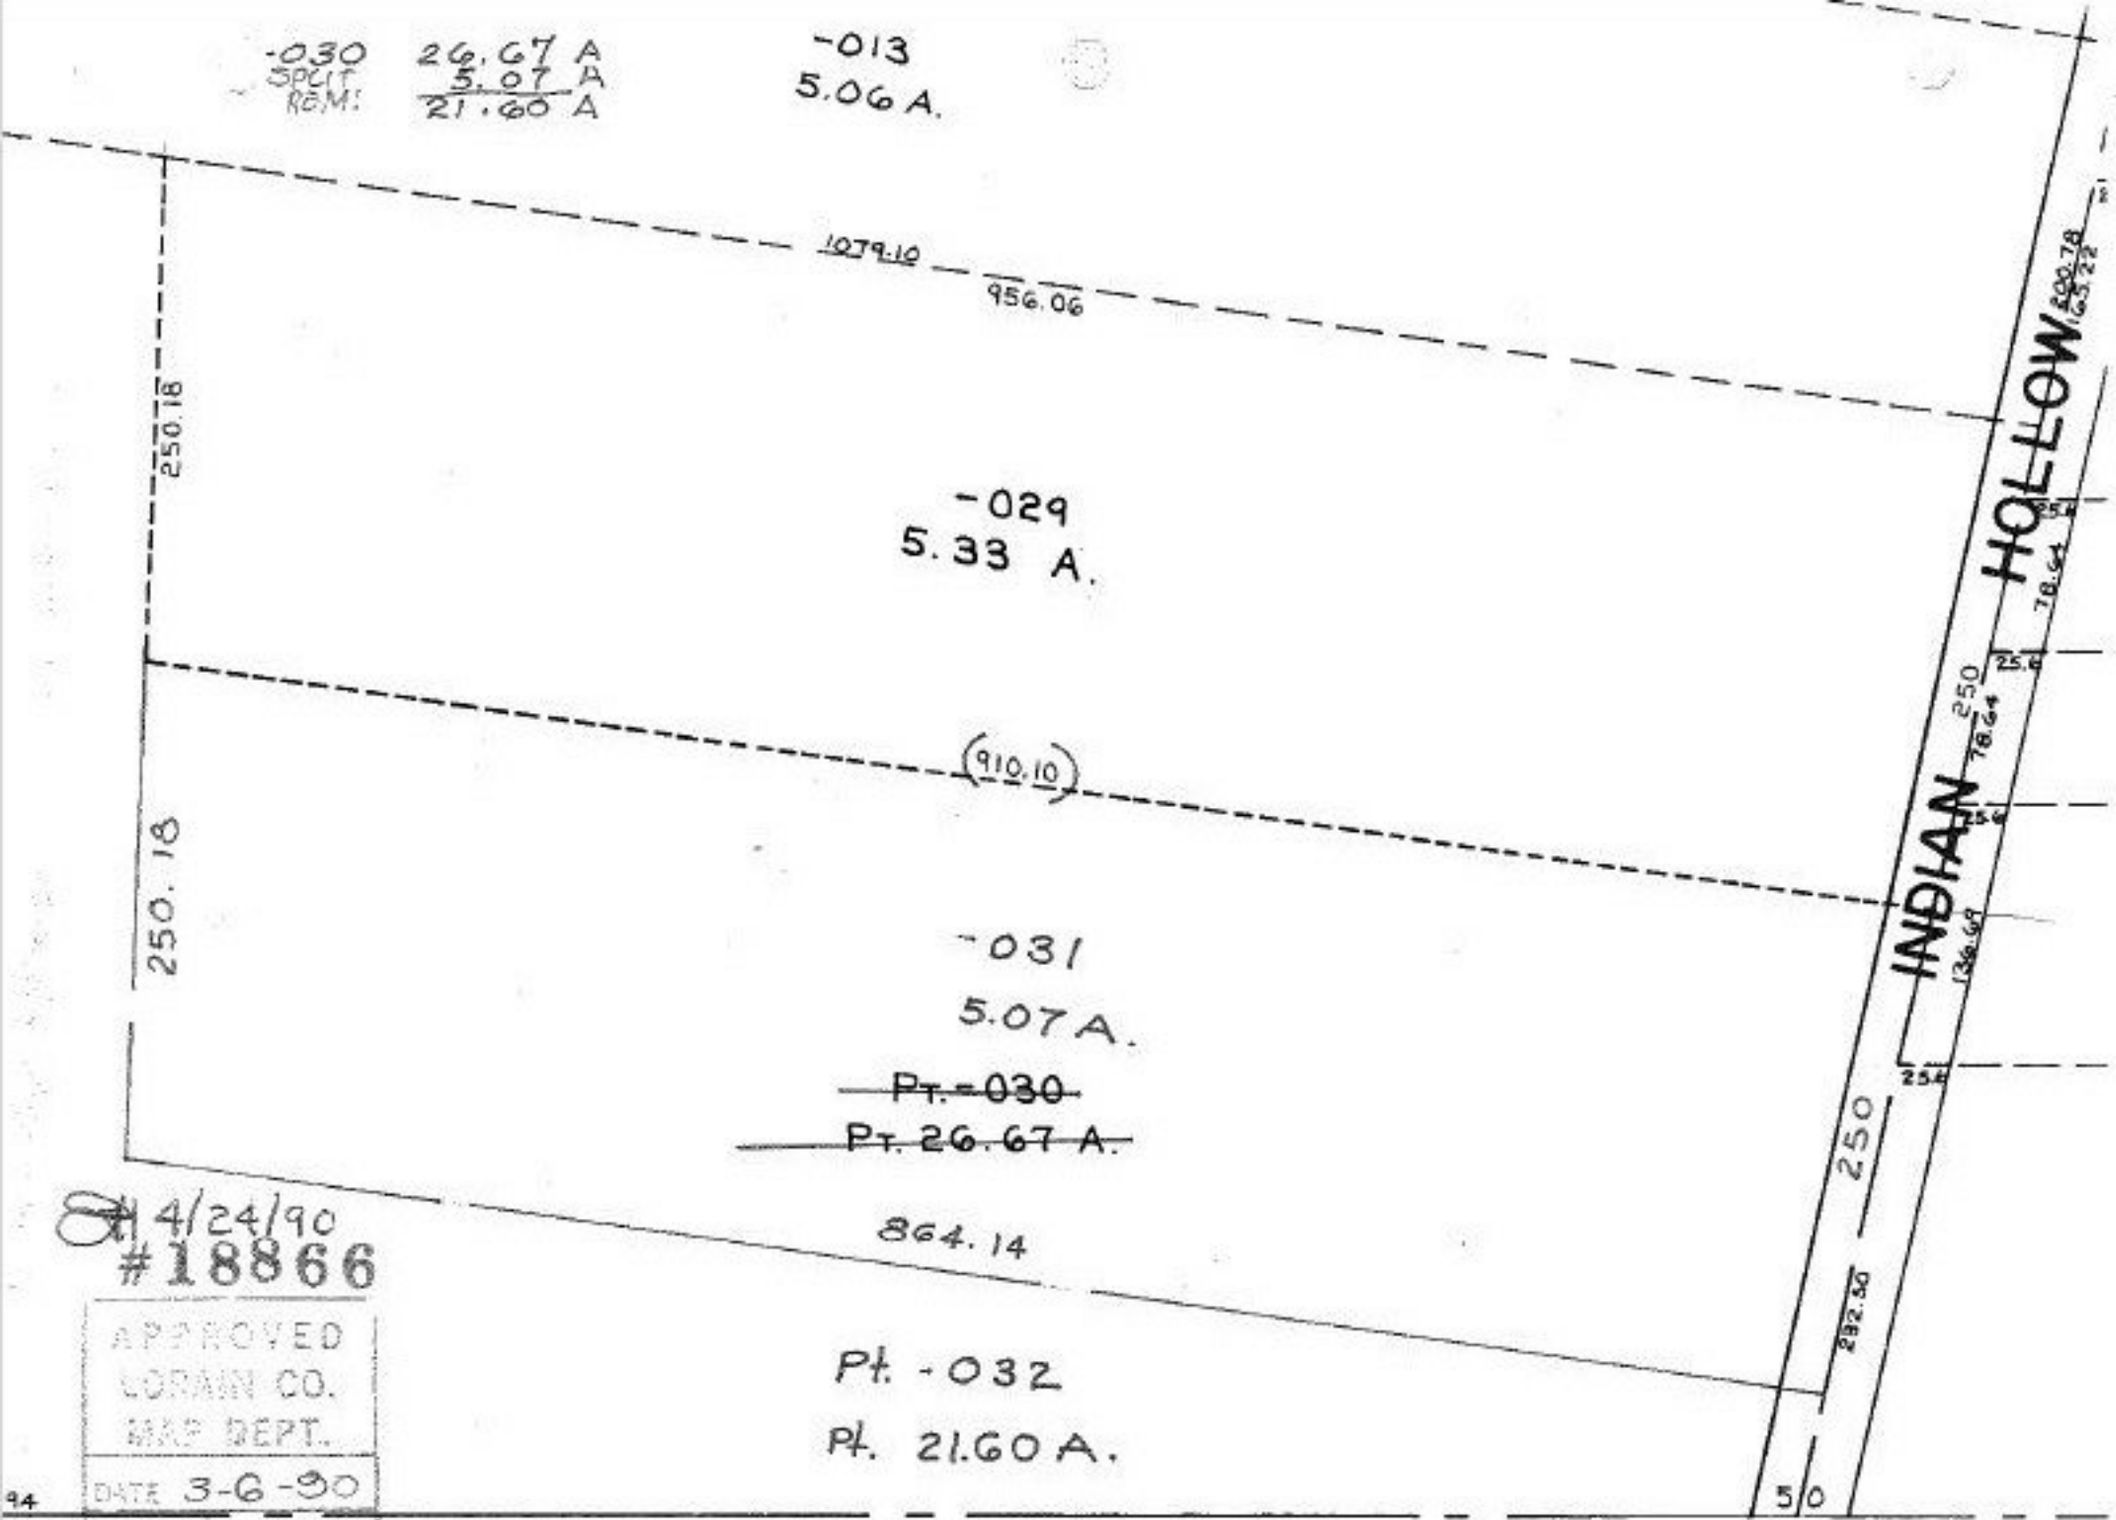

4/24/90
#18866

APPROVED
LORAIN CO.
MAP DEPT.
DATE 3-6-90
PAGE 15-00-073B
BY CAROLYN FRANCIS
VOID AFTER # 18866

15-00-073-000- PRIOR INST. OR.176/216 C=1:500,00.
SURVEYED BY: CARDINAL SURVEYS DOUG MOSLEY REG. SU.

SEE 15 - H