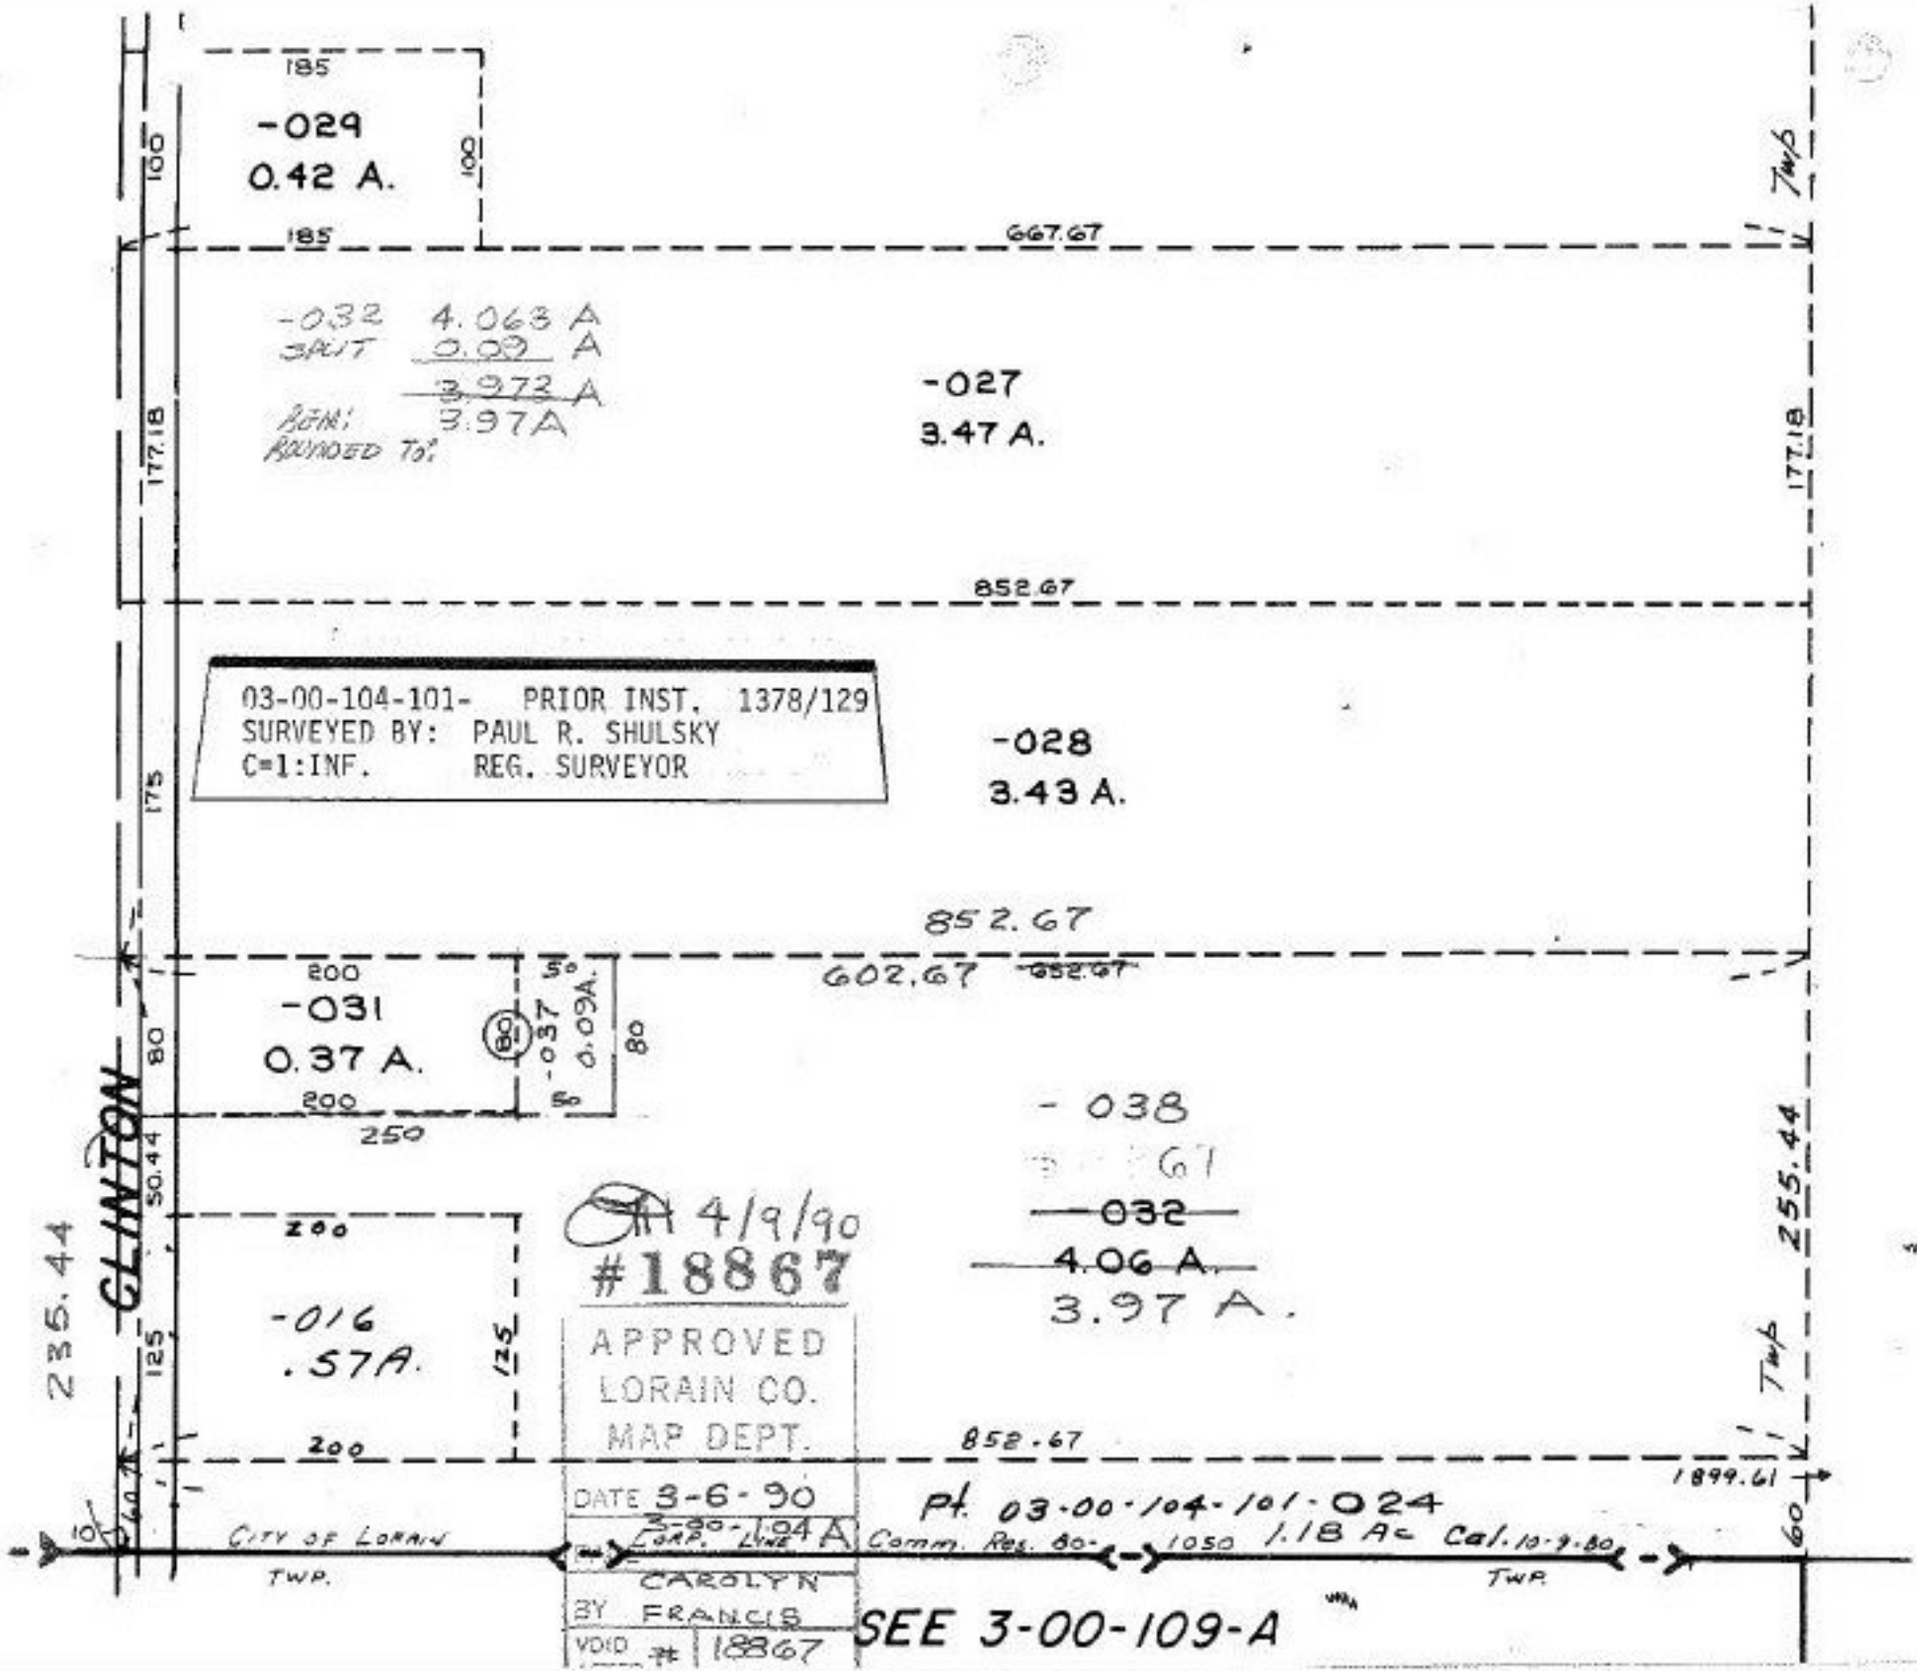
185
-029
0.42 A.
100
100
185
667.67
Twp 6
-032 4.063 A
PART 0.09 A
3.972 A
BEING BOUNDED TO: 3.97A
-027
3.47 A.
177.18
177.18
852.67
03-00-104-101- PRIOR INST. 1378/129
SURVEYED BY: PAUL R. SHULSKY
C=1:INF. REG. SURVEYOR
-028
3.43 A.
175
852.67
602.67
852.67
200
-031
0.37 A.
80
80
200
250
50
-037 0.09A.
50
80
- 038
- 67
-032
4.06 A.
3.97 A.
255.44
Twp 6
50.44
200
-016
.57A.
125
125
200
852.67
1899.61
60
235.44
CLINTON
4/9/90
#18867
APPROVED
LORAIN CO.
MAP DEPT.
DATE 3-6-90
3.00-1.94 A
CAROLYN
BY FRANCIS
VOID # 18867
Pt. 03-00-104-101-024
Comm. Reg. 80-1050 1.18 Ac Cal. 10-9-80
CITY OF LORAIN
TWP.
TWP.
SEE 3-00-109-A