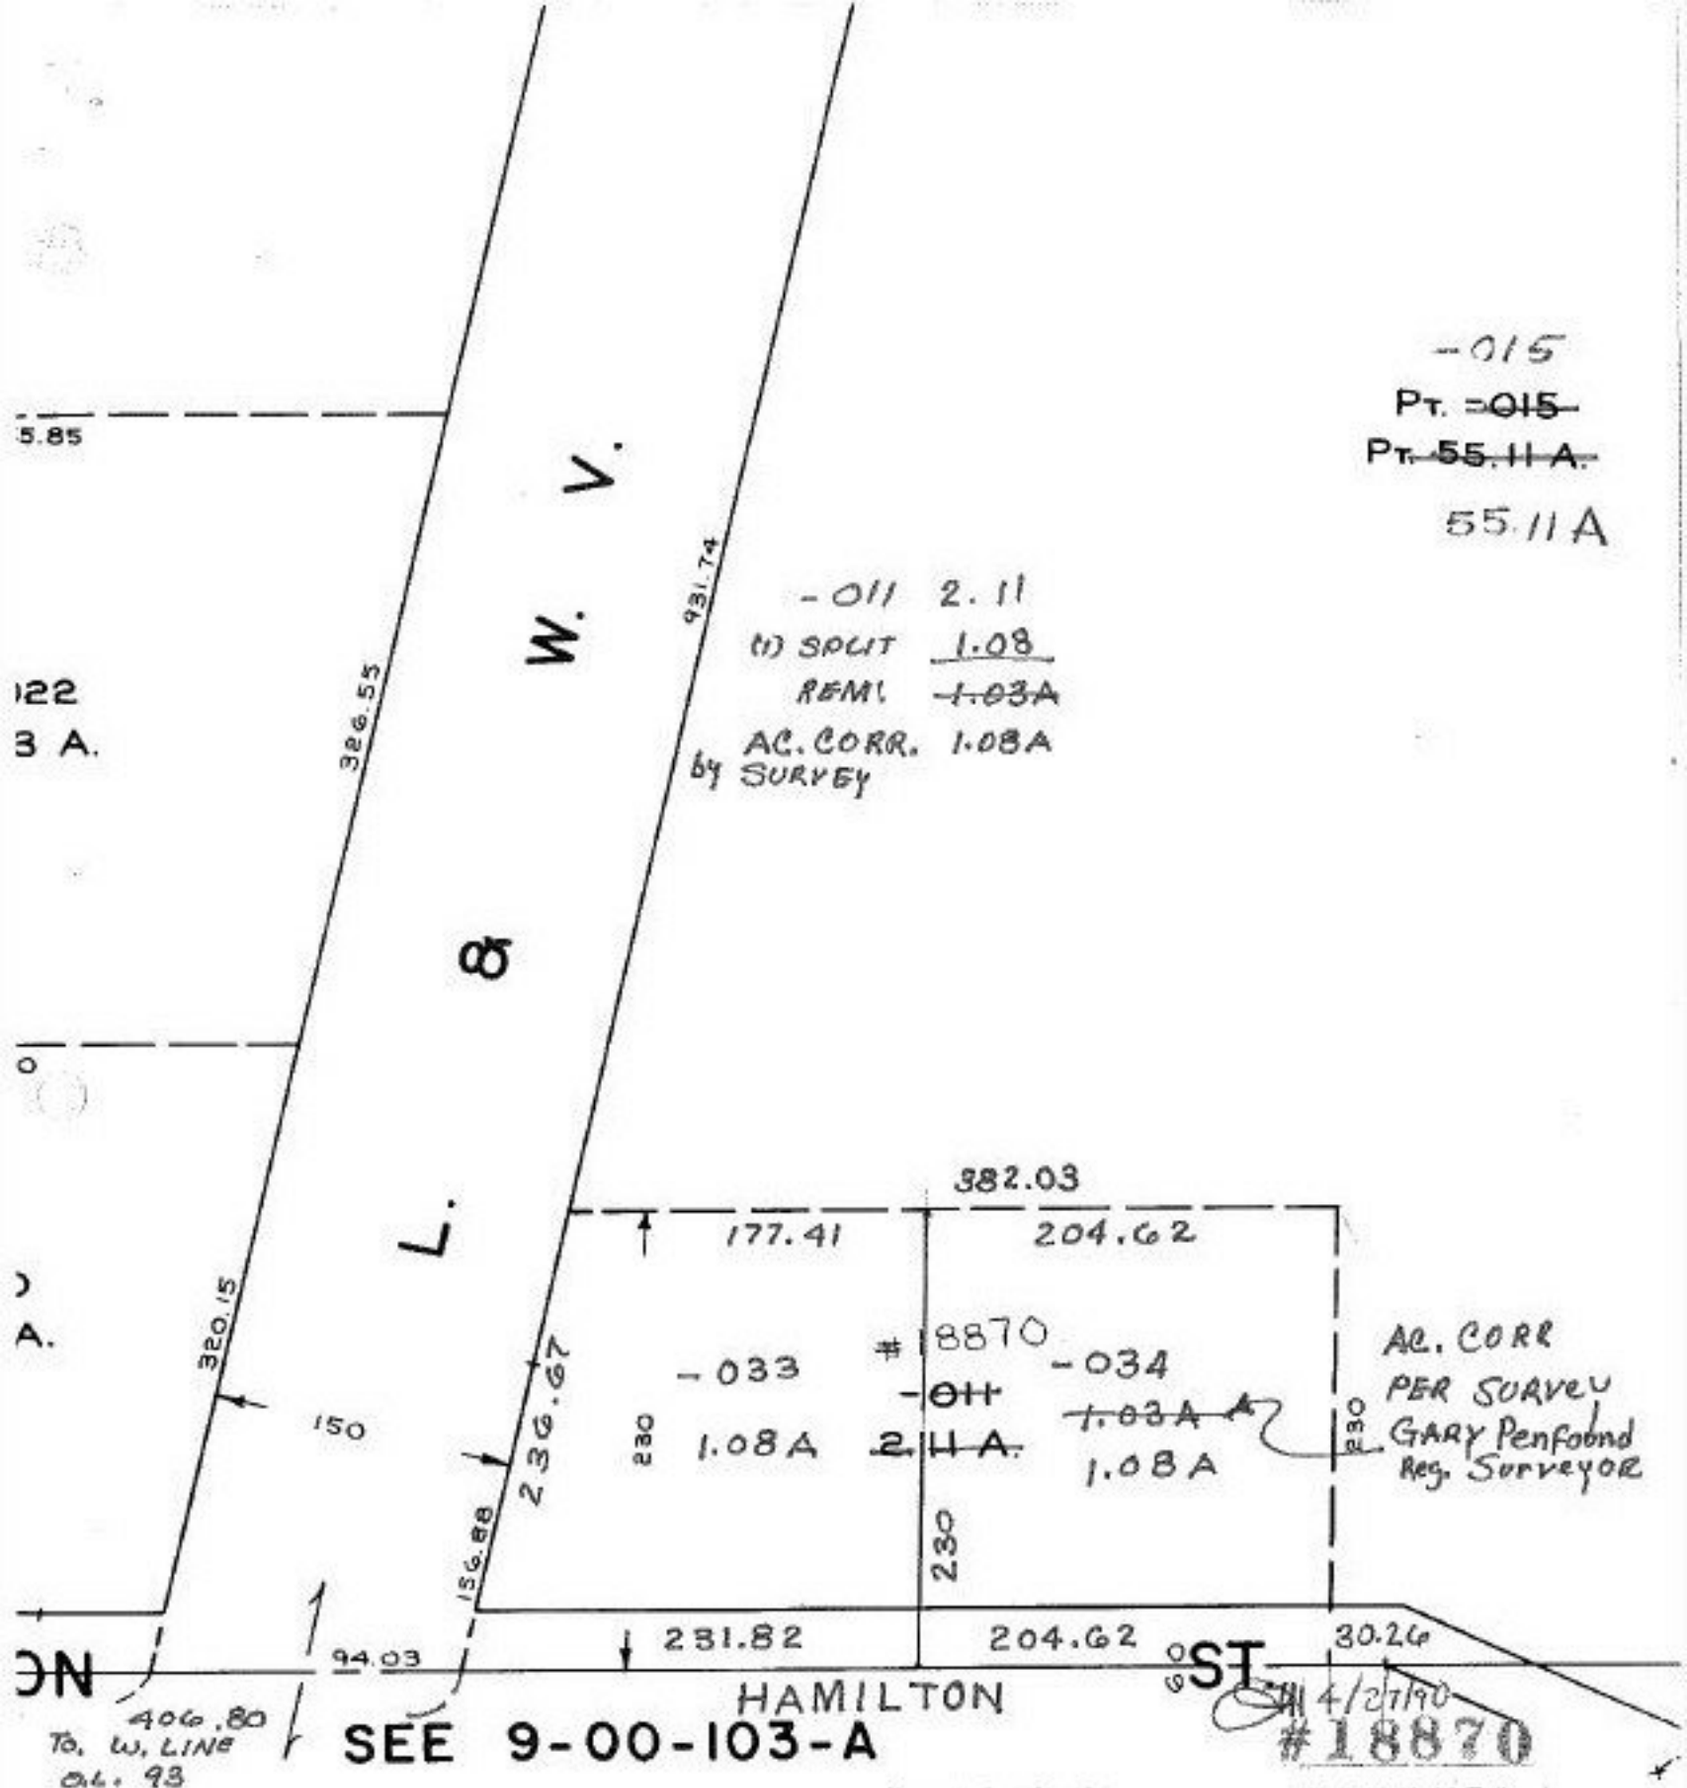

09-00-093-000- PRIOR INST. 172/874
SURVEYED BY: GARY E. PENFOUND REG. SURVEYOR
(1) C=1:125,000. (2) C=1:INF.

APPROVED
LORAIN CO.
MAP DEPT.
DATE 3-7-90
PAGE 9-00-093A
BY CAROLYN FRANCIS
VOID AFTER # 18870