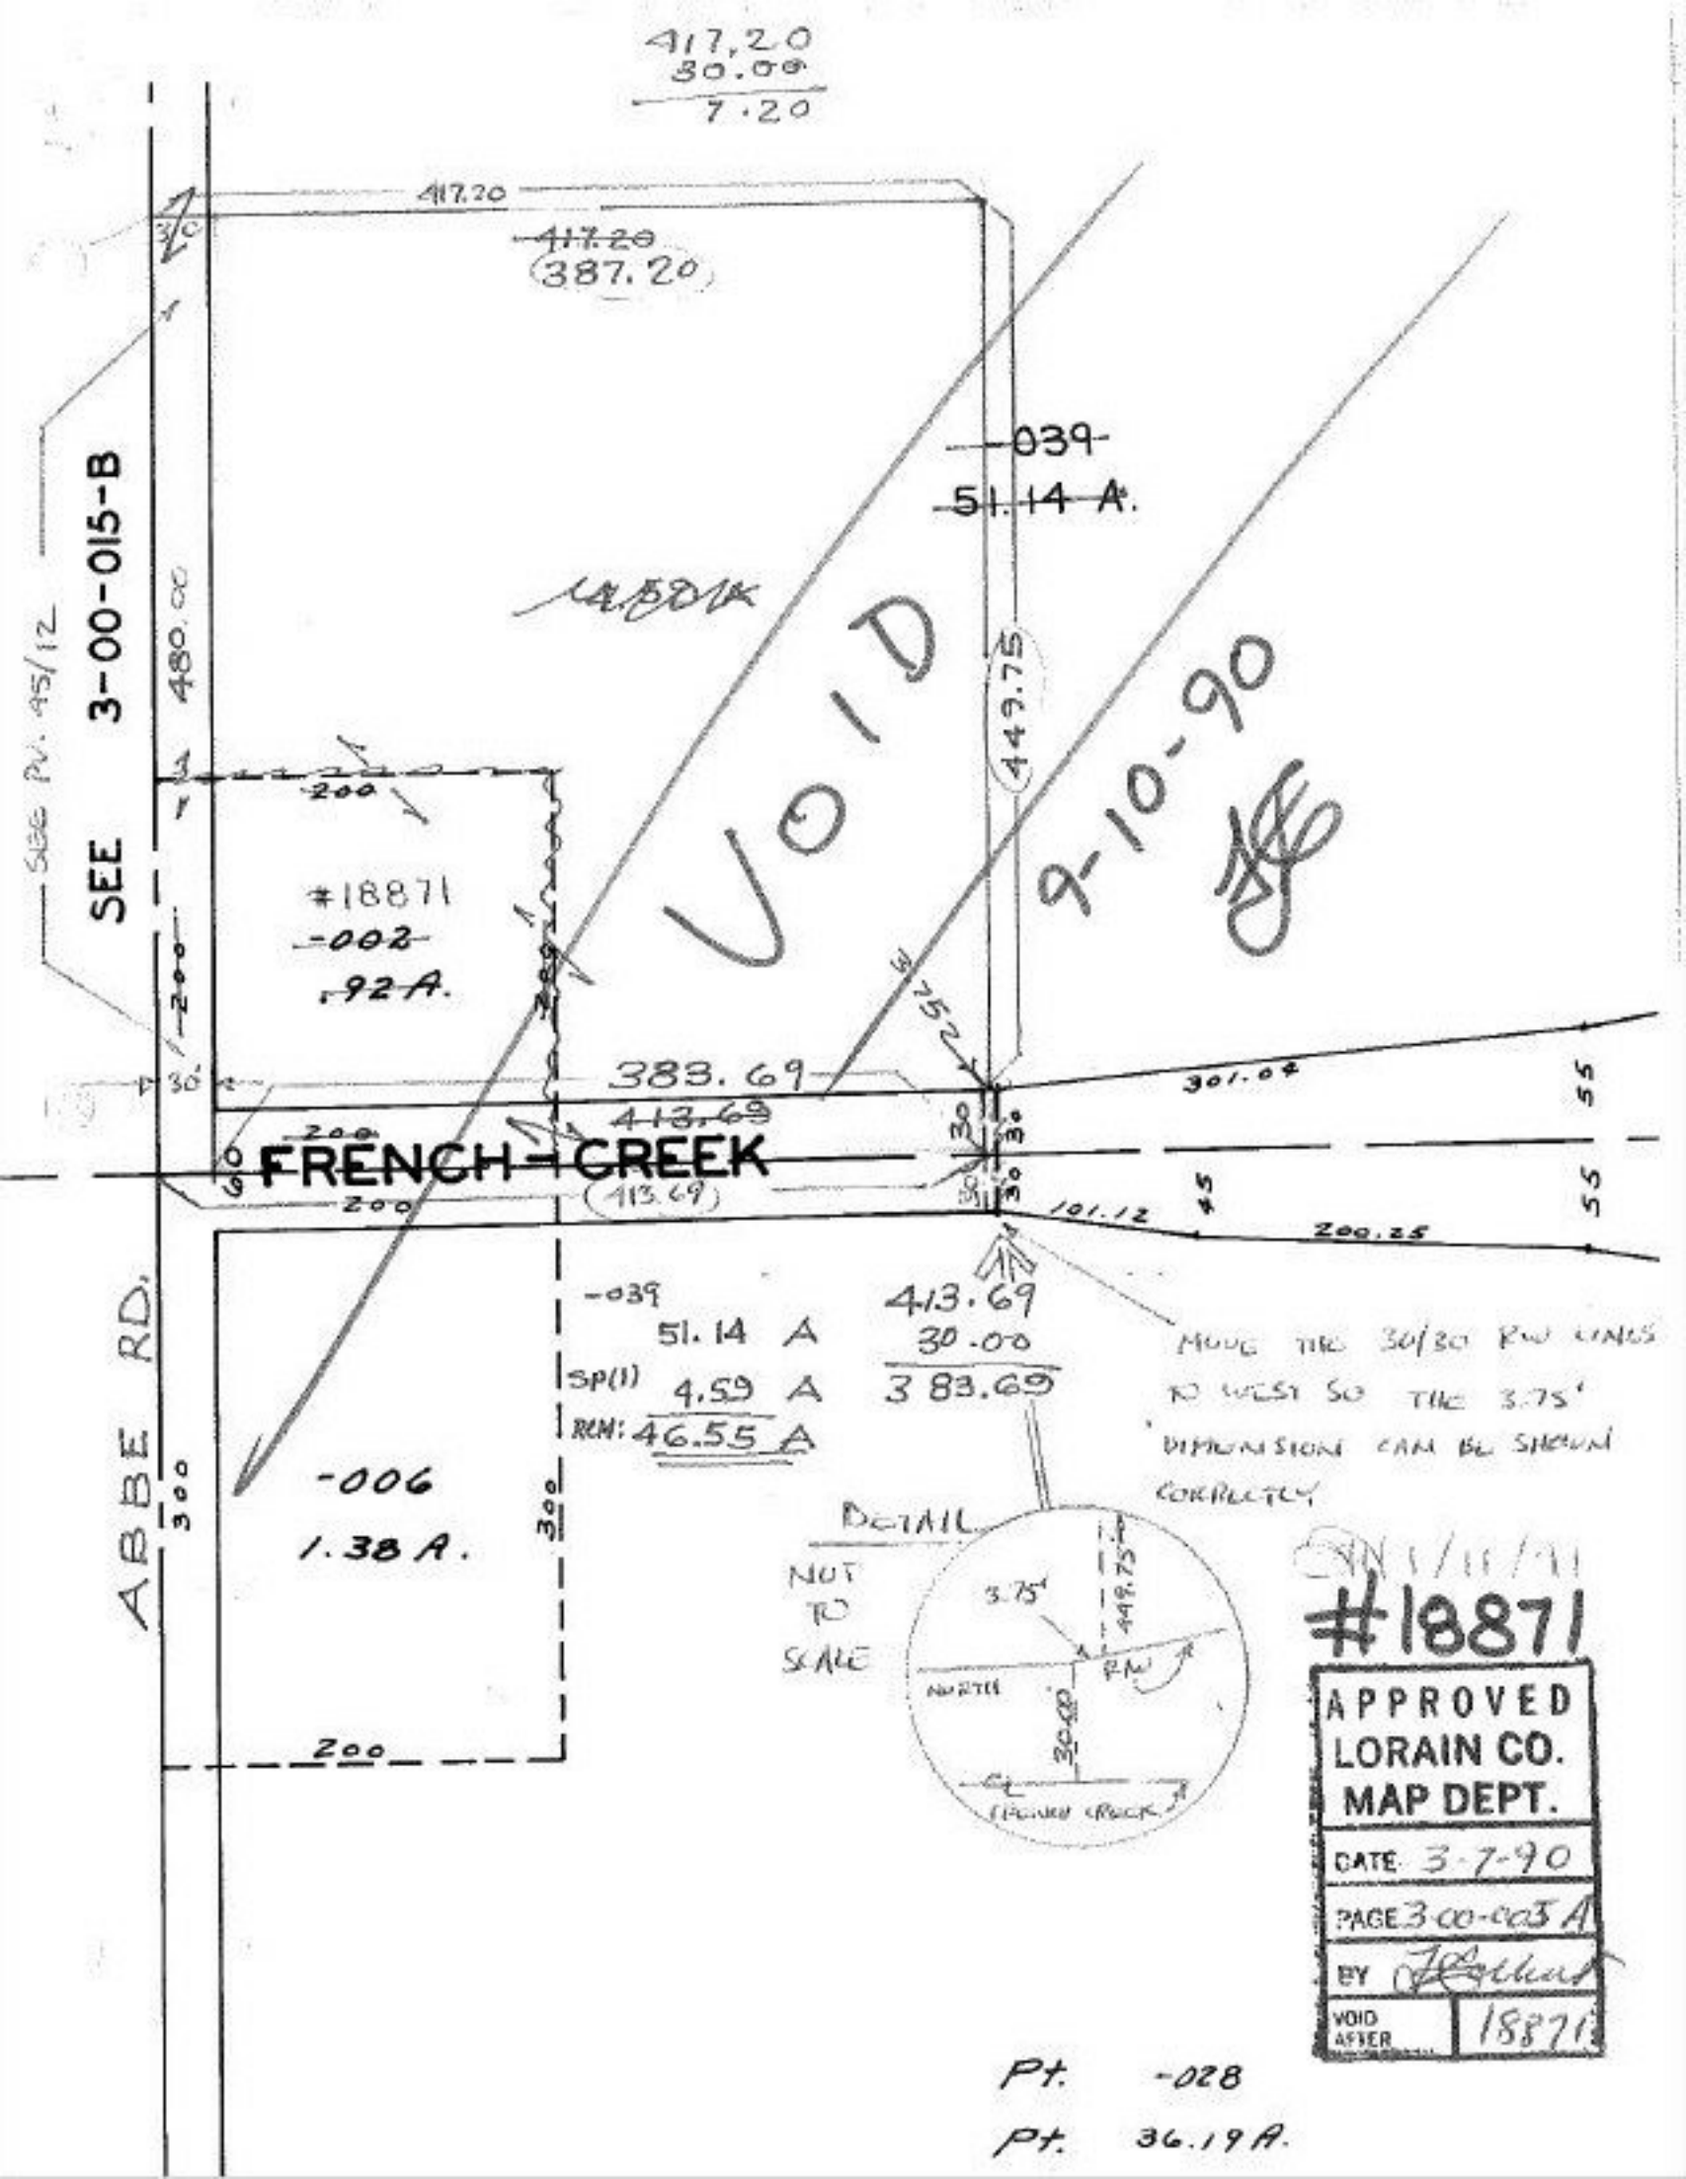
417.20
30.00
7.20
417.20
417.20
387.20
SEE 3-00-015-B
SEE PV. 95/12
480.00
-039-
51.14 A.
MAP
VOID
9-10-90
449.75
#18871
-002-
.92A.
200
200
383.69
413.69
301.04
FRENCH-CREEK
(413.69)
30
30
30
30
55
55
45
101.12
200.25
200
200
ABBE RD.
300
300
-039
51.14 A
SP(1) 4.59 A
RM: 46.55 A
413.69
30.00
383.69
-006
1.38 A.
200
MOVE THE 30/30 RW LINES TO WEST SO THE 3.75' DIMENSION CAN BE SHOWN CORRECTLY
DETAIL
NOT TO SCALE
3.75'
449.75'
RW
NORTH
30.00'
CENTER ROCK
#18871
APPROVED
LORAIN CO.
MAP DEPT.
DATE 3-7-90
PAGE 3-00-003 A
BY
VOID AFTER
18871
Pt. -028
Pt. 36.19 A.