01-00-053-000- PRIOR INST. OR181/633 surveyed by: MICHAEL G. HURA
C=1: INF. REG. SURVEYOR
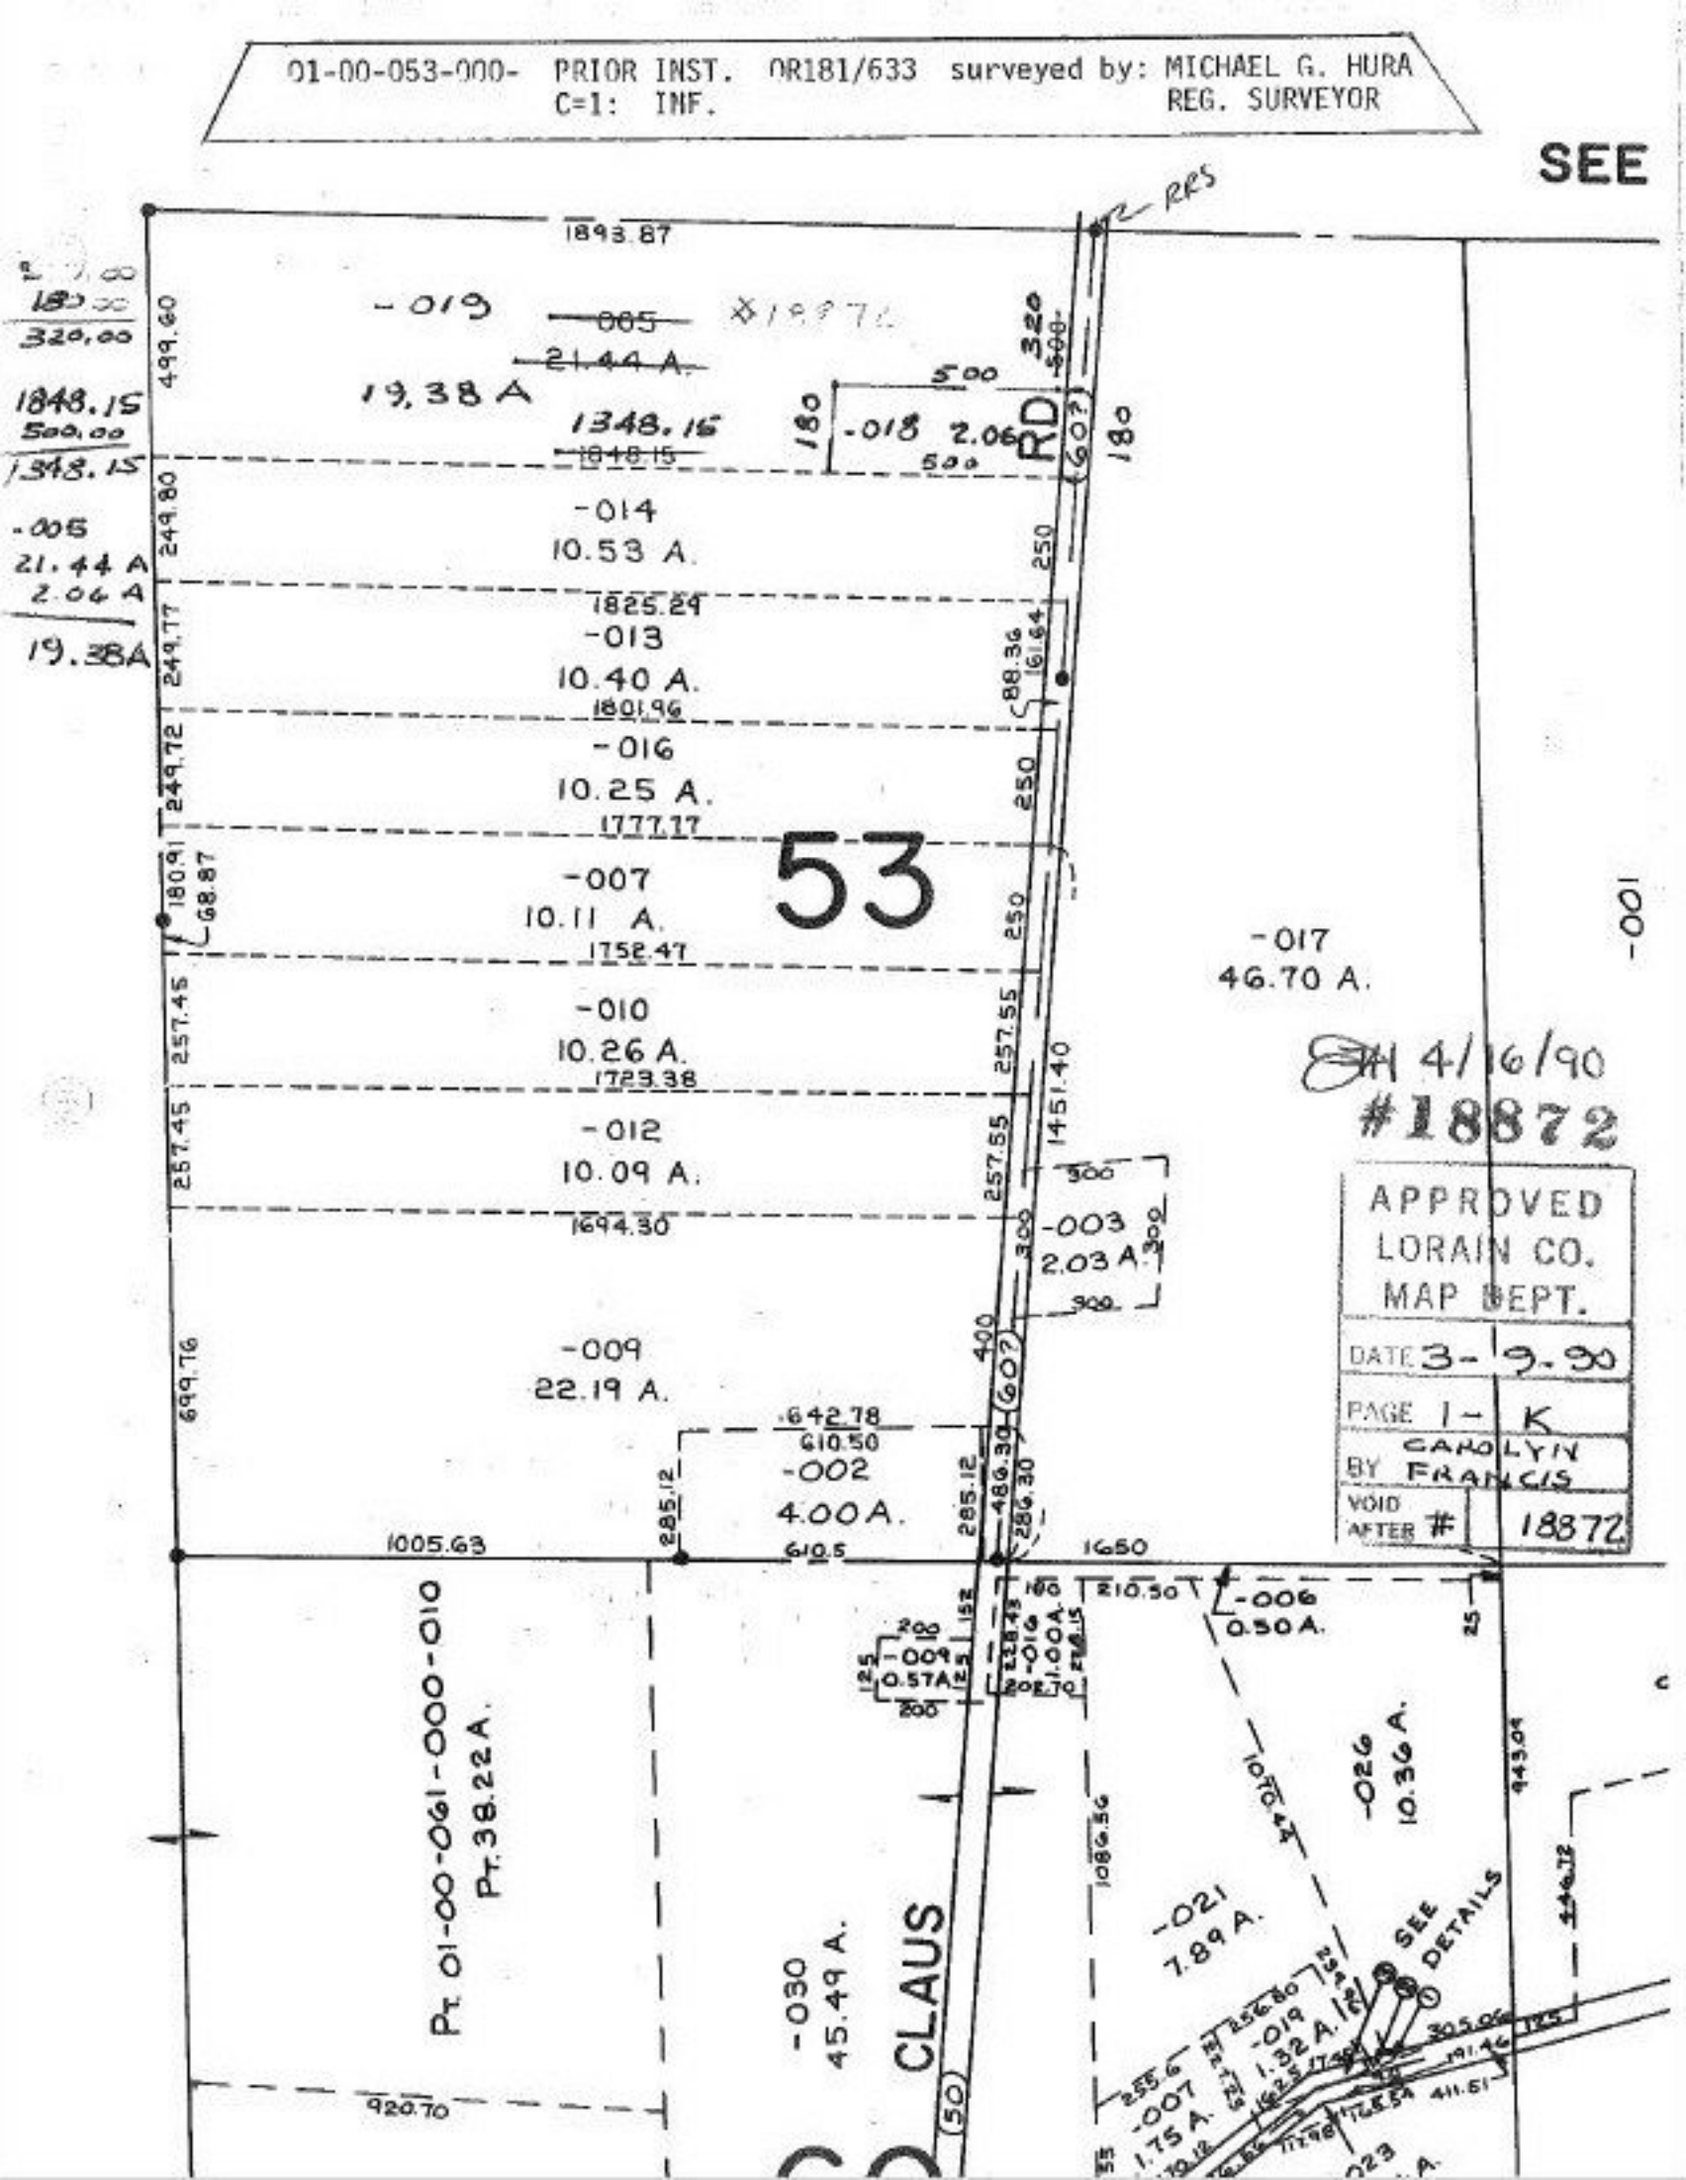
SEE