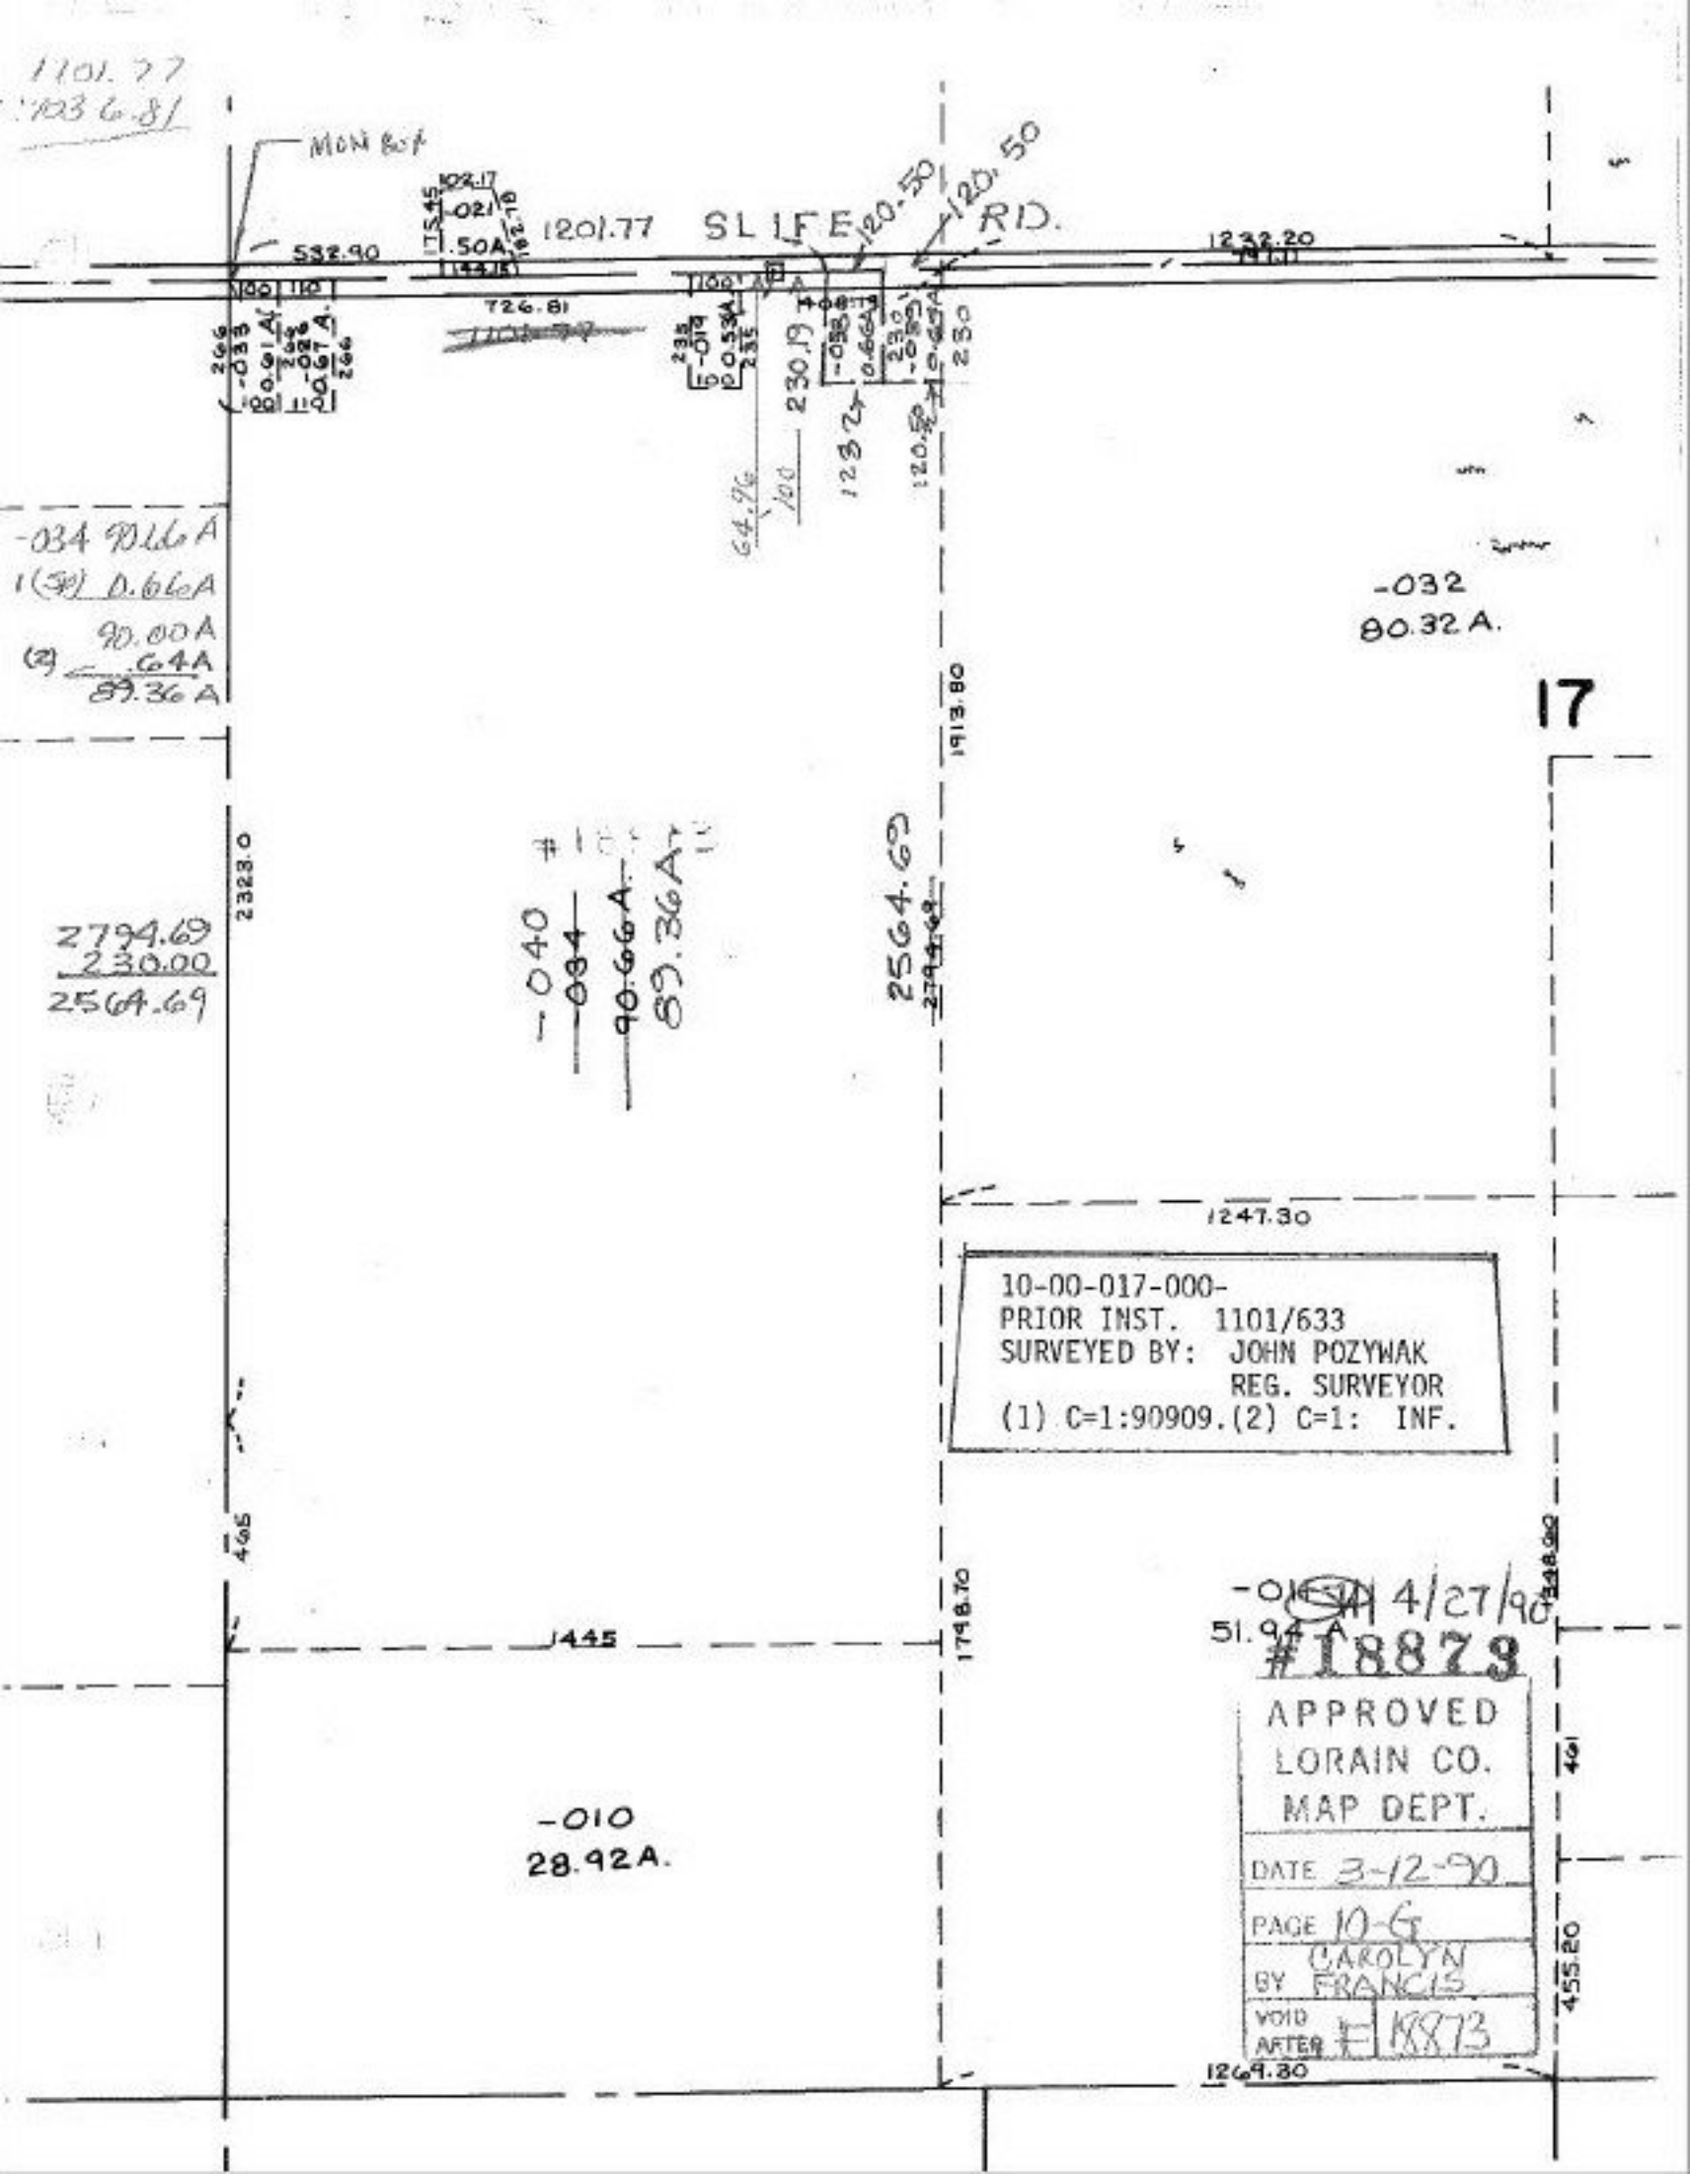
1101.77
1036.81
MON BOX
1201.77
SLIFE RD.
120.50
120.50
532.90
1232.20
726.81
230.19
64.96
100
-034 90.66A
1(50) 0.66A
90.00A
(2) .64A
89.36A
-032
80.32A.
17
1913.80
2323.0
2794.69
230.00
2564.69
-040
-034
90.66A
89.36A
2564.69
1247.30
10-00-017-000-
PRIOR INST. 1101/633
SURVEYED BY: JOHN POZYWAK
REG. SURVEYOR
(1) C=1:90909.(2) C=1: INF.
465
1445
1798.70
-01
51.94A
4/27/90
#18873
APPROVED
LORAIN CO.
MAP DEPT.
DATE 3-12-90
PAGE 10-G
BY CAROLYN FRANCIS
VOID AFTER 18873
461
455.20
1269.30
-010
28.92A.