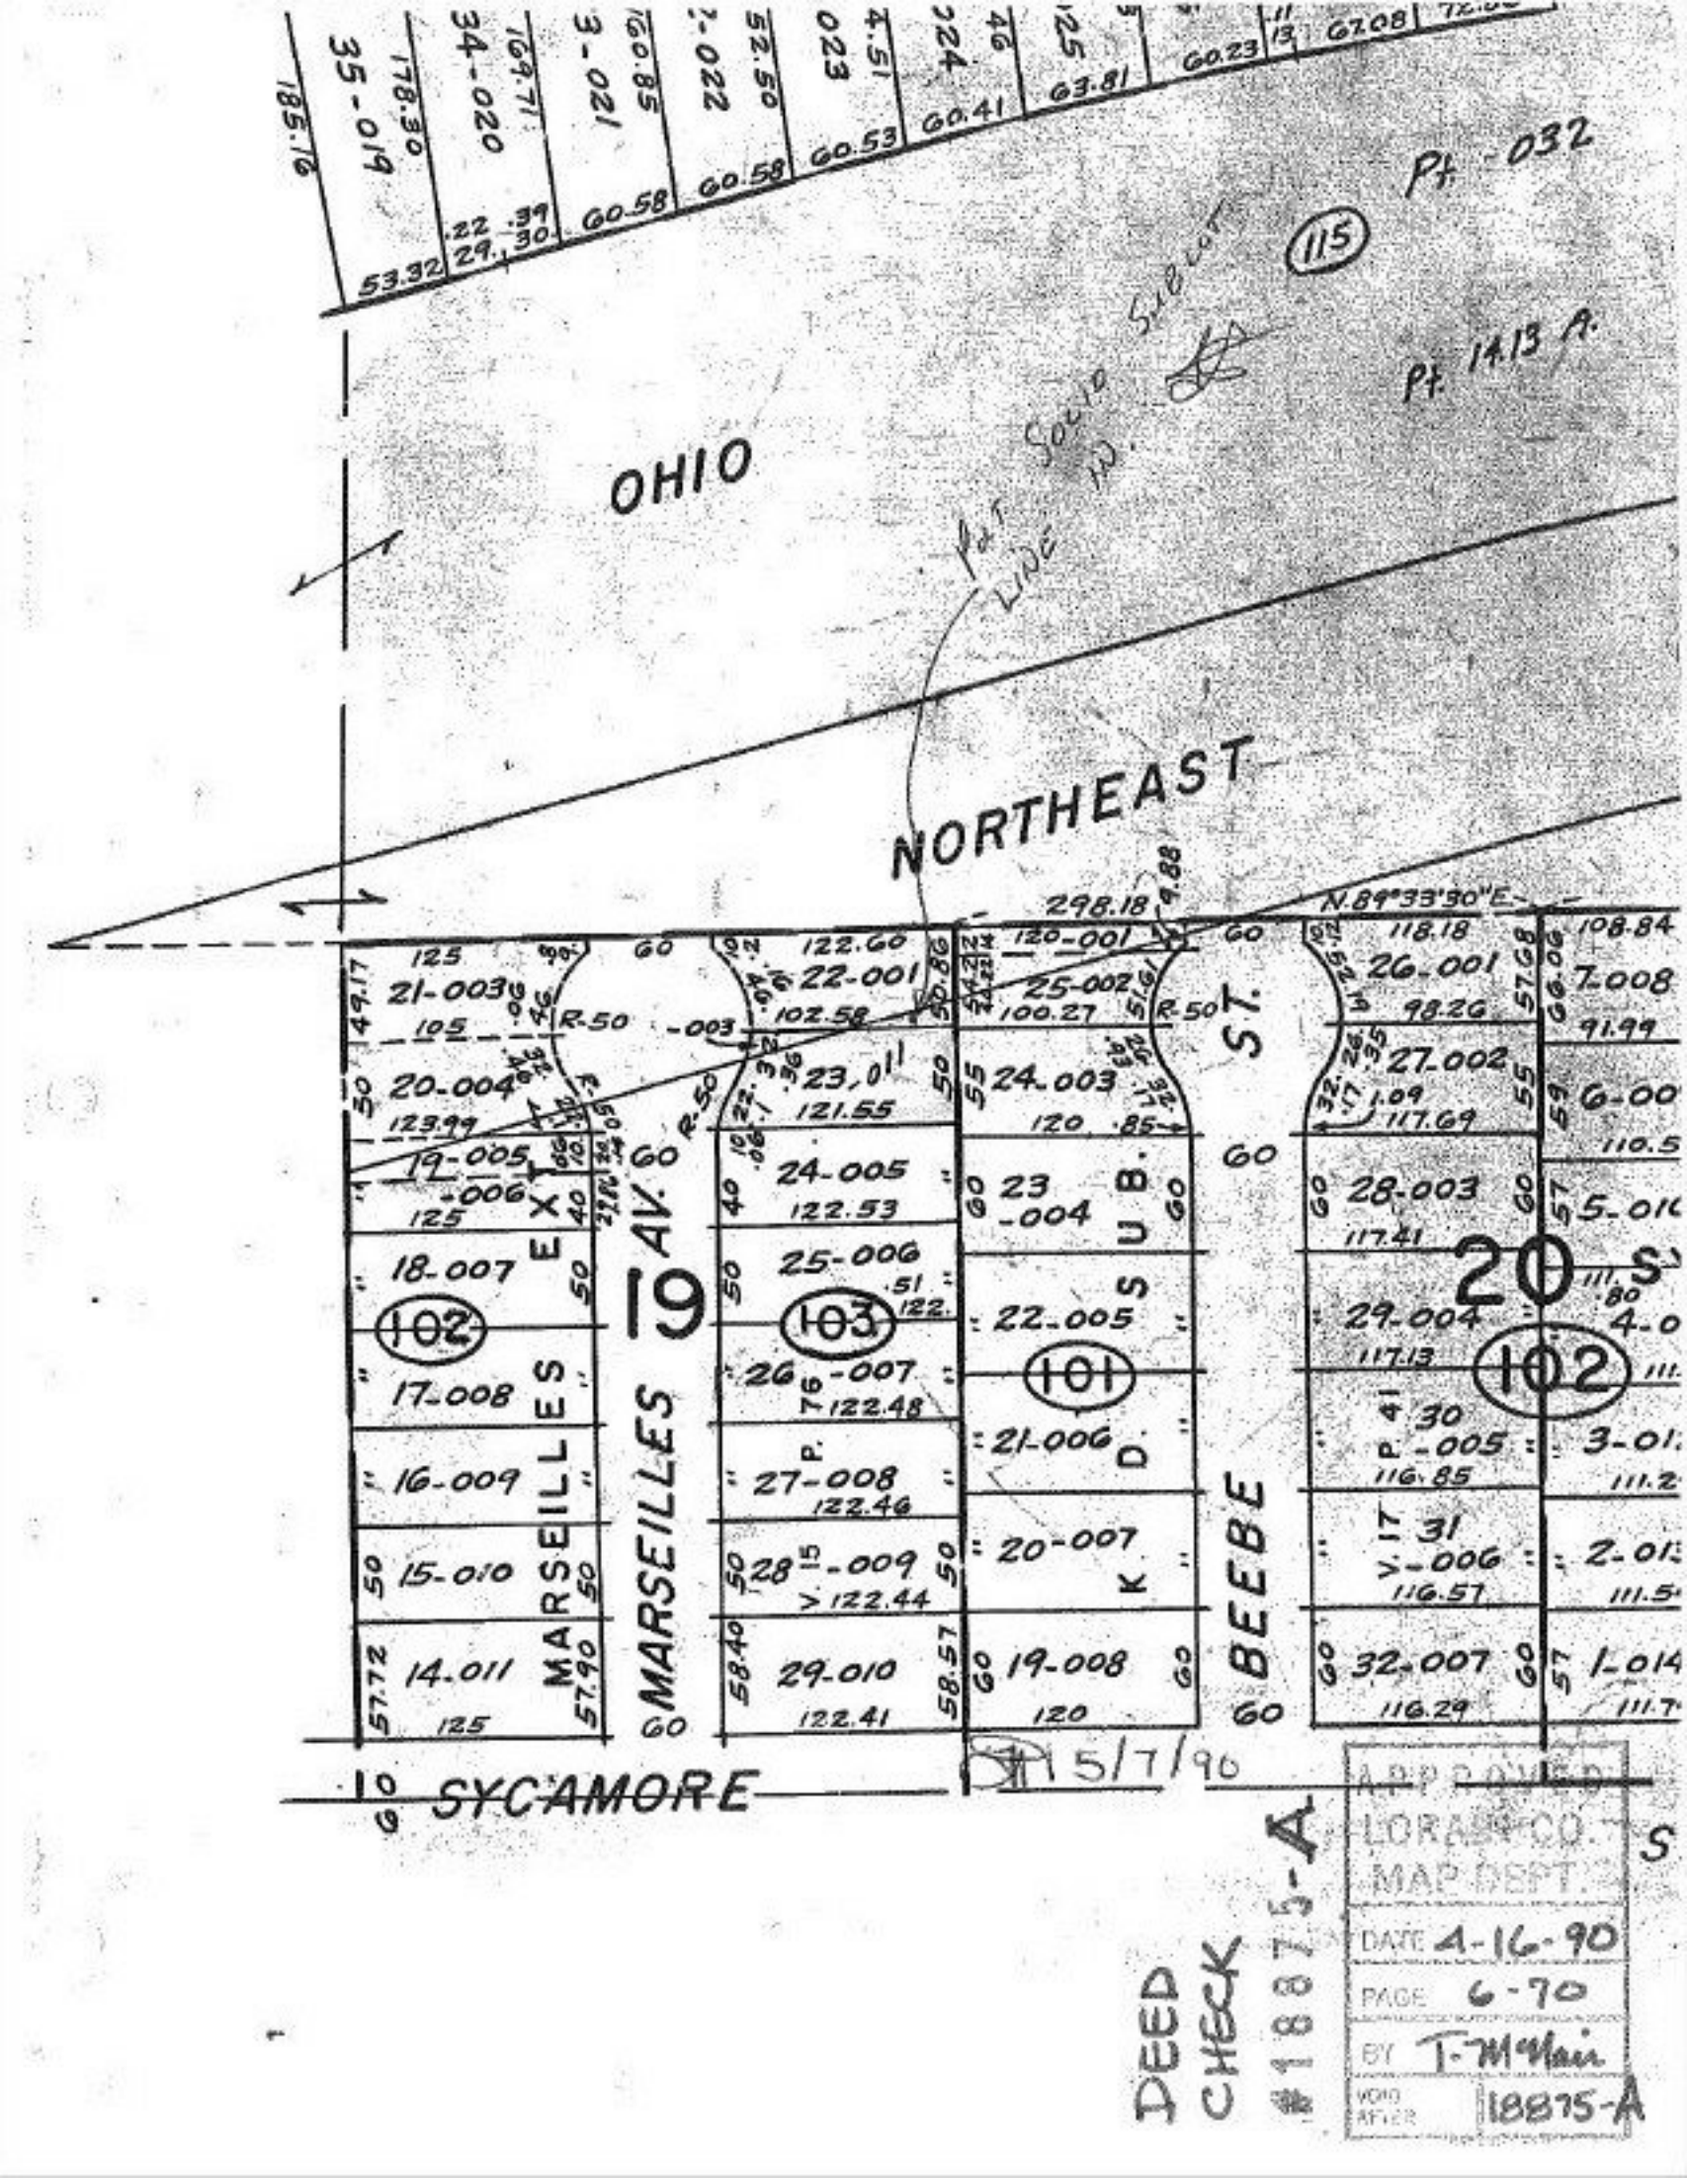
OHIO
NORTHEAST
Pt. 032
Pt. 14.13 A.
115
Part Line
MARSEILLES AV.
MARSEILLES E
BEEBE ST.
SUB. D
SUB. K
SUB. V.17
SYCAMORE
102
103
101
102
20
19
N.89°33'30"E.
298.18
5/7/90
APPROVED
LORAIN CO.
MAP DEPT.
DATE 4-16-90
PAGE 6-70
BY T-M Main
VOID AFTER
DEED CHECK #18875-A
18875-A