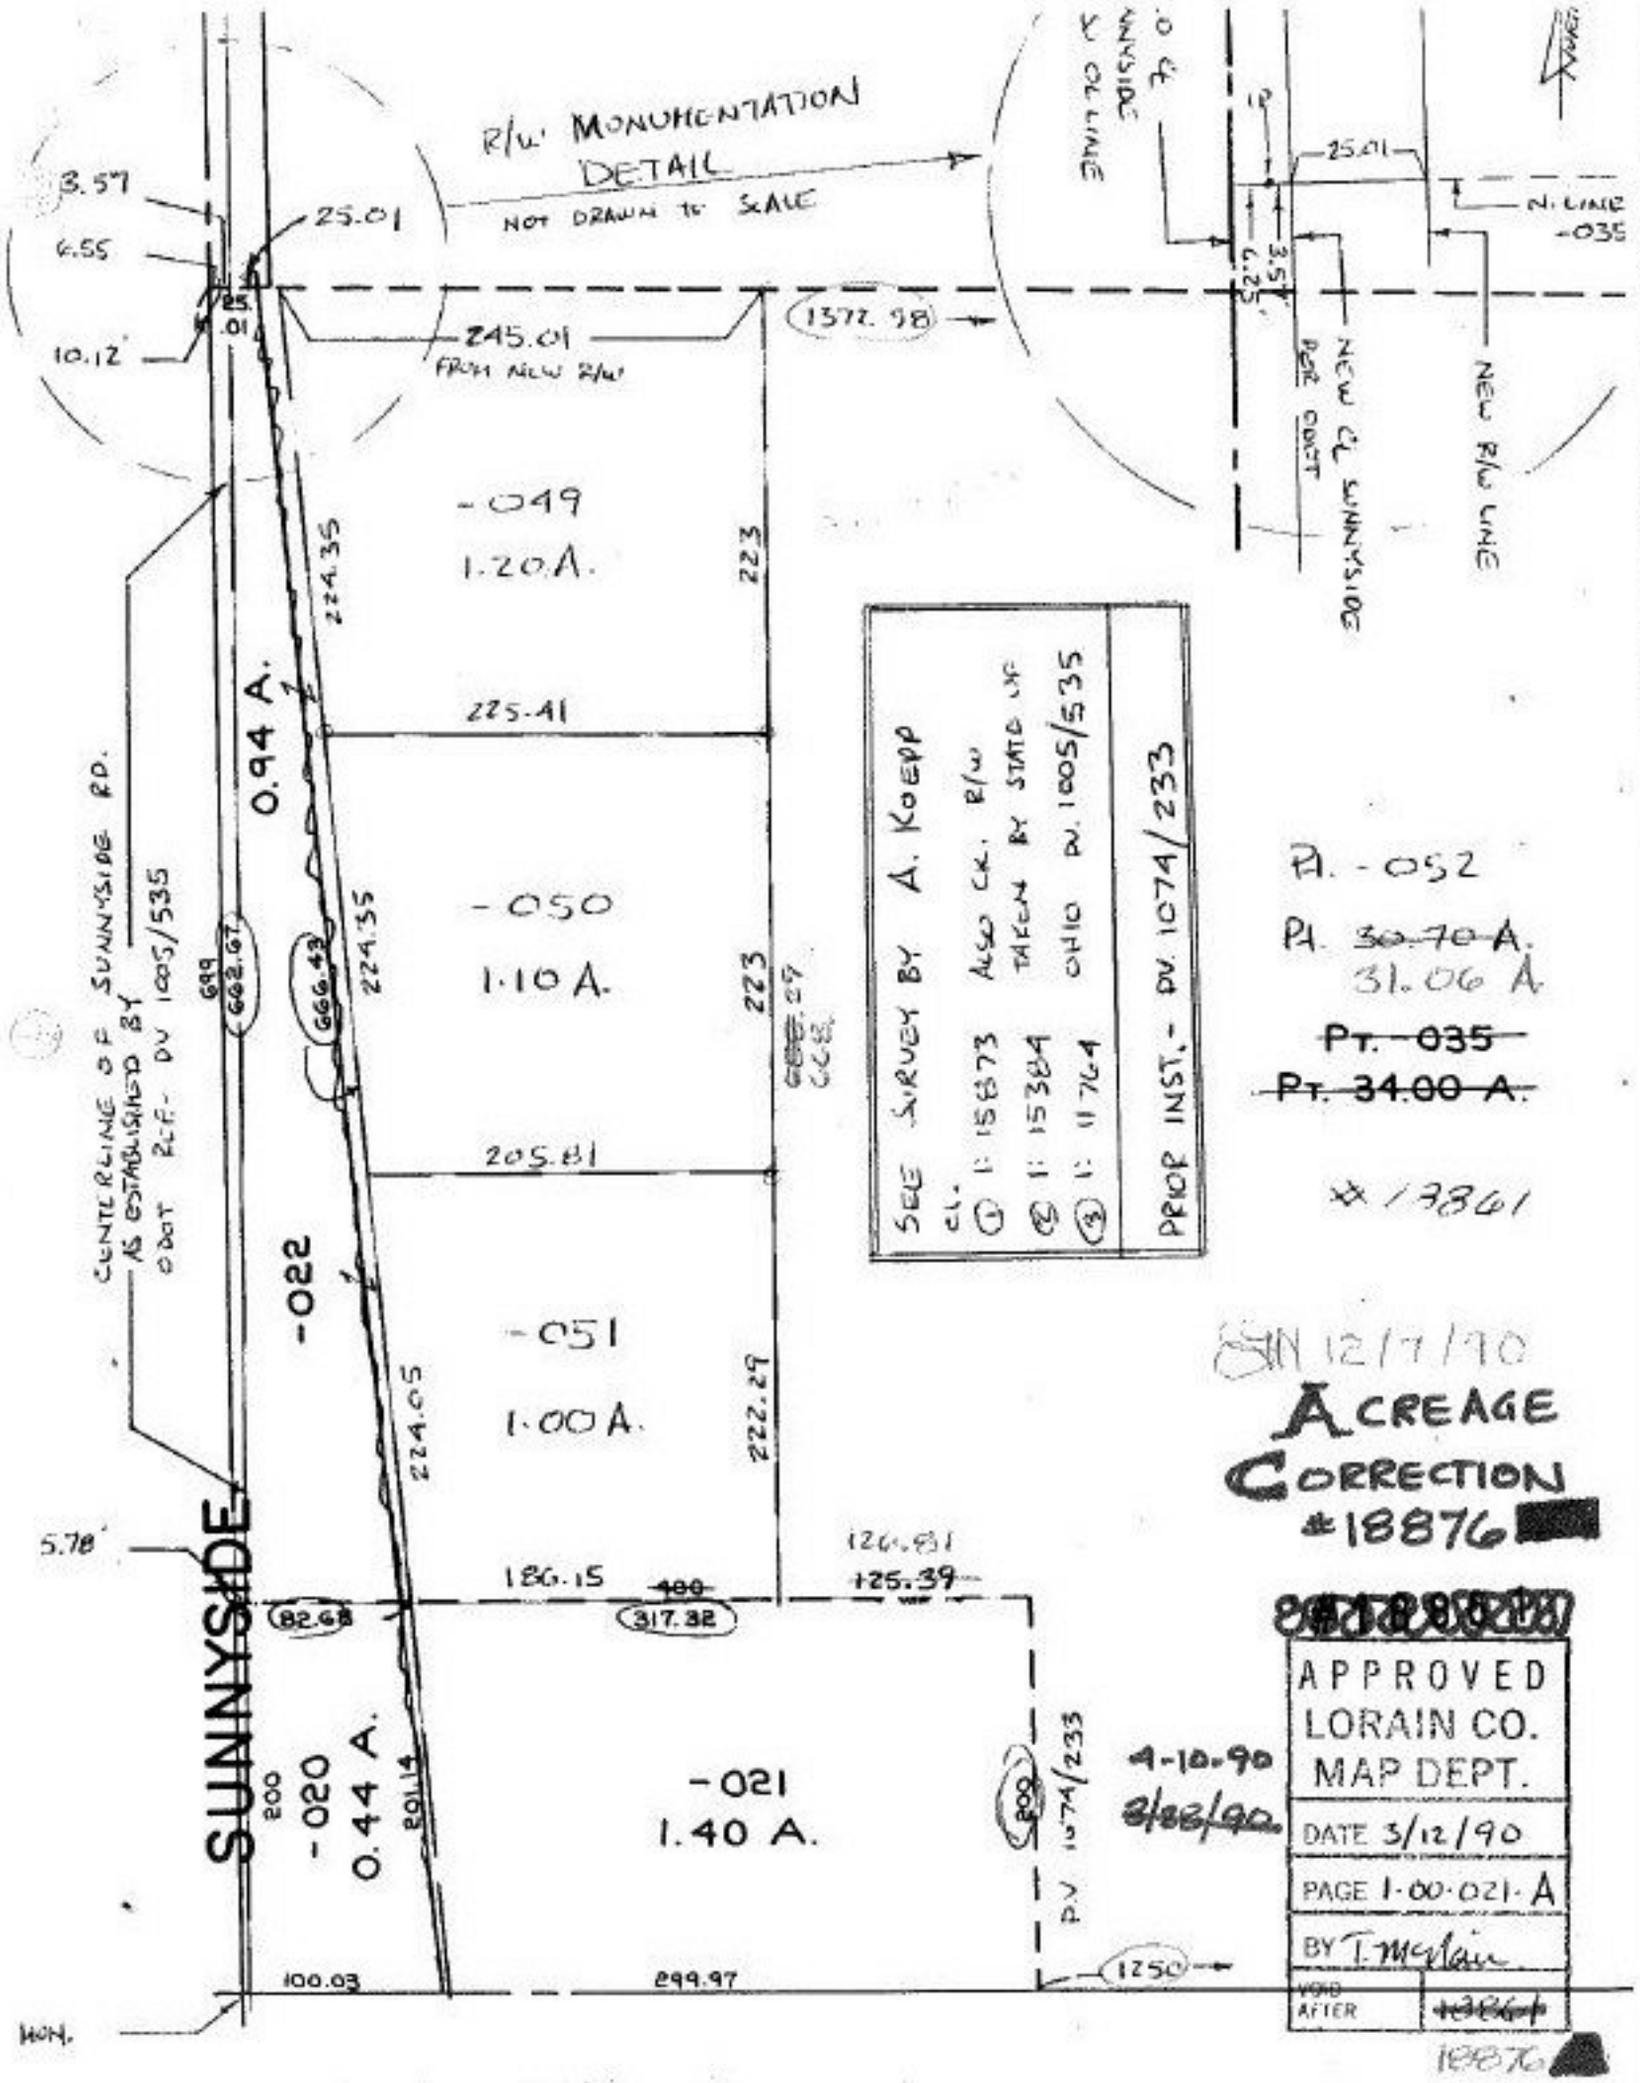
R/W MONUMENTATION DETAIL
NOT DRAWN TO SCALE
3.57
6.55
10.12
25.01
245.01
FROM NEW R/W
1372.98
25.01
N. LINE -035
NEW CL SUNNYSIDE PER ODOT
NEW R/W LINE
-049
1.20 A.
224.35
223
225.41
0.94 A.
-050
1.10 A.
224.35
223
205.81
-022
-051
1.00 A.
224.05
222.29
CENTERLINE OF SUNNYSIDE RD. AS ESTABLISHED BY ODOT REF. DV 1005/535
699
662.67
666.43
SUNNYSIDE
5.78
186.15
400
317.32
126.81
125.39
82.68
-020
0.44 A.
200
201.14
-021
1.40 A.
200
DV 1074/233
100.03
299.97
1250
MON.
SEE SURVEY BY A. KOEPP
CL.
1 1: 15873 ALSO CK. R/W
2 1: 15384 TAKEN BY STATE OF
3 1: 11764 OHIO DV. 1005/535
PRIOR INST. - DV. 1074/233
Pt. -052
Pt. ~~30.70 A.~~
31.06 A
~~Pt. -035~~
~~Pt. 34.00 A.~~
#13861
SJN 12/7/90
ACREAGE CORRECTION
#18876
4-10-90
3/28/90
APPROVED
LORAIN CO.
MAP DEPT.
DATE 3/12/90
PAGE 1-00-021-A
BY T. McClain
VOID AFTER
18876