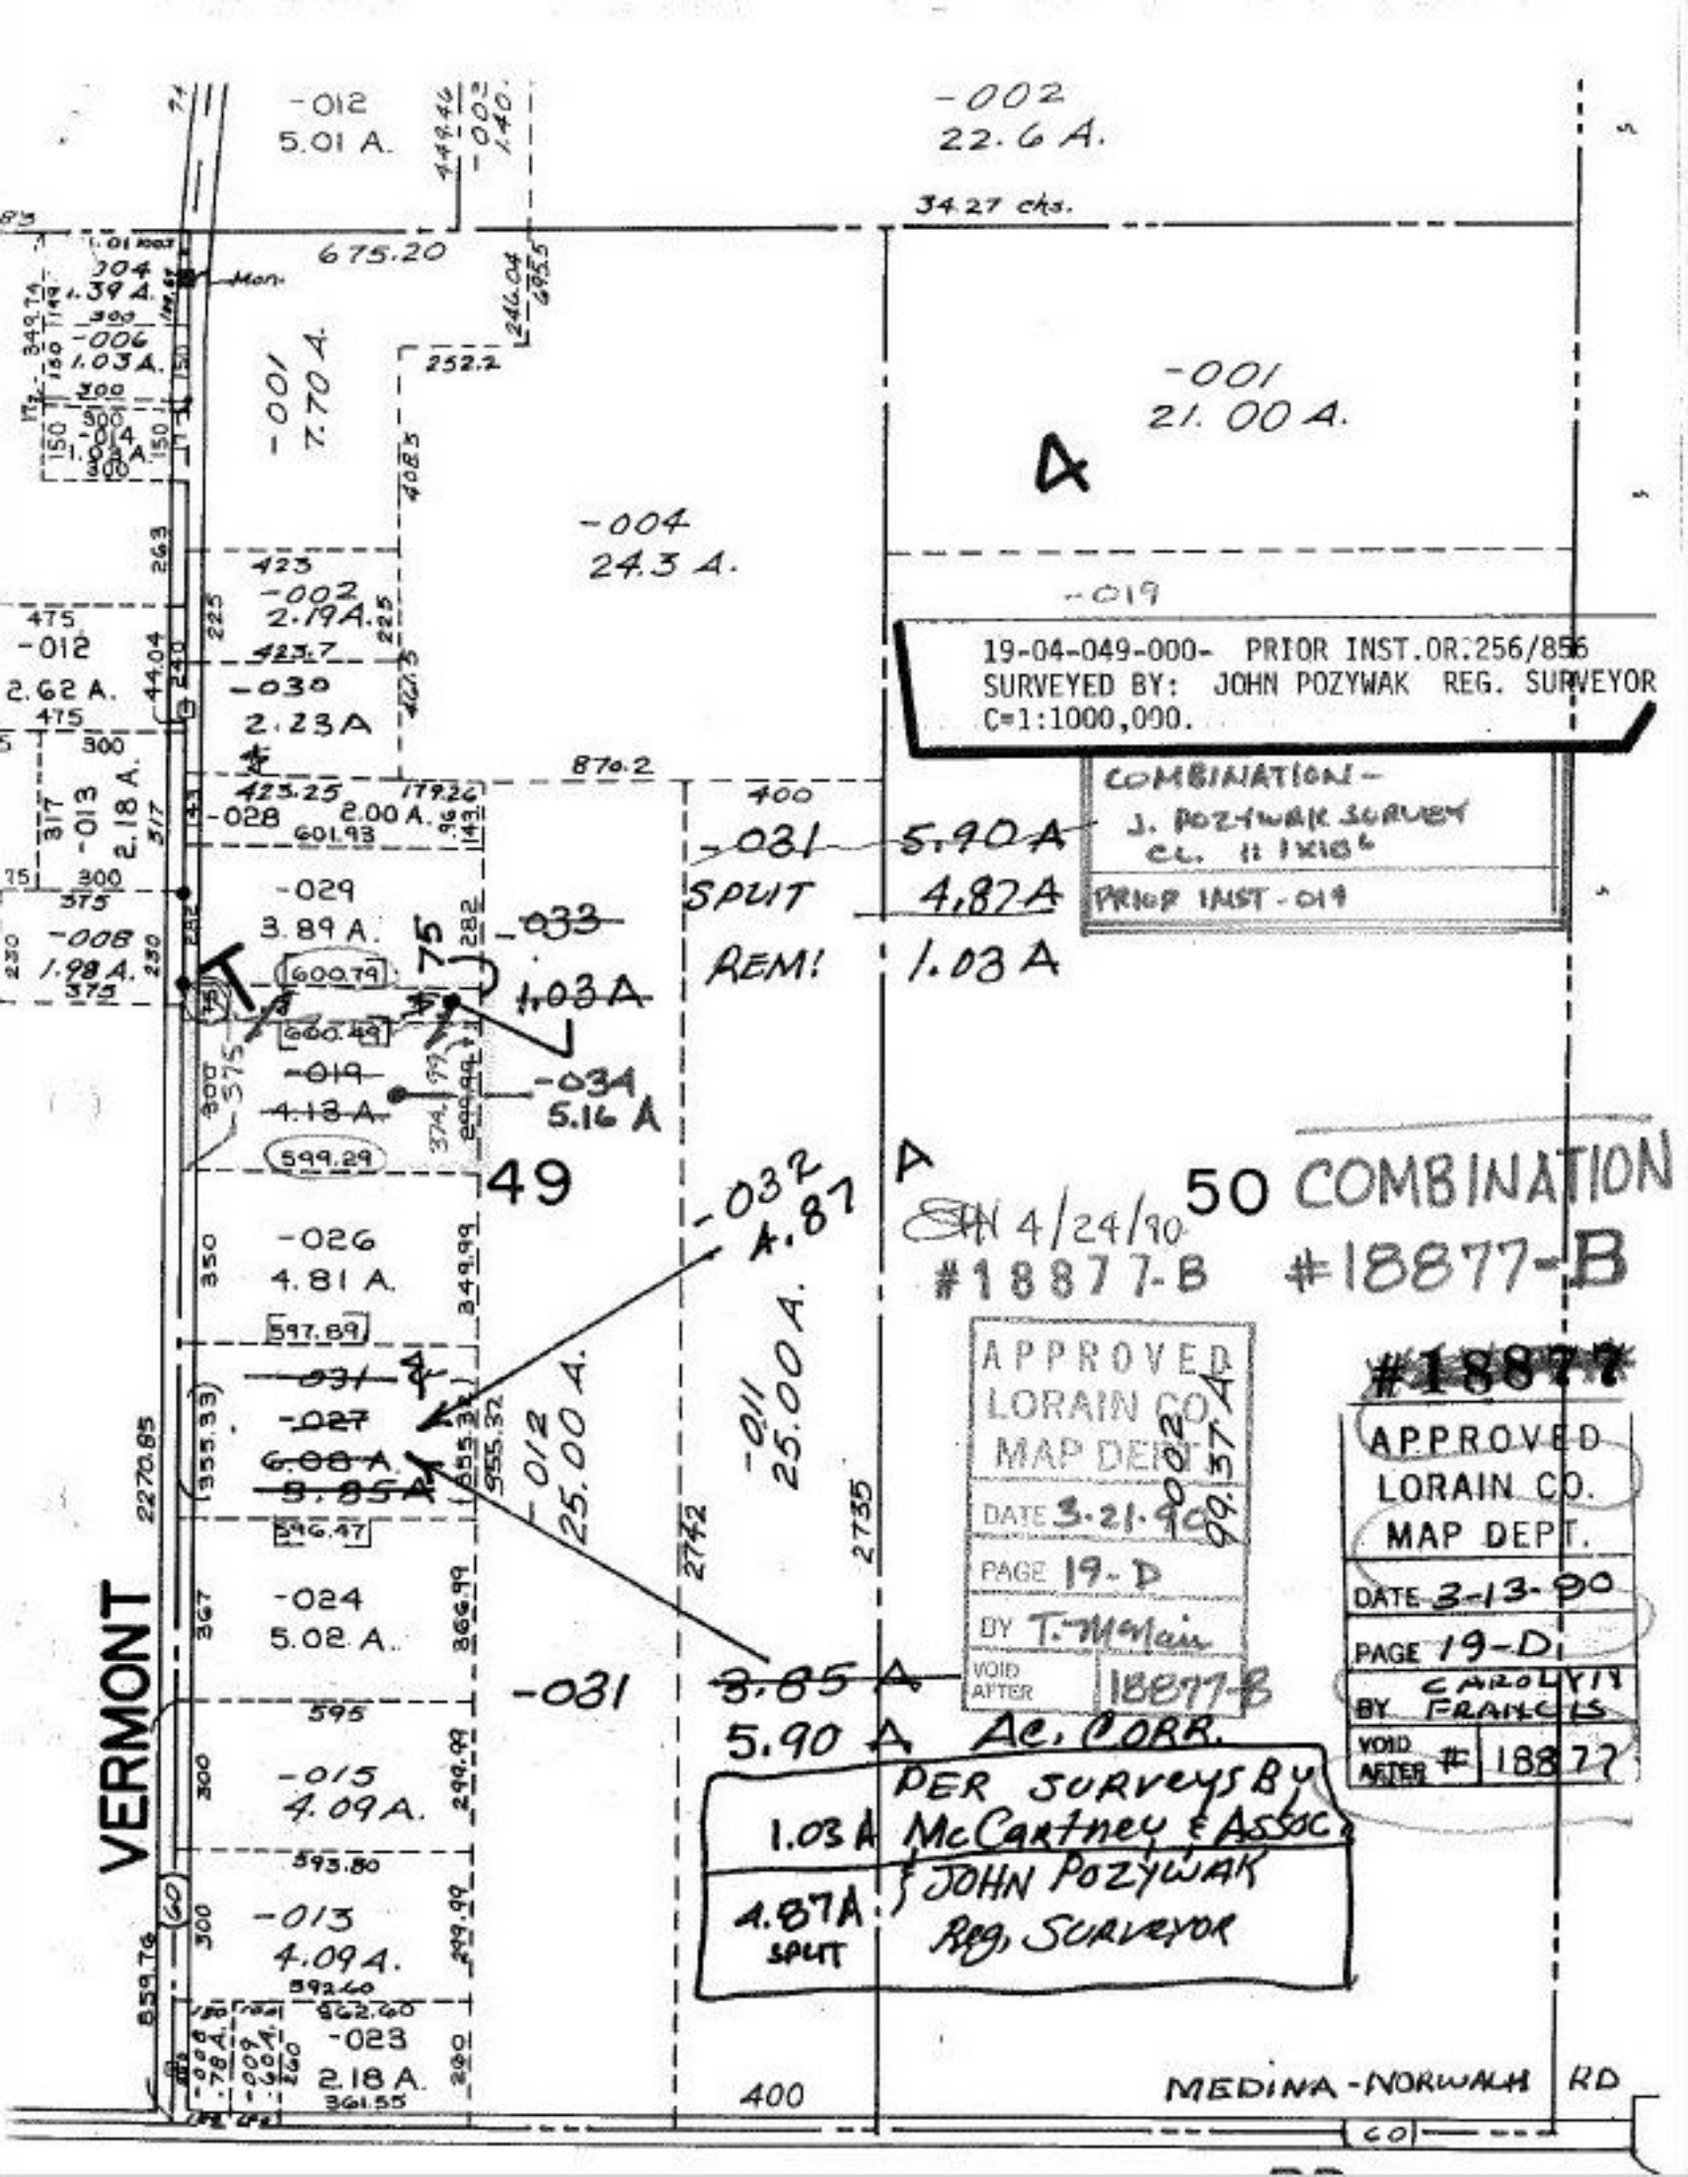

-012
5.01 A.
-002
22.6 A.
34.27 chs.
675.20
-001
7.70 A.
-001
21.00 A.
A
-004
24.3 A.
-019
19-04-049-000- PRIOR INST.OR.256/856
SURVEYED BY: JOHN POZYWAK REG. SURVEYOR
C=1:1000,000.
COMBINATION -
J. POZYWAK SURVEY
CL. 11 1X10^6
PRIOR INST - 019
-012
2.62 A.
-030
2.23 A
-028
2.00 A.
-031
5.90 A
SPLIT
4.87 A
REM!
1.03 A
-029
3.89 A.
-033
1.03 A
-008
1.98 A.
-019
4.13 A.
-034
5.16 A
49
50
-032
4.87 A
COMBINATION
#18877-B
#18877-B
-026
4.81 A.
-031
-027
6.08 A.
3.85 A
-012
25.00 A.
-011
25.00 A.
-024
5.02 A.
-031
3.85 A
5.90 A
AC. CORR.
PER SURVEYS BY
1.03 A McCartney & Assoc.
4.87 A SPLIT
JOHN POZYWAK
Reg. SURVEYOR
VERMONT
-015
4.09 A.
-013
4.09 A.
-023
2.18 A.
MEDINA-NORWALK RD
APPROVED
LORAIN CO.
MAP DEPT.
DATE 3-21-90
PAGE 19-D
BY T. McNair
VOID AFTER 18877-B
#18877
APPROVED
LORAIN CO.
MAP DEPT.
DATE 3-13-90
PAGE 19-D
BY CAROLYN FRANCIS
VOID AFTER # 18877