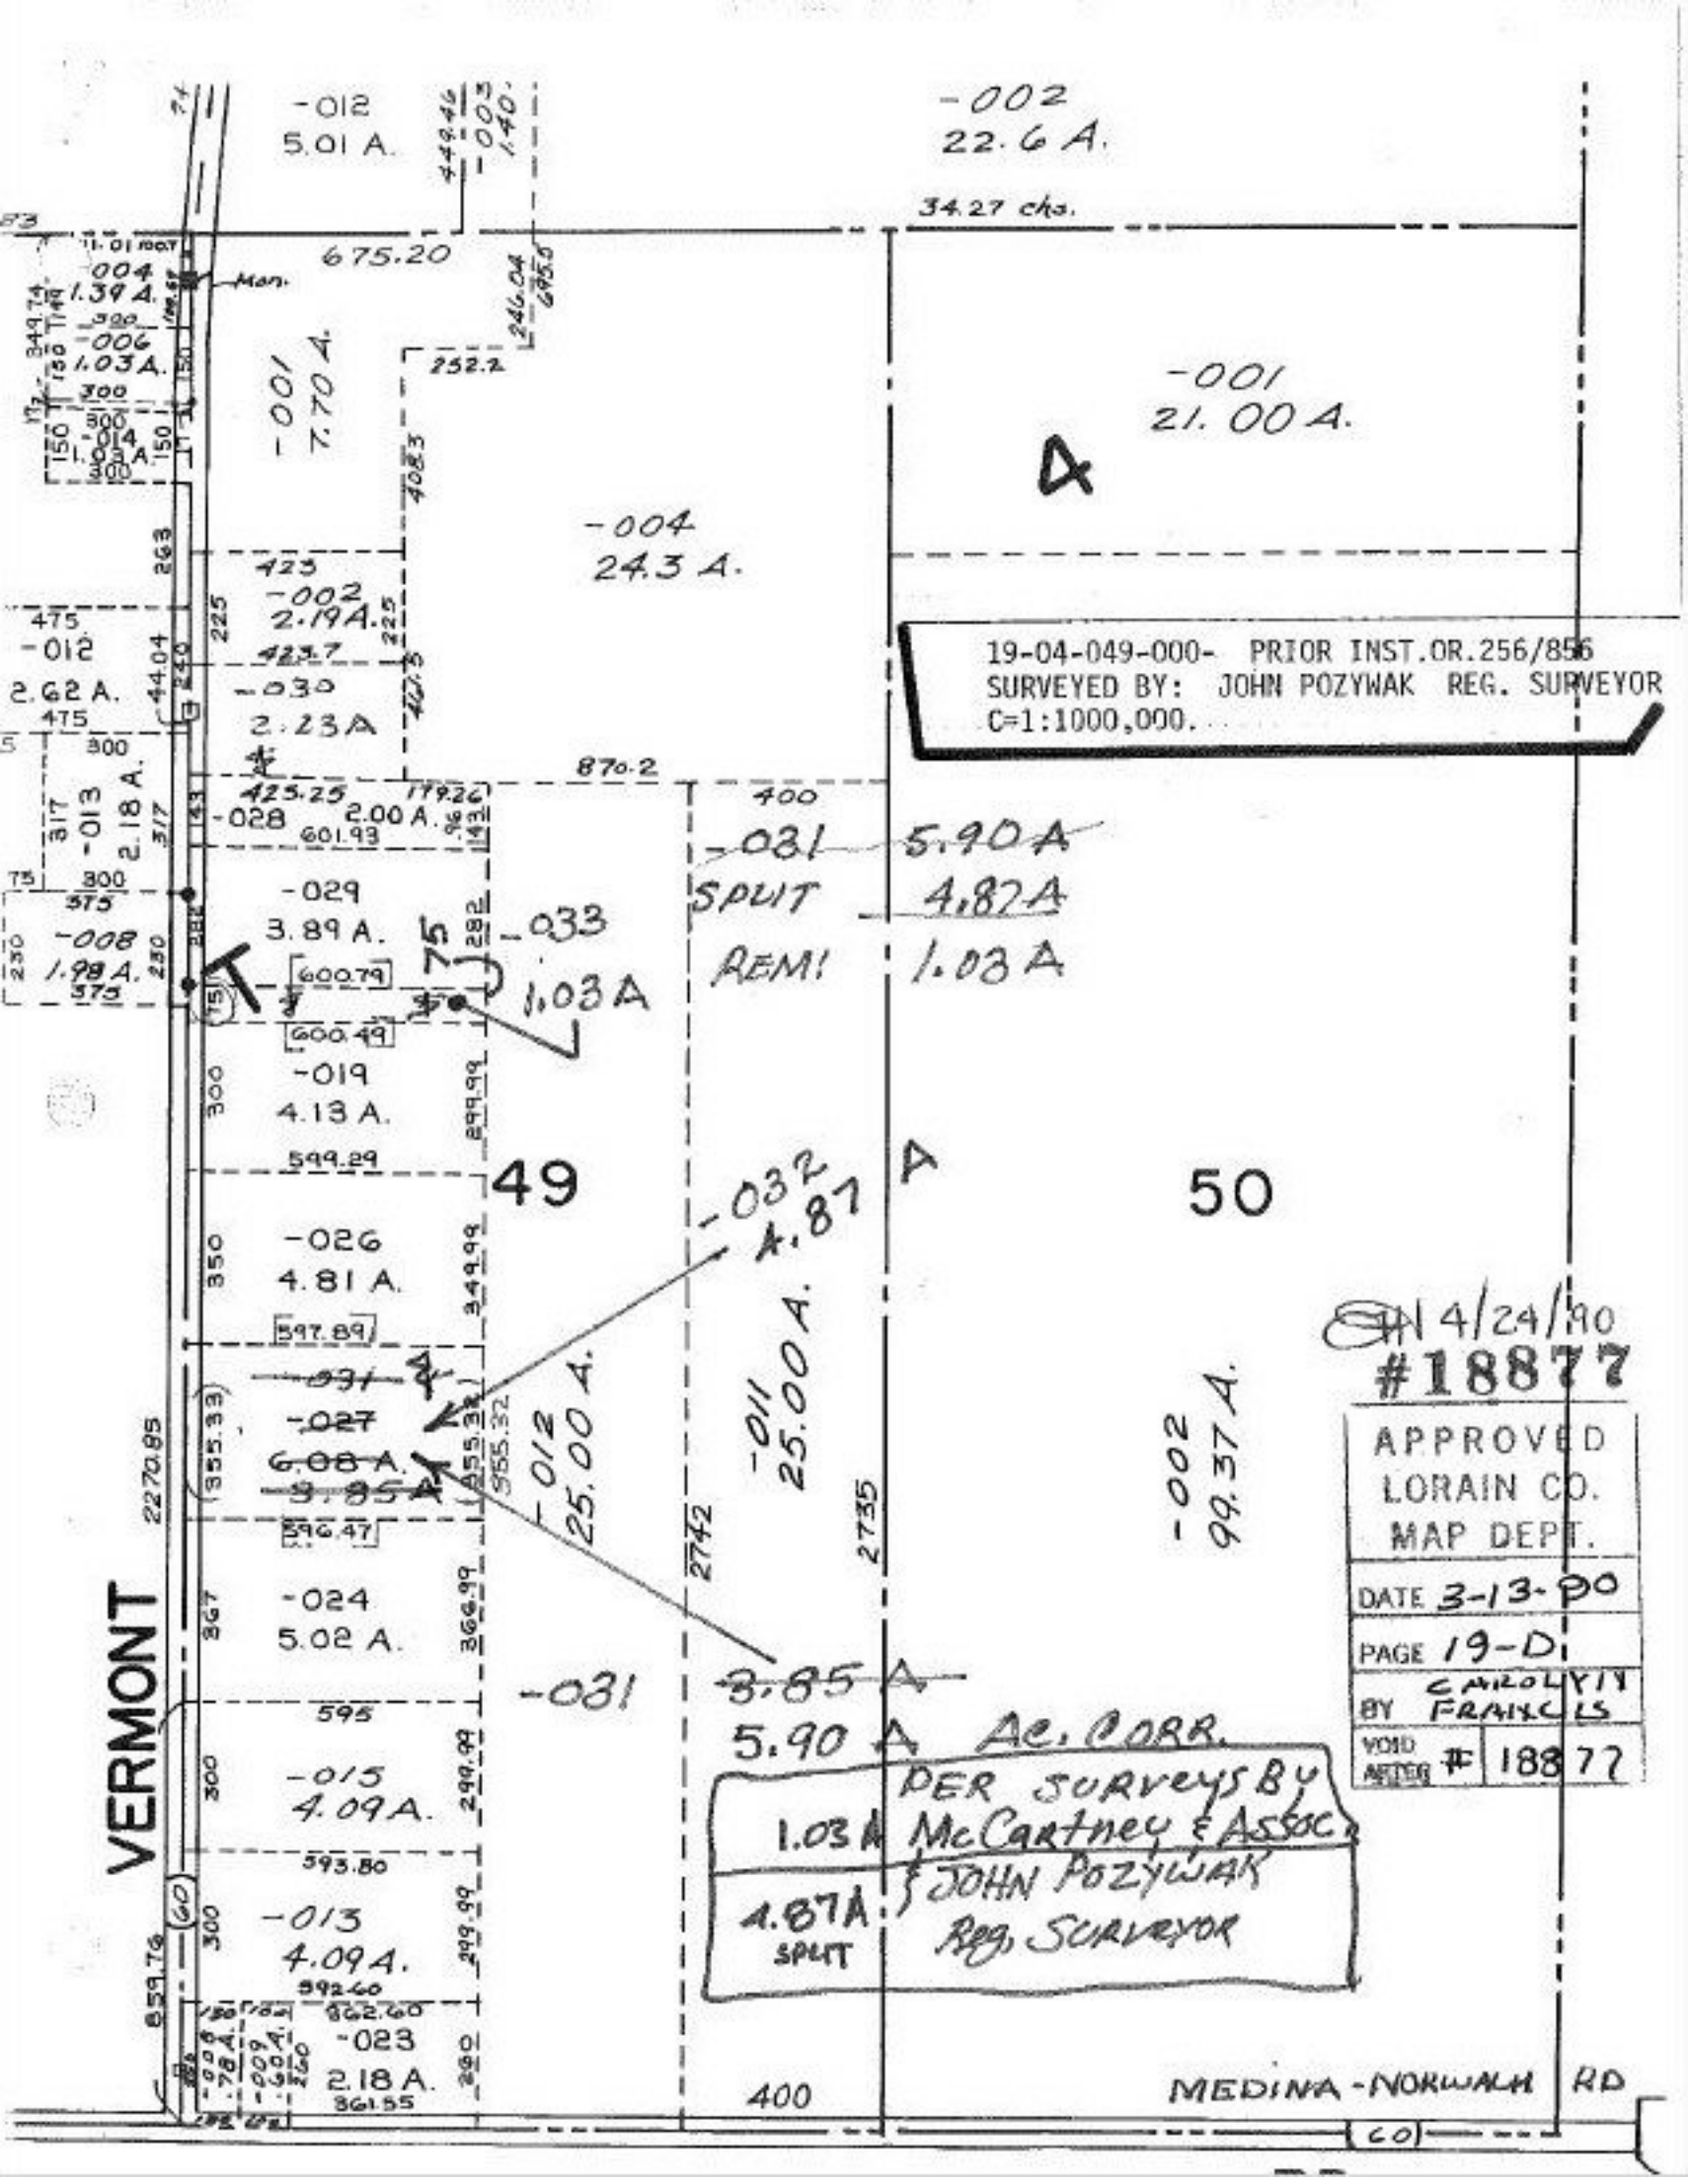
-012
5.01 A.
-002
22.6 A.
34.27 chs.
675.20
-004
1.39 A.
-006
1.03 A.
-001
7.70 A.
-001
21.00 A.
A
-004
24.3 A.
-002
2.19 A.
-012
2.62 A.
-030
2.23 A
19-04-049-000- PRIOR INST. OR. 256/856
SURVEYED BY: JOHN POZYWAK REG. SURVEYOR
C=1:1000,000.
-013
2.18 A.
-028
2.00 A.
-031
5.90 A
SPLIT
4.82 A
REM!
1.03 A
-029
3.89 A.
-033
1.03 A
-008
1.98 A.
-019
4.13 A.
49
50
-026
4.81 A.
-032
4.87 A
-027
6.08 A
3.85 A
-012
25.00 A.
-011
25.00 A.
-002
99.37 A.
4/24/90
#18877
APPROVED
LORAIN CO.
MAP DEPT.
DATE 3-13-90
PAGE 19-D
BY CAROLYN FRANCIS
VOID AFTER # 18877
VERMONT
-024
5.02 A.
-031
3.85 A
5.90 A Ac. CORR.
PER SURVEYS BY
1.03 A McCartney & Assoc.
& JOHN POZYWAK
4.87 A SPLIT
Reg. SURVEYOR
-015
4.09 A.
-013
4.09 A.
-023
2.18 A.
MEDINA - NORWALK RD