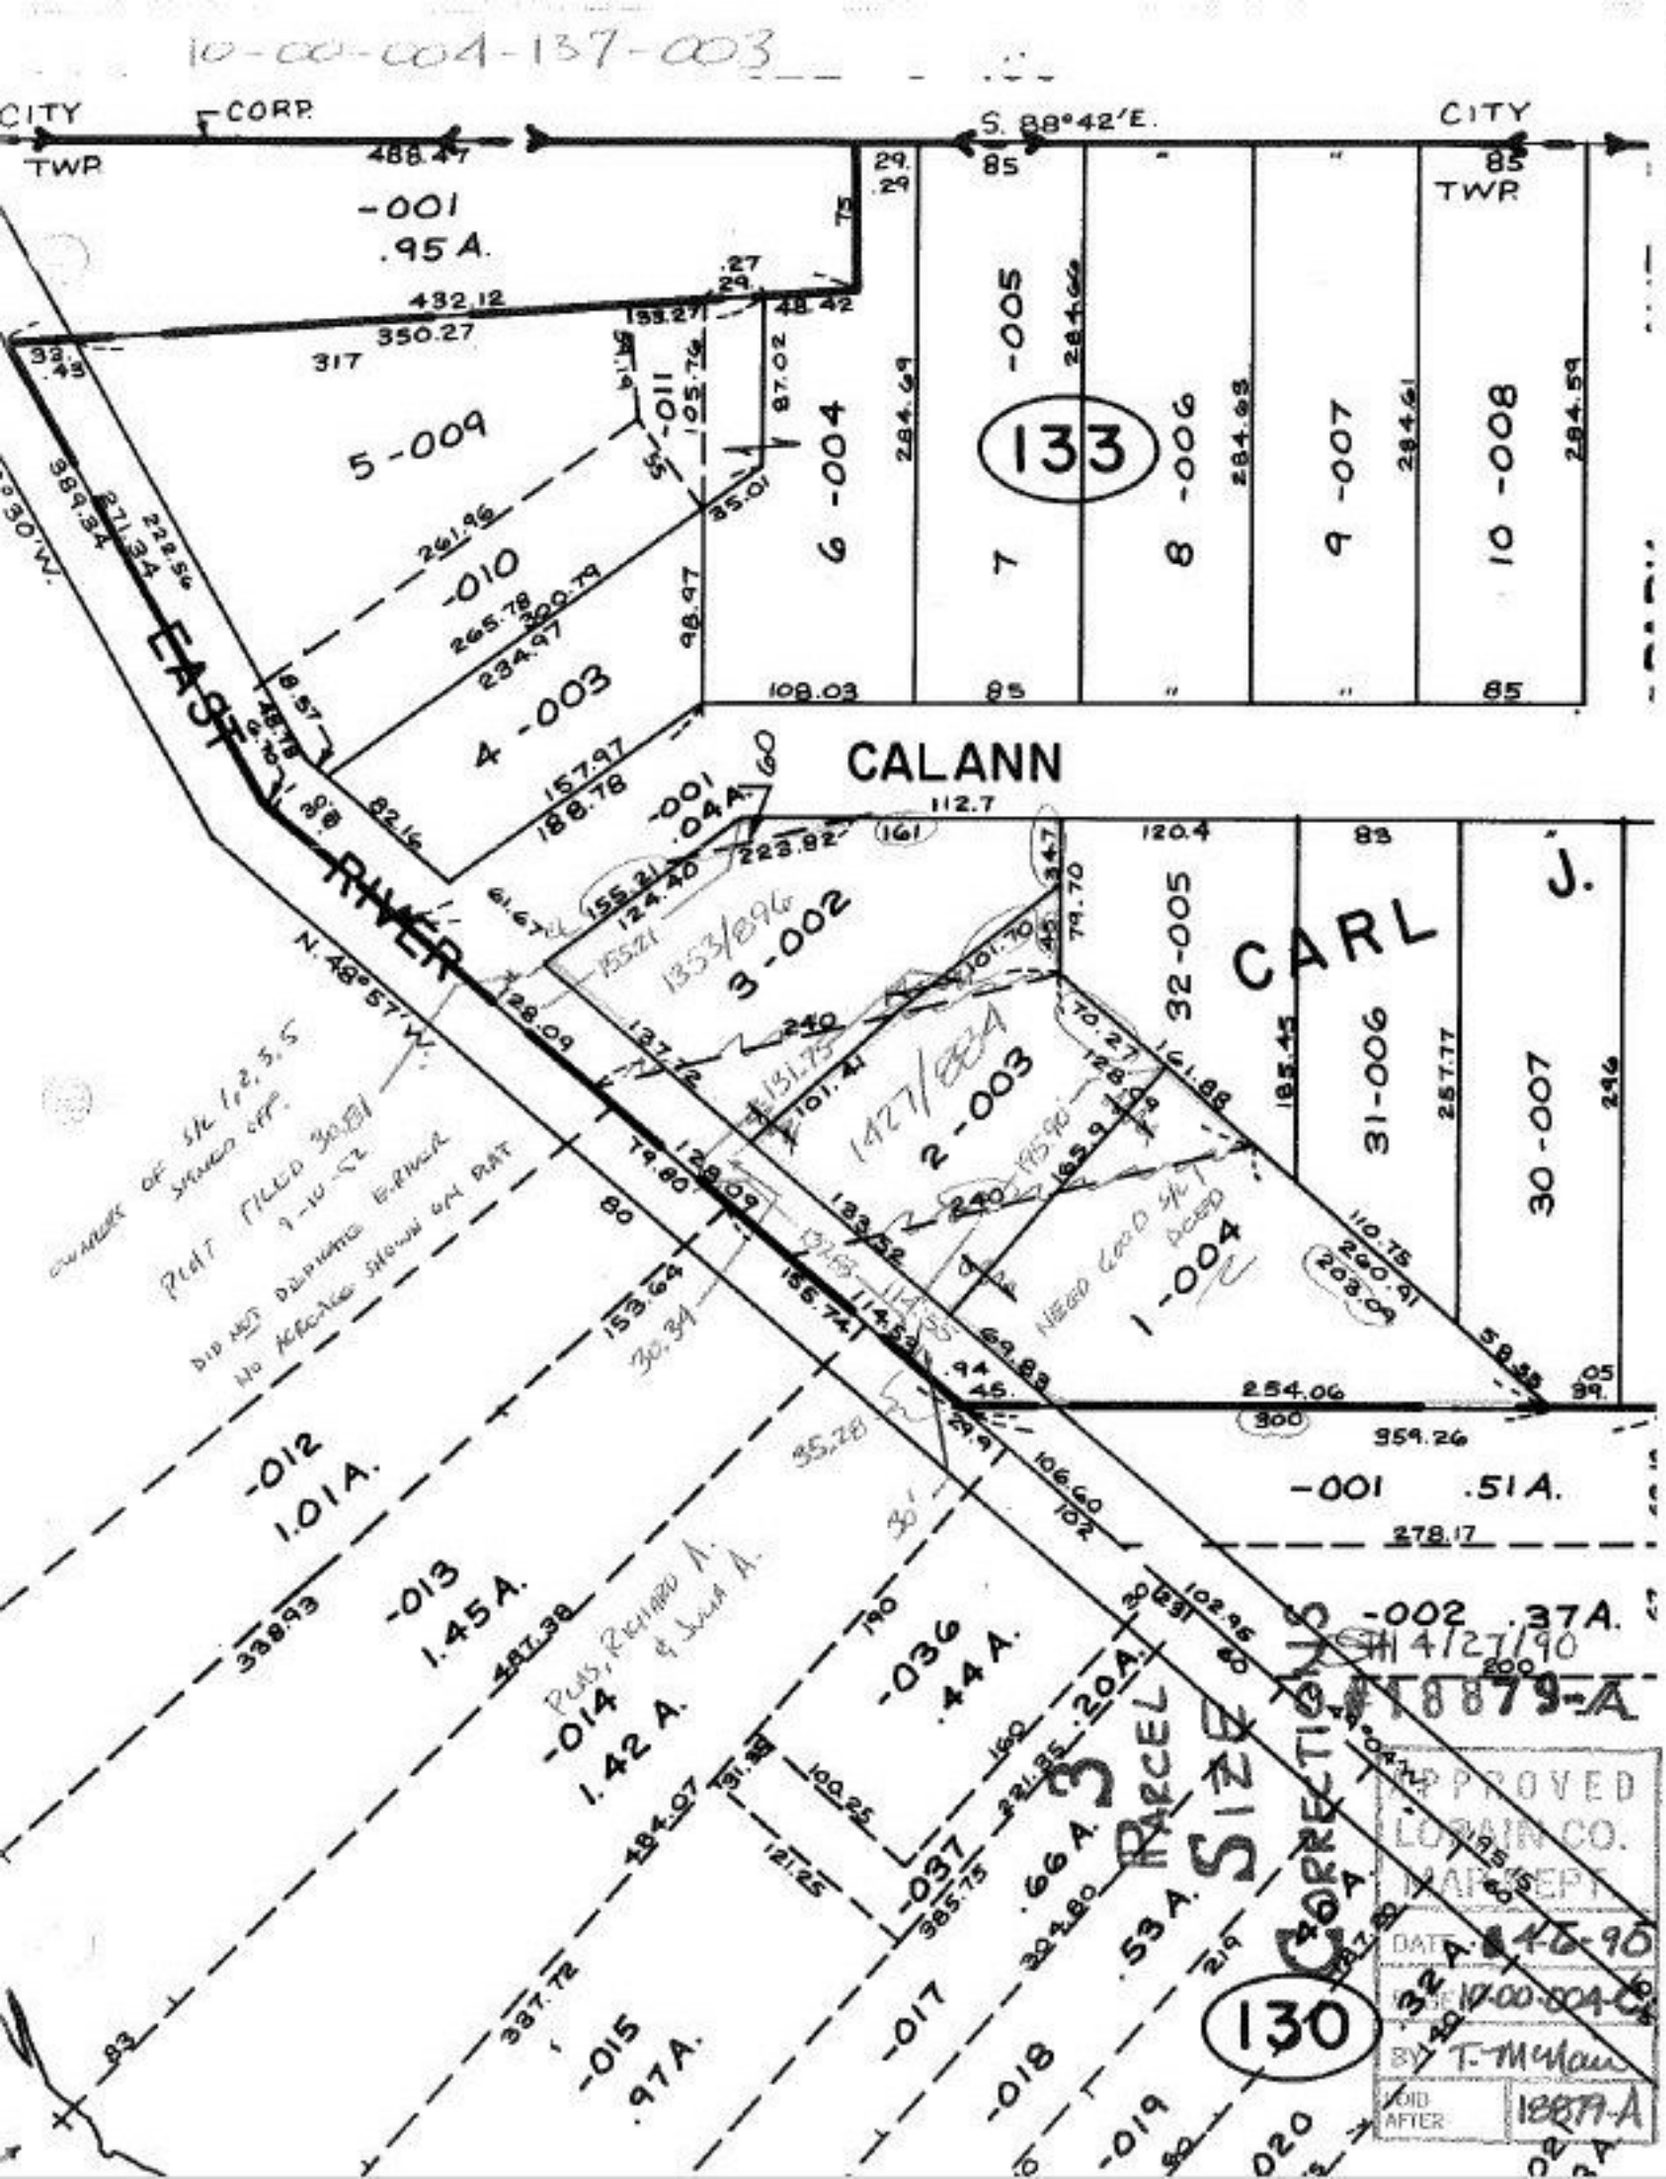10-00-004-137-003