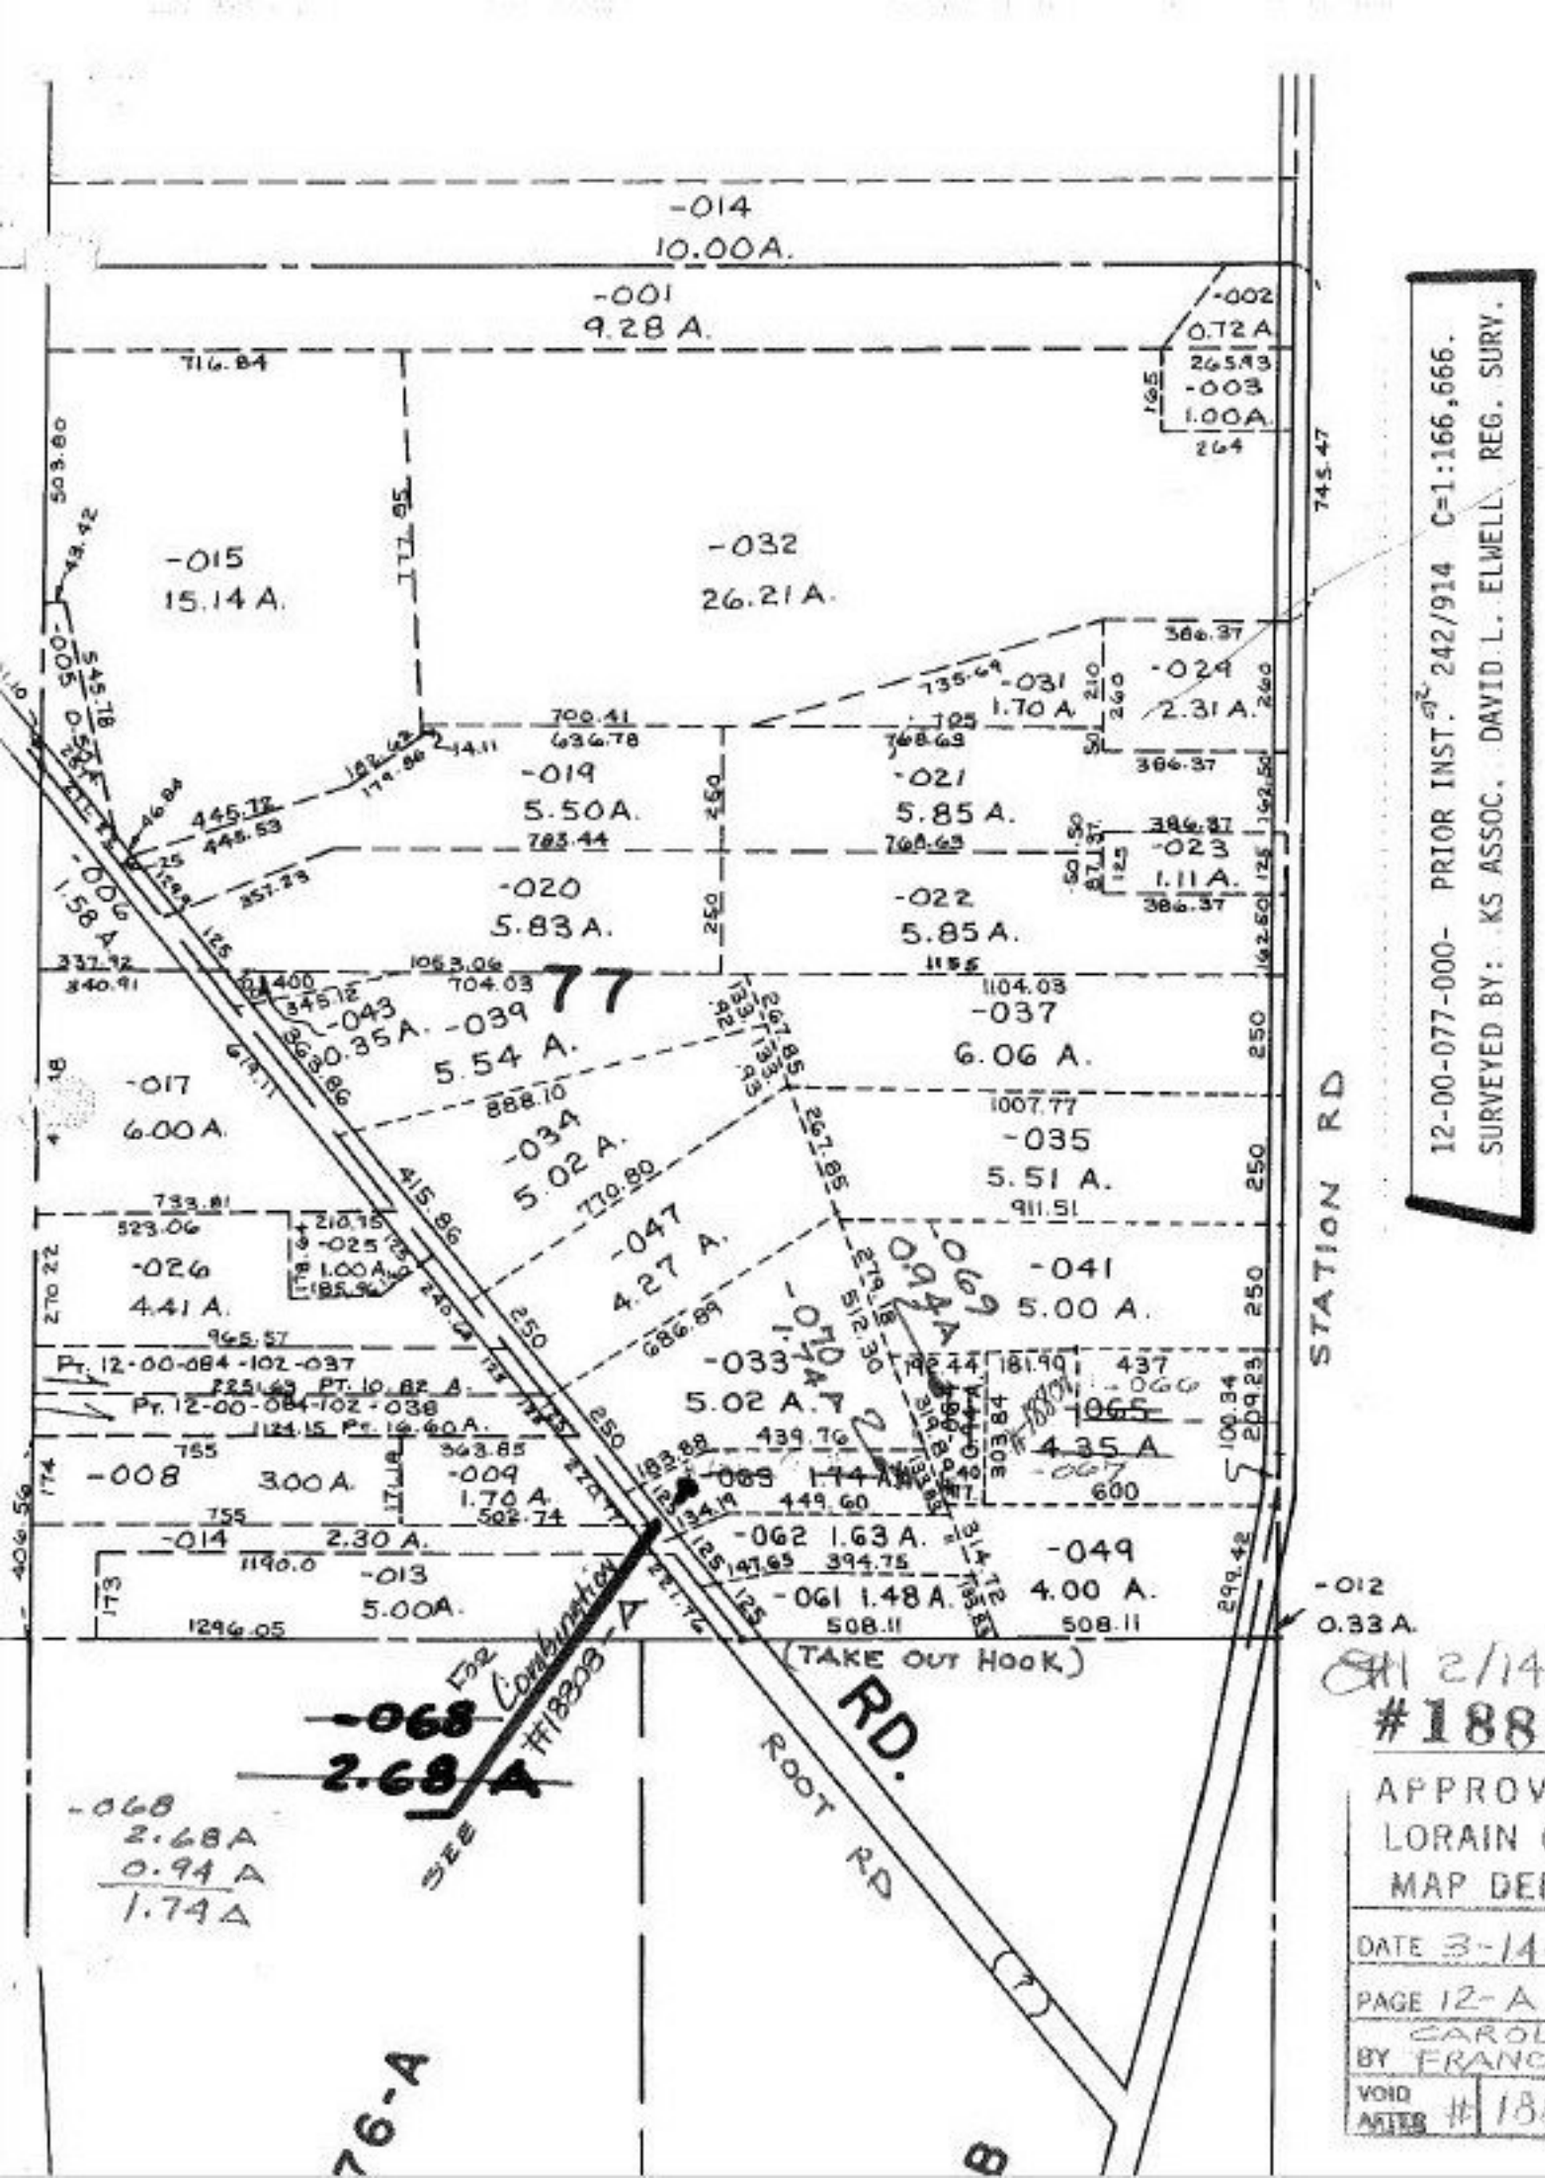
-014
10.00A.
-001
9.28 A.
-002
0.72 A
-003
1.00A.
-015
15.14 A.
-032
26.21 A.
-024
2.31 A.
-031
1.70 A
-019
5.50A.
-021
5.85 A.
-023
1.11 A.
-020
5.83 A.
-022
5.85 A.
-006
1.58 A
77
-043
0.35A.
-039
5.54 A.
-037
6.06 A.
-017
6.00 A.
-034
5.02 A.
-035
5.51 A.
-047
4.27 A.
-026
4.41 A.
-025
1.00A.
-041
5.00 A.
-033
5.02 A.
-069
0.94A
-070
1.74 A
-065
4.35 A
-008
3.00 A.
-009
1.70 A.
-014
2.30 A.
-013
5.00A.
-062 1.63 A.
-061 1.48 A.
-049
4.00 A.
-012
0.33 A.
STATION RD
ROOT RD.
(TAKE OUT HOOK)
-068
2.68 A
-068
2.68A
0.94 A
1.74A
SEE
For Combination
#18880-A
12-00-077-000- PRIOR INST. 242/914 C=1:166,666.
SURVEYED BY: KS ASSOC. DAVID L. ELWELL REG. SURV.
2/14/91
#18880
APPROVED
LORAIN CO.
MAP DEPT.
DATE 3-14-90
PAGE 12-A
BY CAROLYN FRANCIS
VOID AFTER # 18880