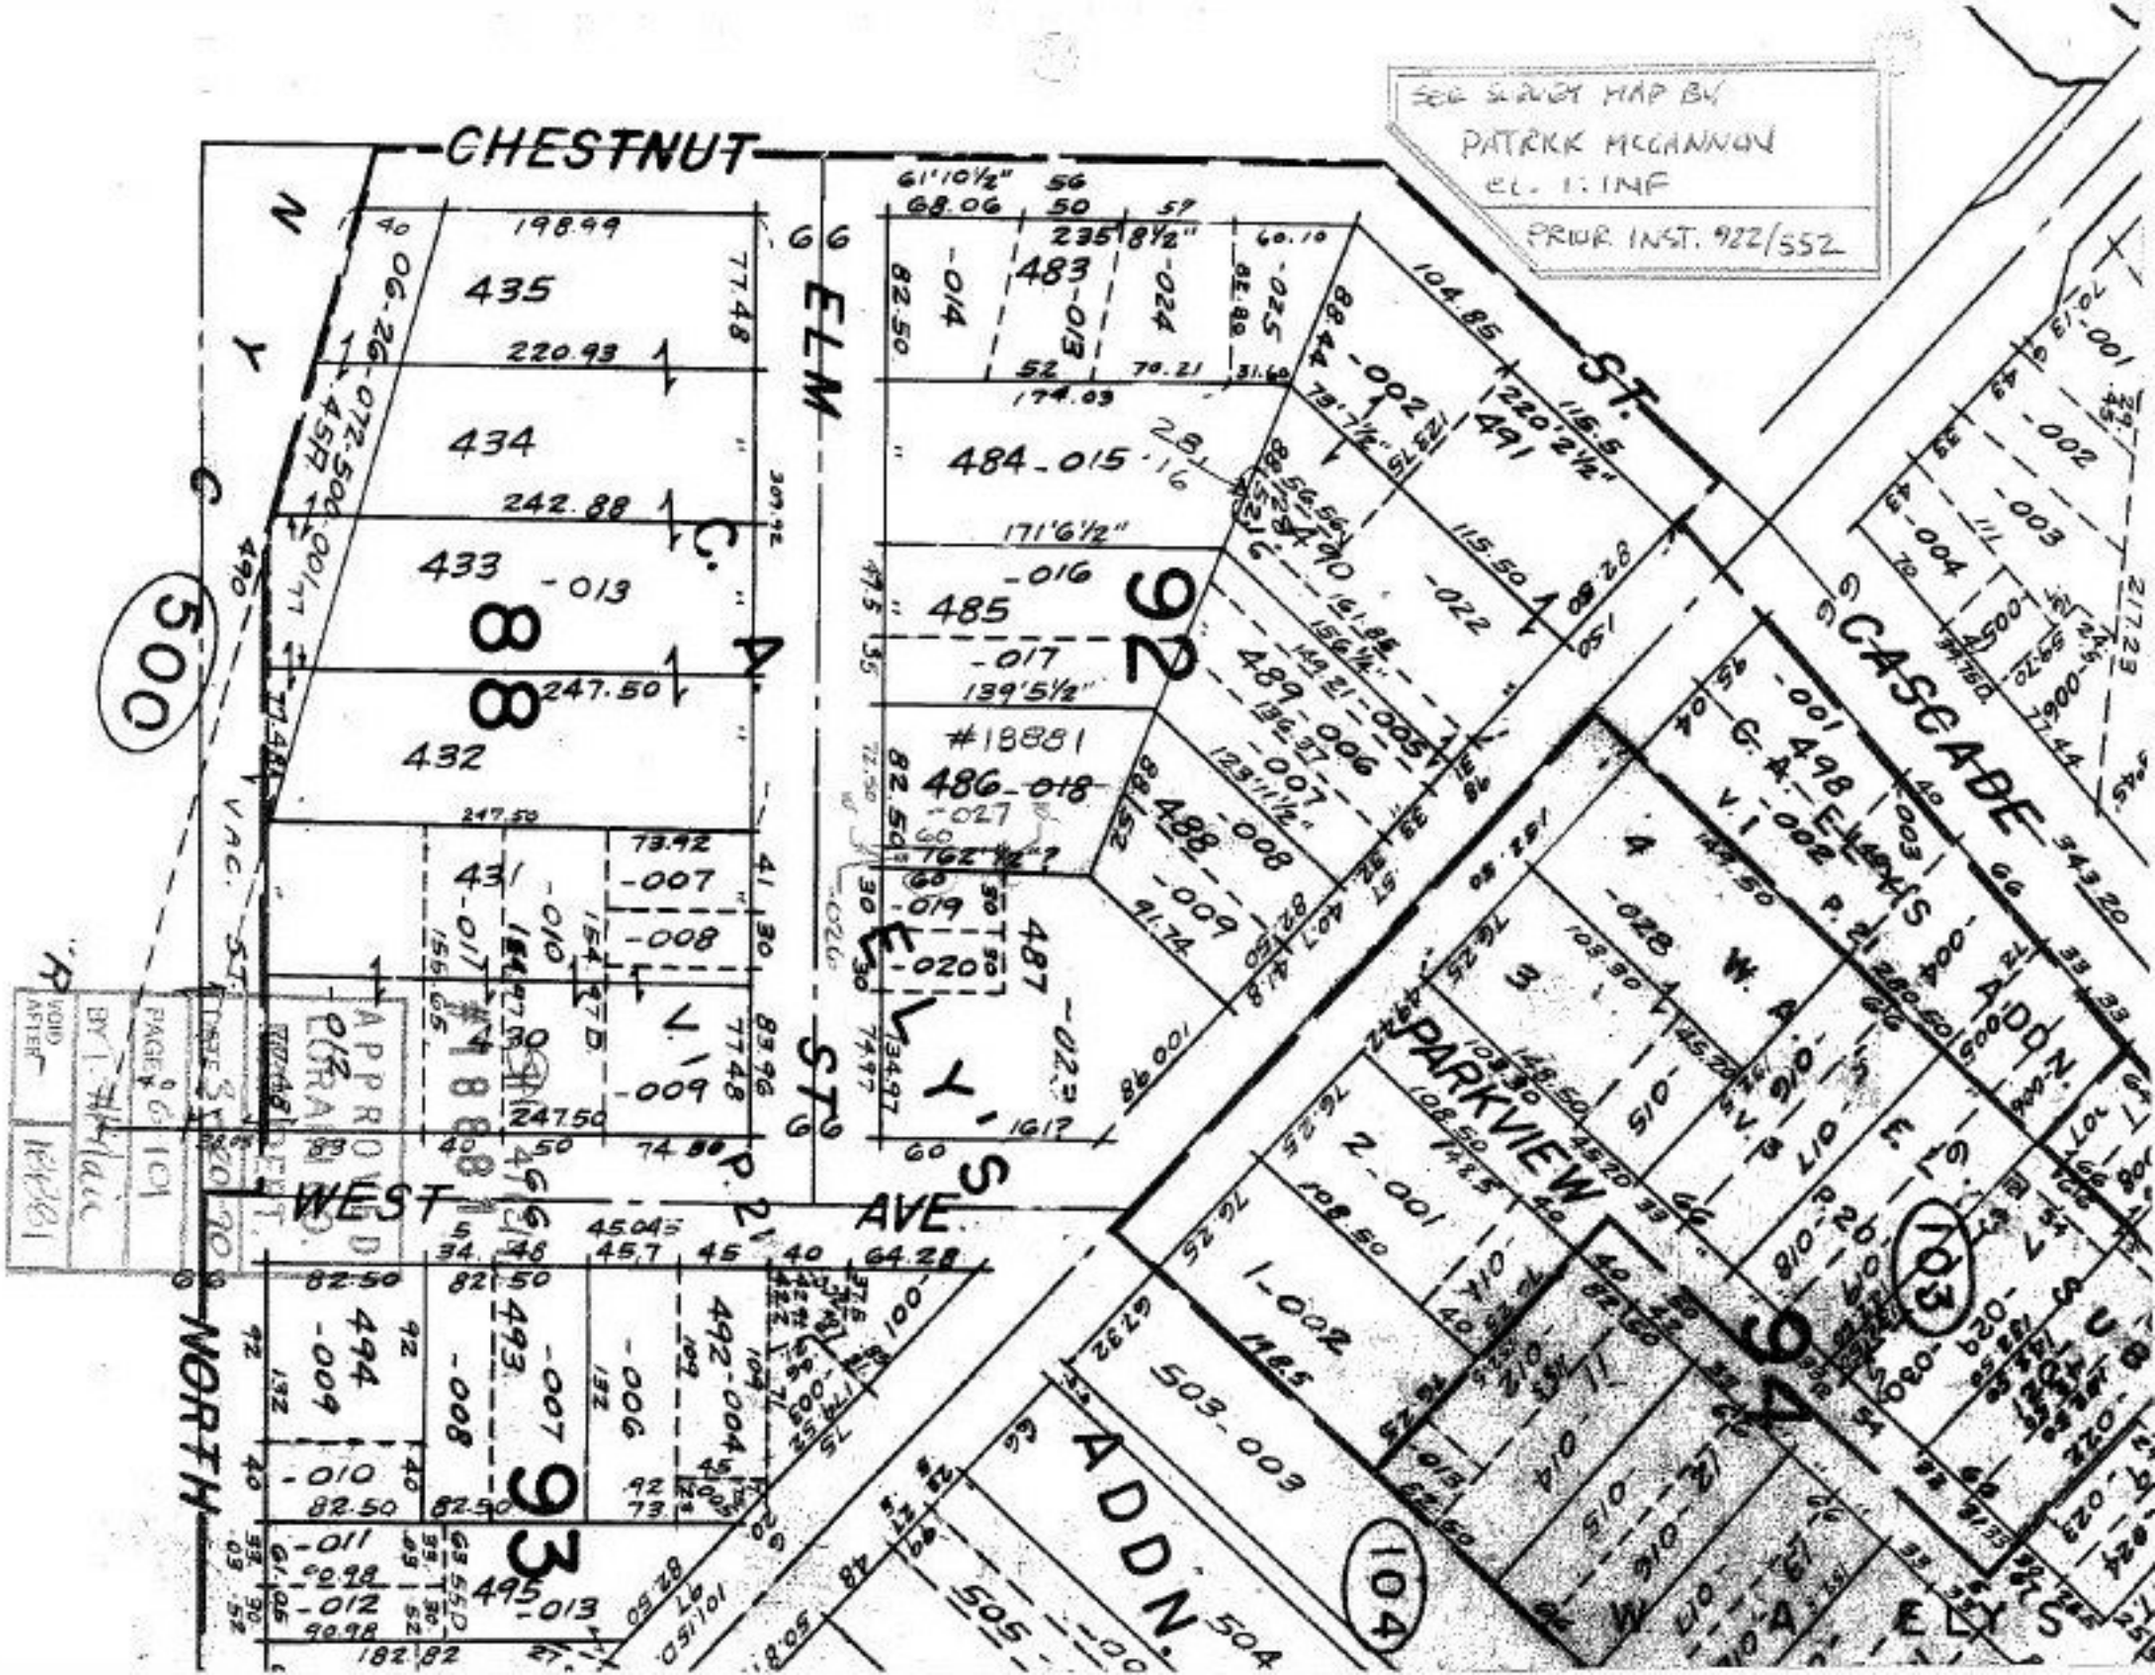
SEE SLUDGY MAP BY
PATRICK McCANNON
EL. 1: INF
PRIOR INST. 922/552
CHESTNUT
ELM
ST.
CASCADE
ST.
WEST
AVE.
NORTH
PARKVIEW
ADDN.
ADDN.
VAC. ST.
APPROVED
GRADE
435
434
433 -013
432
431 -011
-010
-007
-008
#18881
#18882
247.50
198.99
220.93
242.88
171'6½"
139'5½"
73.92
74.80
483 -010
-014
-024
-025
484-015-016
485 -017
#18881
486-018
-027
487 -020
-021
488 -009
489 -006
-007
490
491 -002
-022
498 -001
-002
-003
-004
-005
V.1
P.21
280.50
343.20
4 -028
3
2 -001
1-002
503-009
504
505
92
93
94
500
101
102
103
104
494 -004
-006
-007
-008
-009
-010
492-004
493 -007
-008
495 -011
-012
-013
182.82
90.98
82.50
108.50
118.5
115.20
108.30
74.25
45.20
64.28
45.04
45.7
45
40
34
5
6
