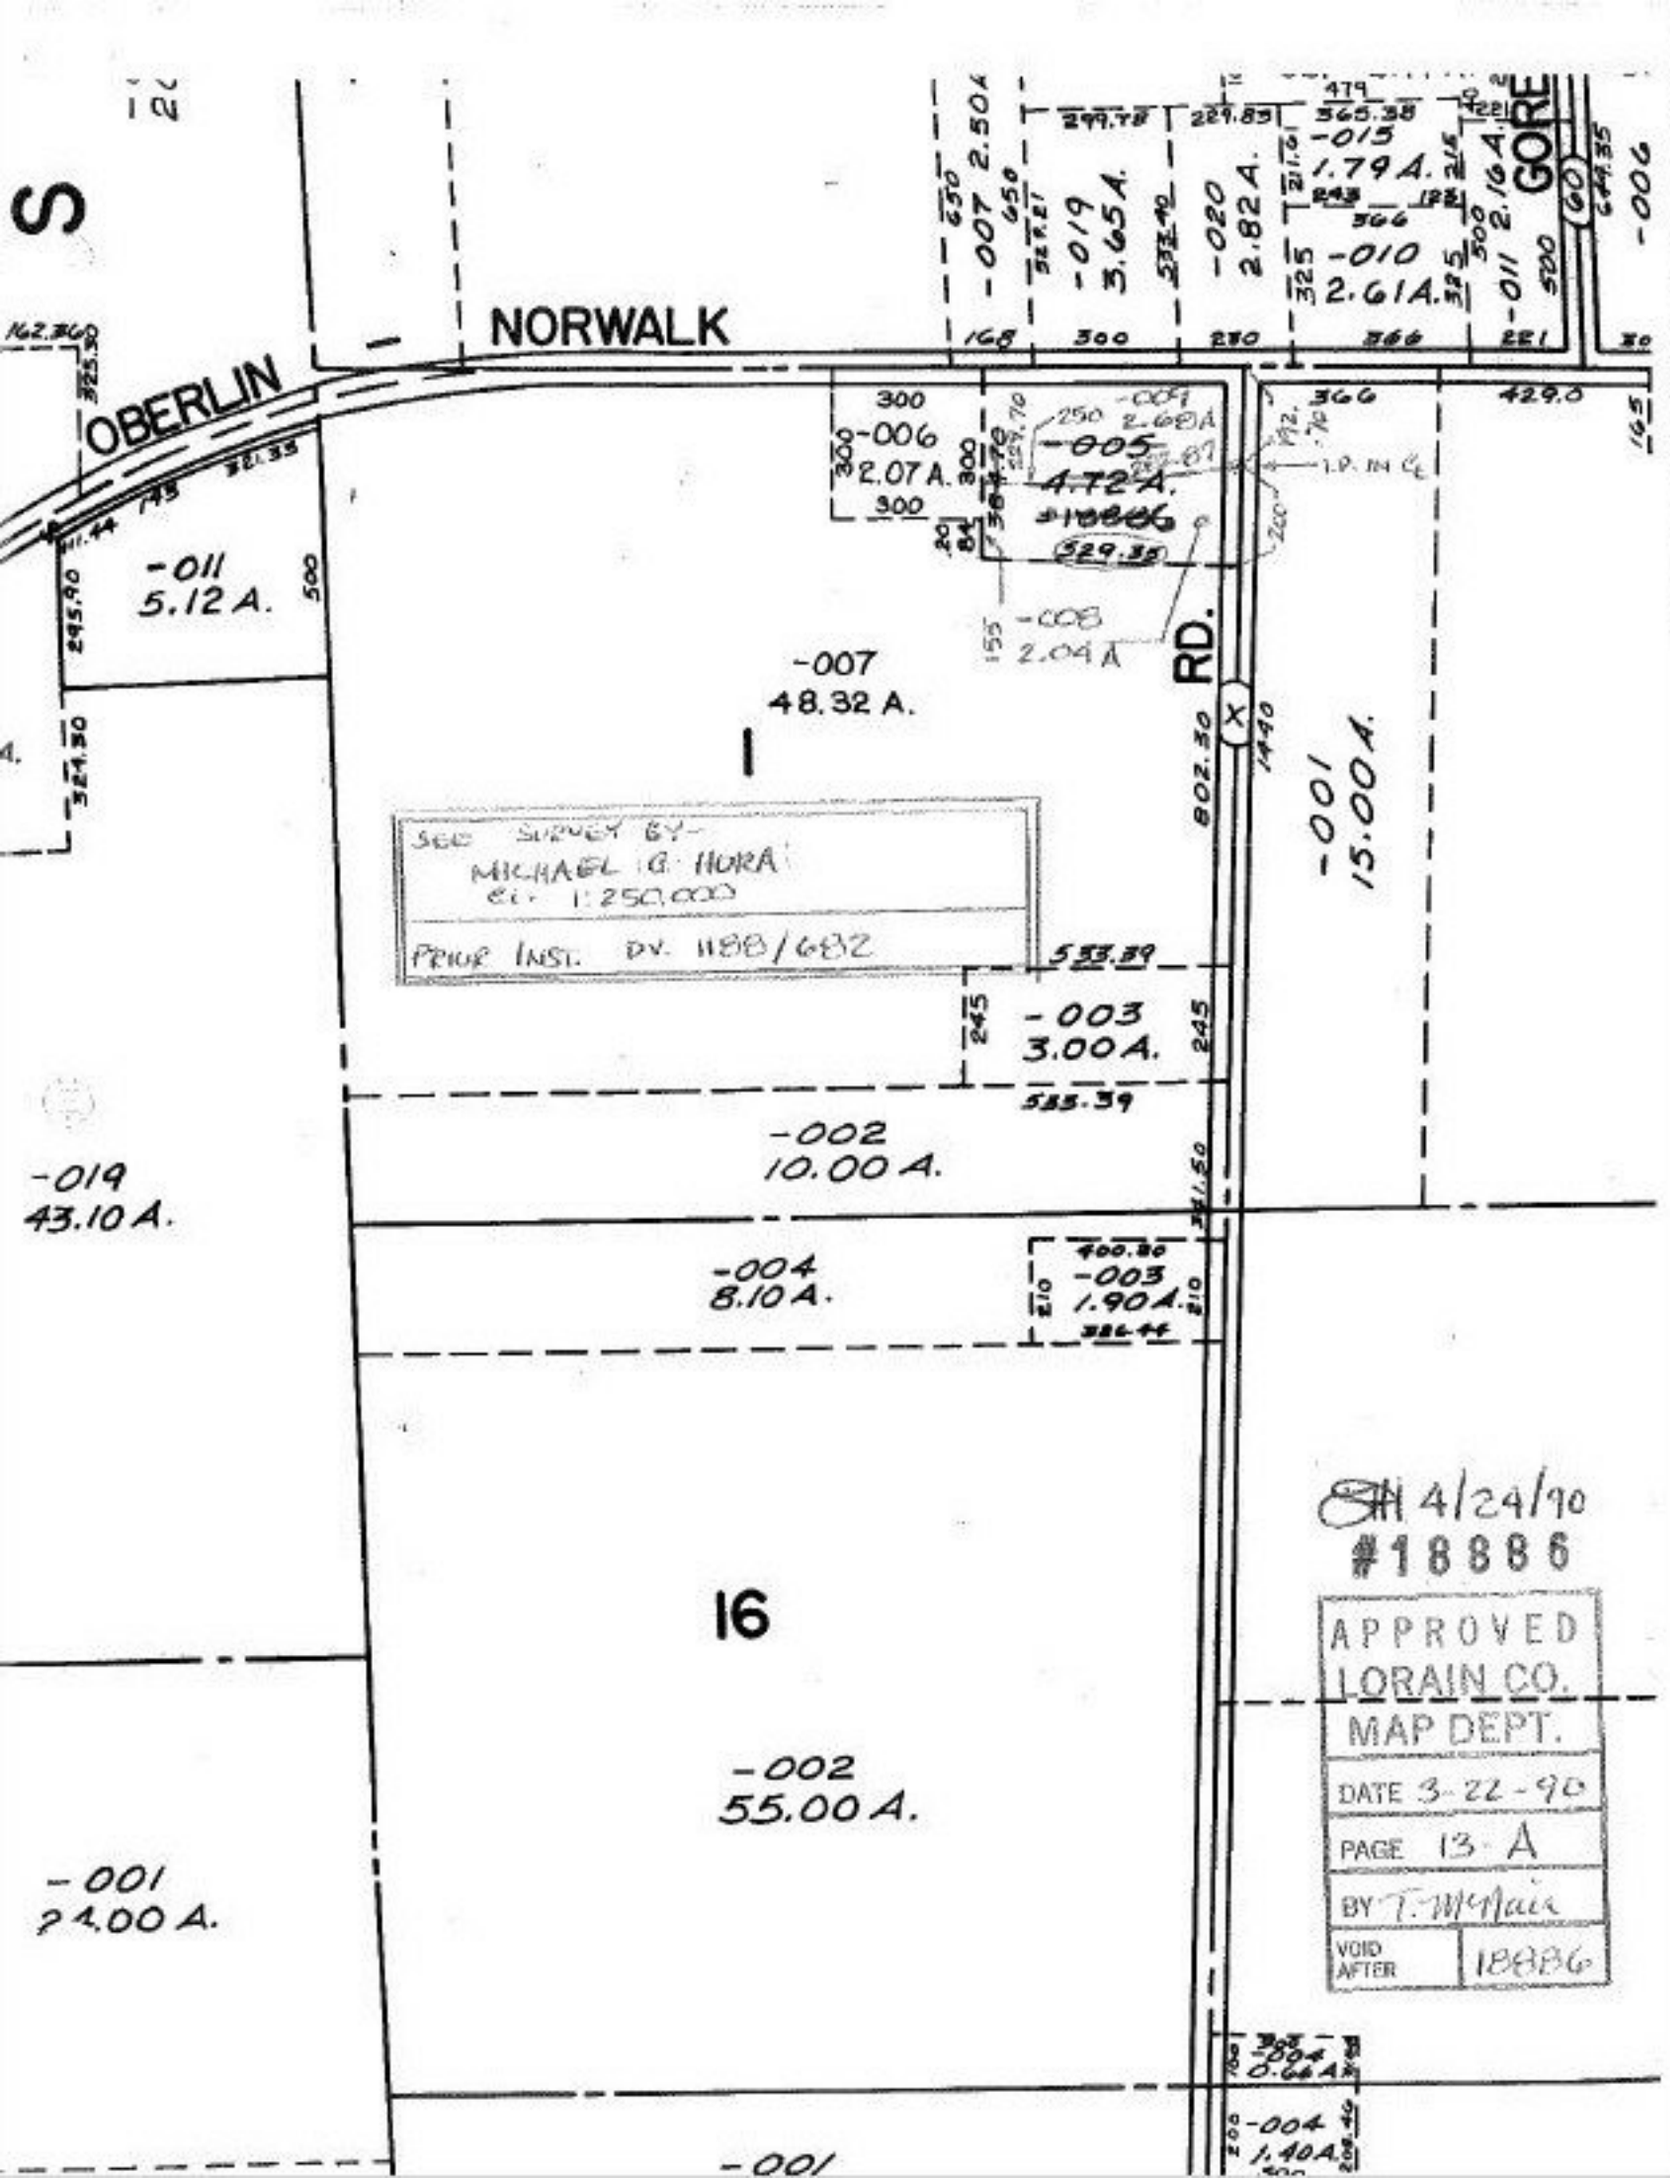
NORWALK
OBERLIN
GORE
RD.
-007 2.50A
-019 3.65A.
-020 2.82A.
-010 2.61A.
-015 1.79A.
-011 2.16A.
-006
-009 2.68A
-005 4.72A.
-006 2.07 A.
-008 2.04 A
-011 5.12 A.
-007 48.32 A.
-001 15.00A.
-003 3.00A.
-002 10.00 A.
-019 43.10 A.
-004 8.10A.
-003 1.90A.
16
-002 55.00 A.
-001 24.00 A.
-004 1.40A.
SEE SURVEY BY-
MICHAEL G. HORA
EL. 1:250,000
PRIOR INST. DV. 1188/682
4/24/90
#18886
APPROVED
LORAIN CO.
MAP DEPT.
DATE 3-22-90
PAGE 13-A
BY T. McMain
VOID AFTER 18886