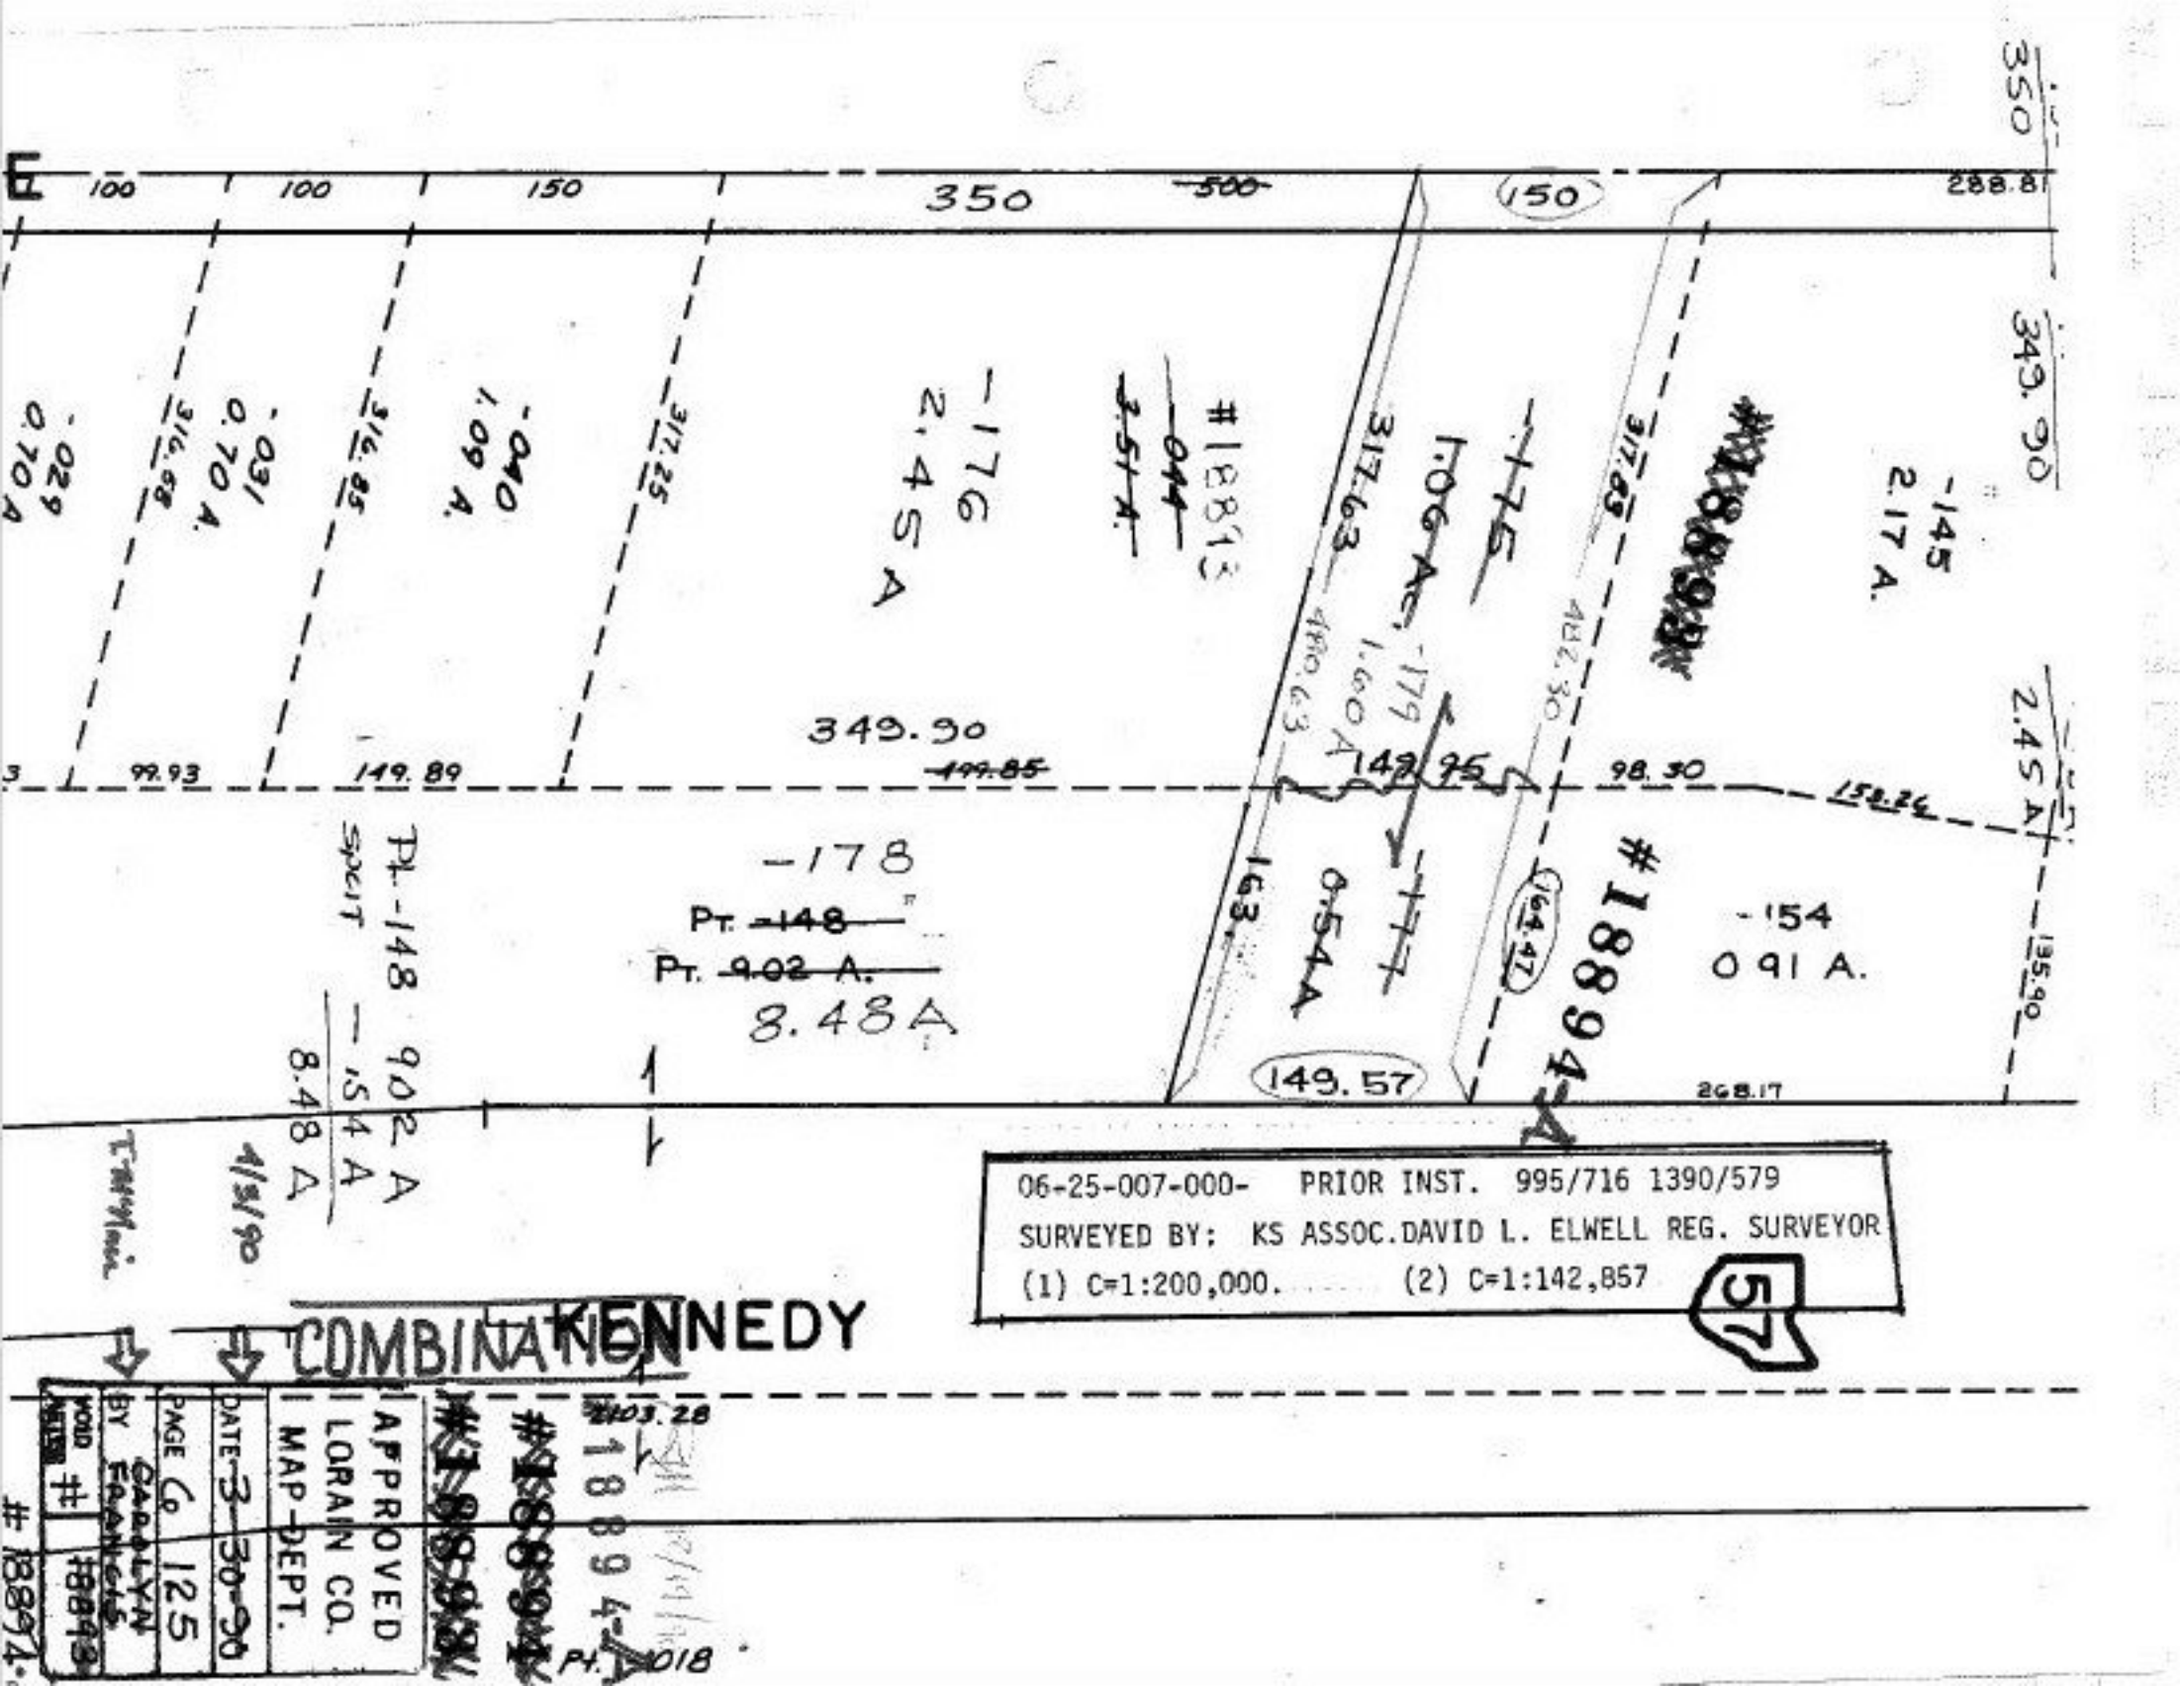
100
100
150
350
500
150
288.81
350
349.90
-029
0.70 A.
-031
0.70 A.
-040
1.09 A.
317.25
-176
2.45 A
#18813
044
2.51 A.
317.63
1.06 Ac.
-179
1.60 A
480.63
-175
317.63
482.30
#18894
-145
2.17 A.
349.90
2.45 A
99.93
149.89
199.85
142.95
98.30
158.26
-178
Pt. -148
Pt. 9.02 A.
8.48 A.
Pt. -148 9.02 A
split -154 8.48 A
4/91/90
163
0.54 A
-177
164.47
#18894
-154
0.91 A.
135.90
149.57
268.17
06-25-007-000- PRIOR INST. 995/716 1390/579
SURVEYED BY: KS ASSOC. DAVID L. ELWELL REG. SURVEYOR
(1) C=1:200,000. (2) C=1:142,857
57
COMBINATION
KENNEDY
2103.28
#18894
Pt. 1018
APPROVED
LORAIN CO.
MAP DEPT.
DATE 3-30-90
PAGE 60 125
BY CAROLYN FRANCIS
VOID
#18894