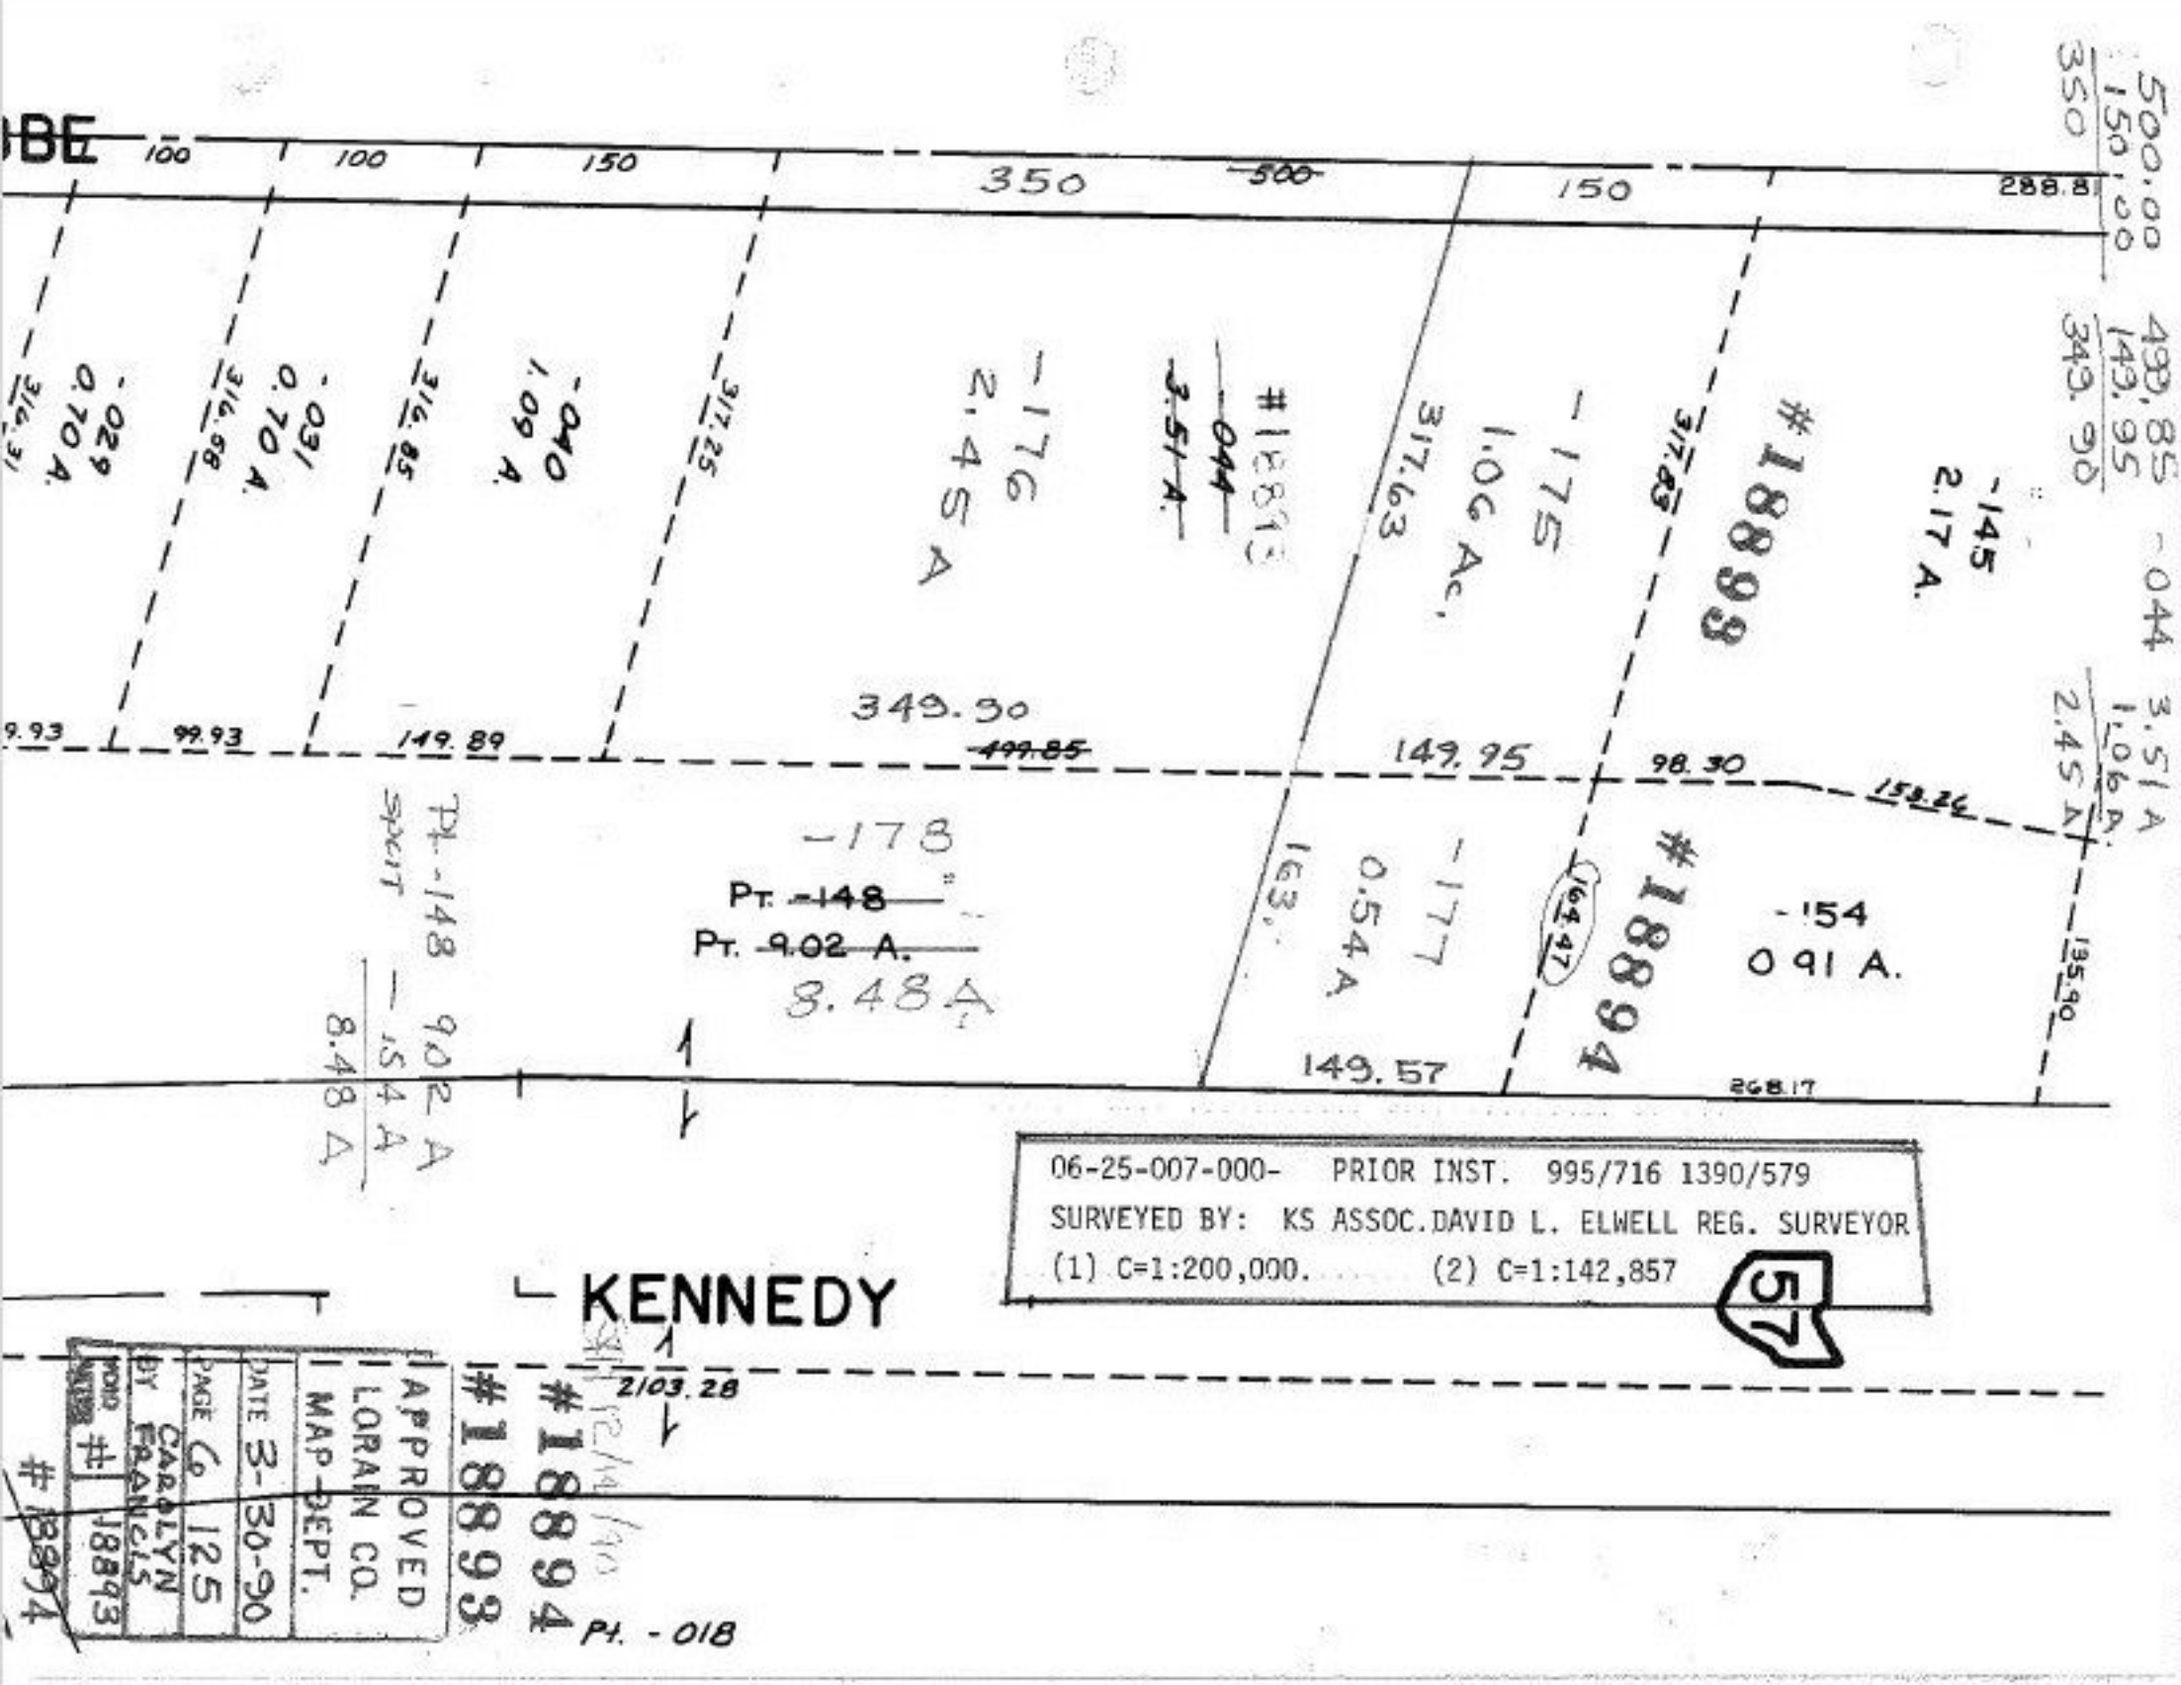
BE
100
100
150
350
~~500~~
150
288.81
500.00
150.00
350
499.85
149.95
349.90
-044
3.51 A
1.06 A.
2.45 A.
-145
2.17 A.
#188898
317.83
-175
1.06 Ac.
317.63
#188893
~~-044~~
~~3.51 A.~~
-176
2.45 A
317.25
-040
1.09 A.
316.85
-031
0.70 A.
316.58
-029
0.70 A.
316.31
349.30
~~499.85~~
149.95
98.30
158.26
99.93
99.93
149.89
-178
Pt. ~~-148~~
Pt. ~~9.02 A.~~
8.48 A.
Pt. -148 9.02 A
split -154 8.48 A
163.
-177
0.54 A
149.57
#188894
-154
0.91 A.
135.90
268.17
06-25-007-000- PRIOR INST. 995/716 1390/579
SURVEYED BY: KS ASSOC.DAVID L. ELWELL REG. SURVEYOR
(1) C=1:200,000. (2) C=1:142,857
57
KENNEDY
2103.28
#188893
#188894
Pt. - 018
APPROVED
LORAIN CO.
MAP DEPT.
DATE 3-30-90
PAGE 6 125
BY CAROLYN FRANCIS
MOD # 188893
188894