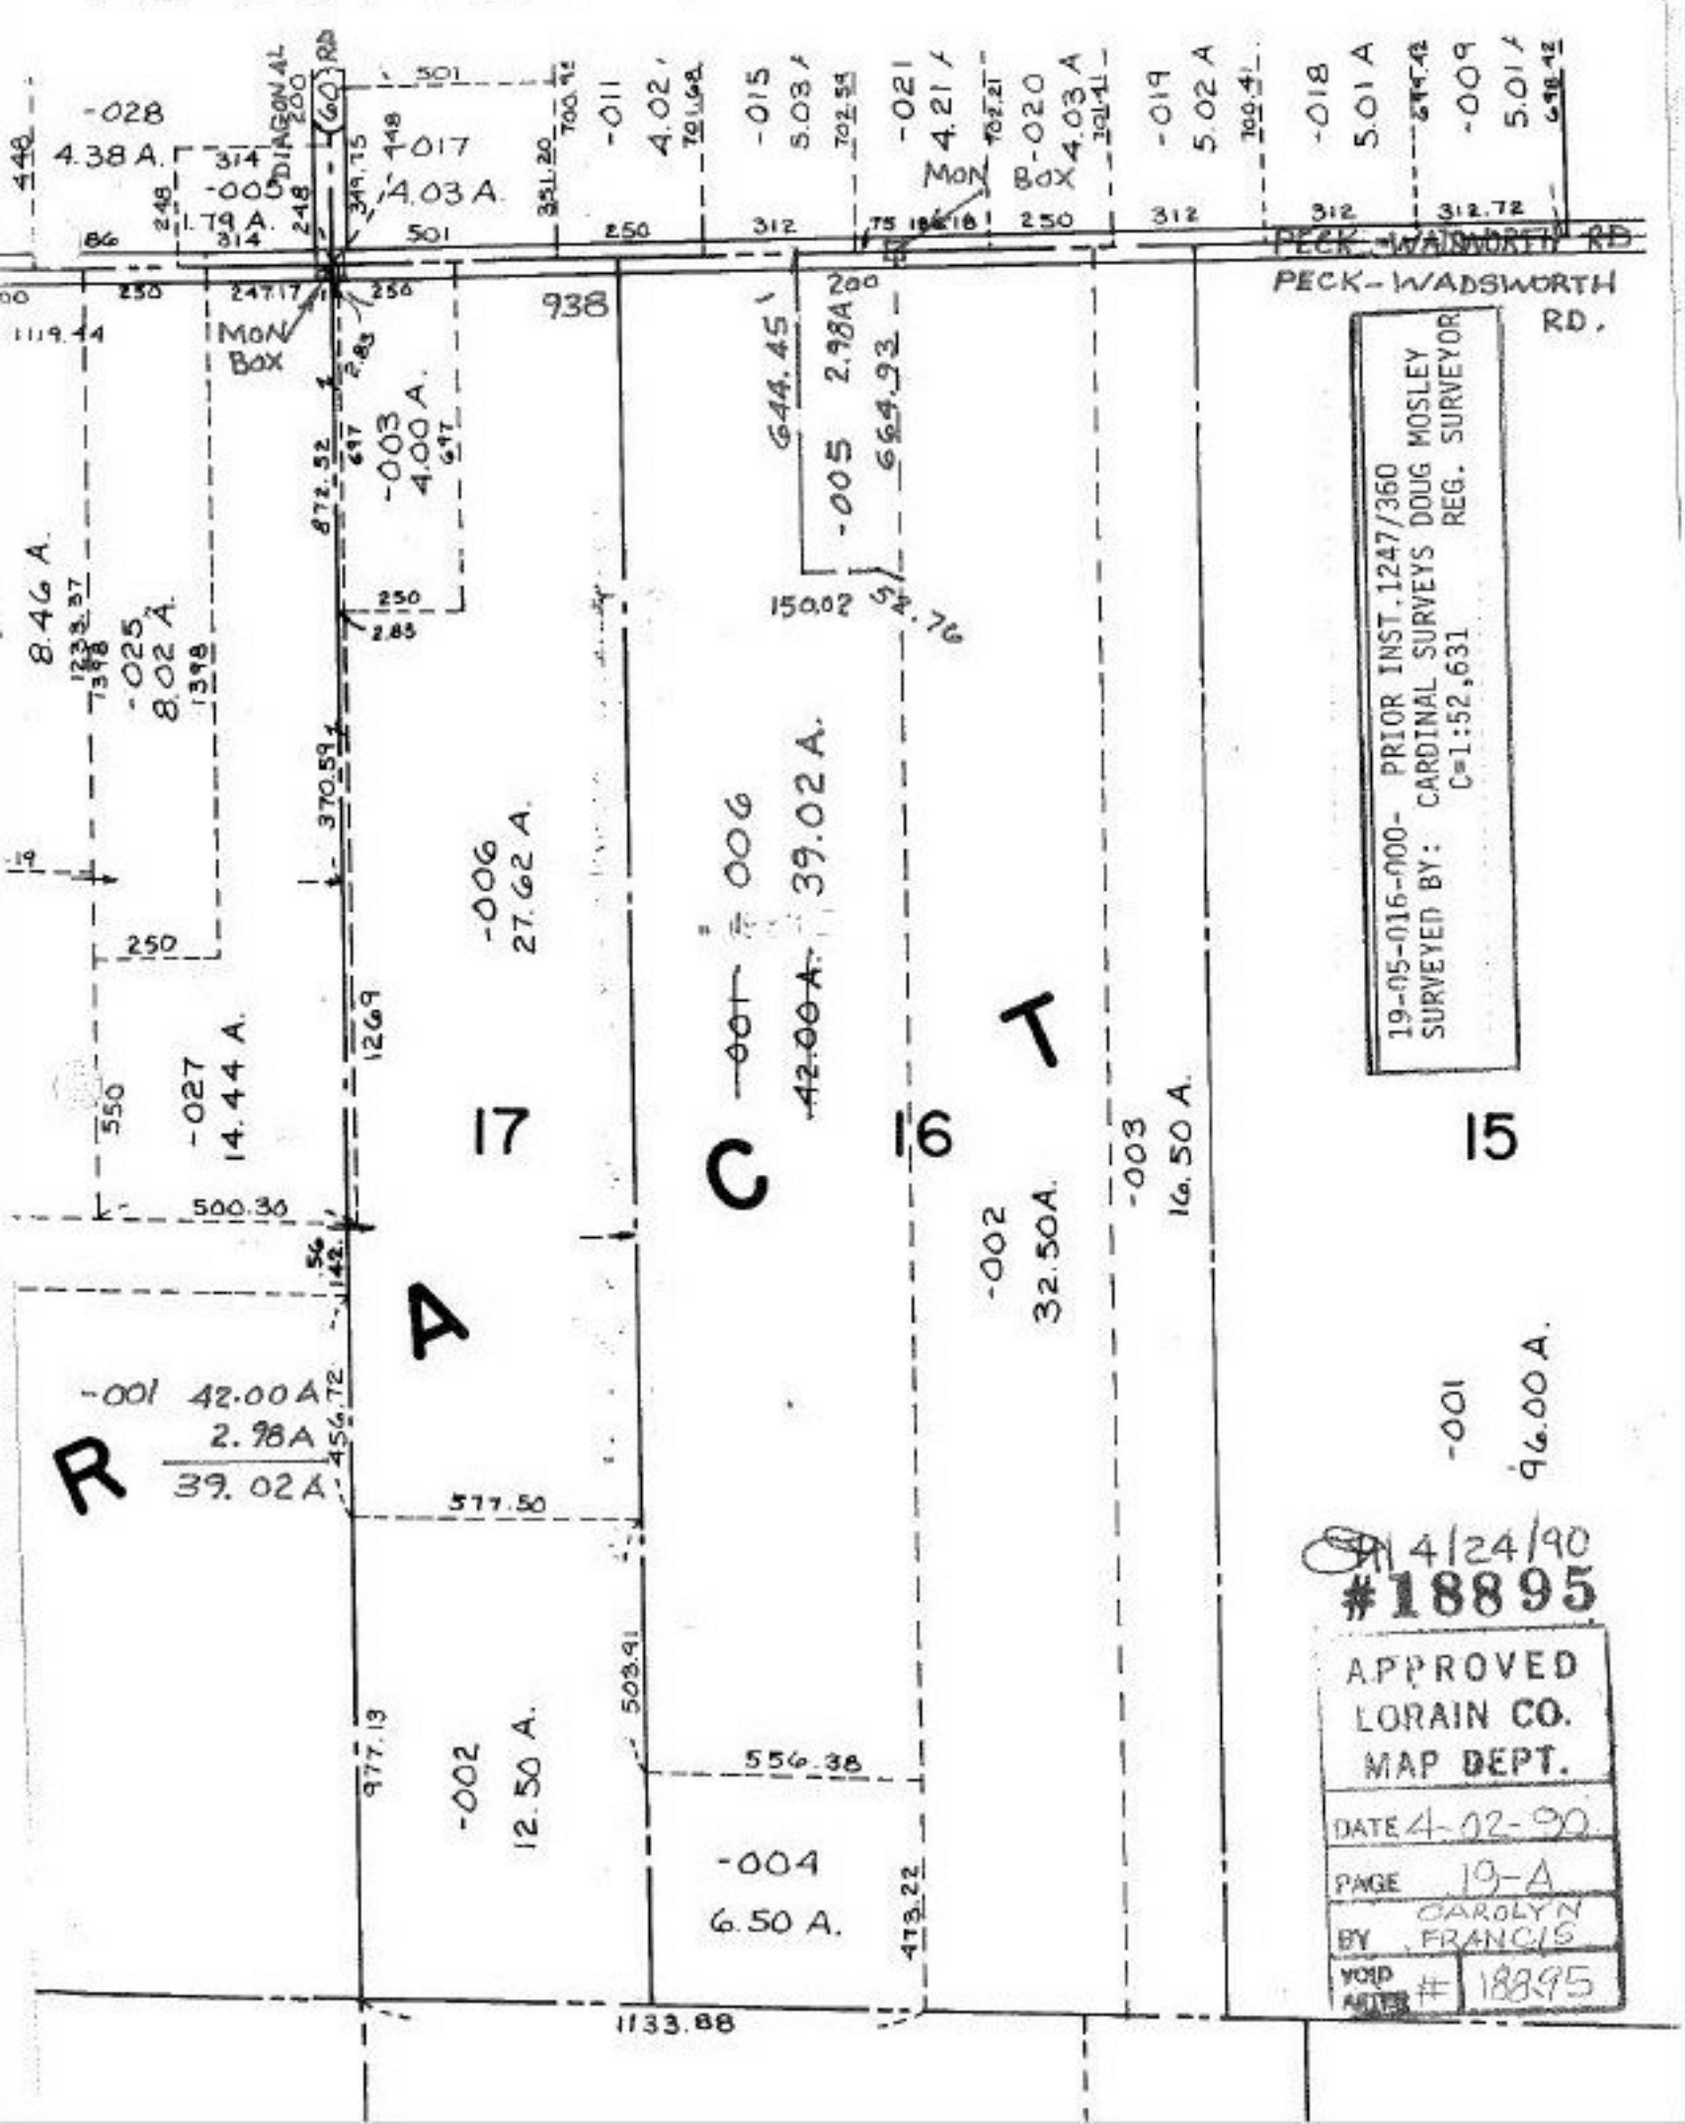

PECK-WADSWORTH RD.
DIAGONAL RD
MON BOX
-028 4.38 A.
-005 1.79 A.
-017 4.03 A.
-011 4.02
-015 5.03
-021 4.21
-020 4.03 A
-019 5.02 A
-018 5.01 A
-009 5.01
-003 4.00 A.
-005 2.98A
644.45
664.93
150.02
52.76
8.46 A.
-025 8.02 A.
-006 27.62 A.
-001 42.00 A.
39.02 A.
-027 14.44 A.
17
16
15
R A C T
-002 32.50A.
-003 16.50 A.
-001 96.00 A.
-001 42.00 A
2.98A
39.02 A
577.50
556.38
-002 12.50 A.
-004 6.50 A.
1133.88
938
19-05-016-000- PRIOR INST.1247/360
SURVEYED BY: CARDINAL SURVEYS DOUG MOSLEY
C=1:52,631 REG. SURVEYOR
4/24/90
#18895
APPROVED
LORAIN CO.
MAP DEPT.
DATE 4-02-90
PAGE 19-A
BY CAROLYN FRANCIS
VOID AFTER # 18895