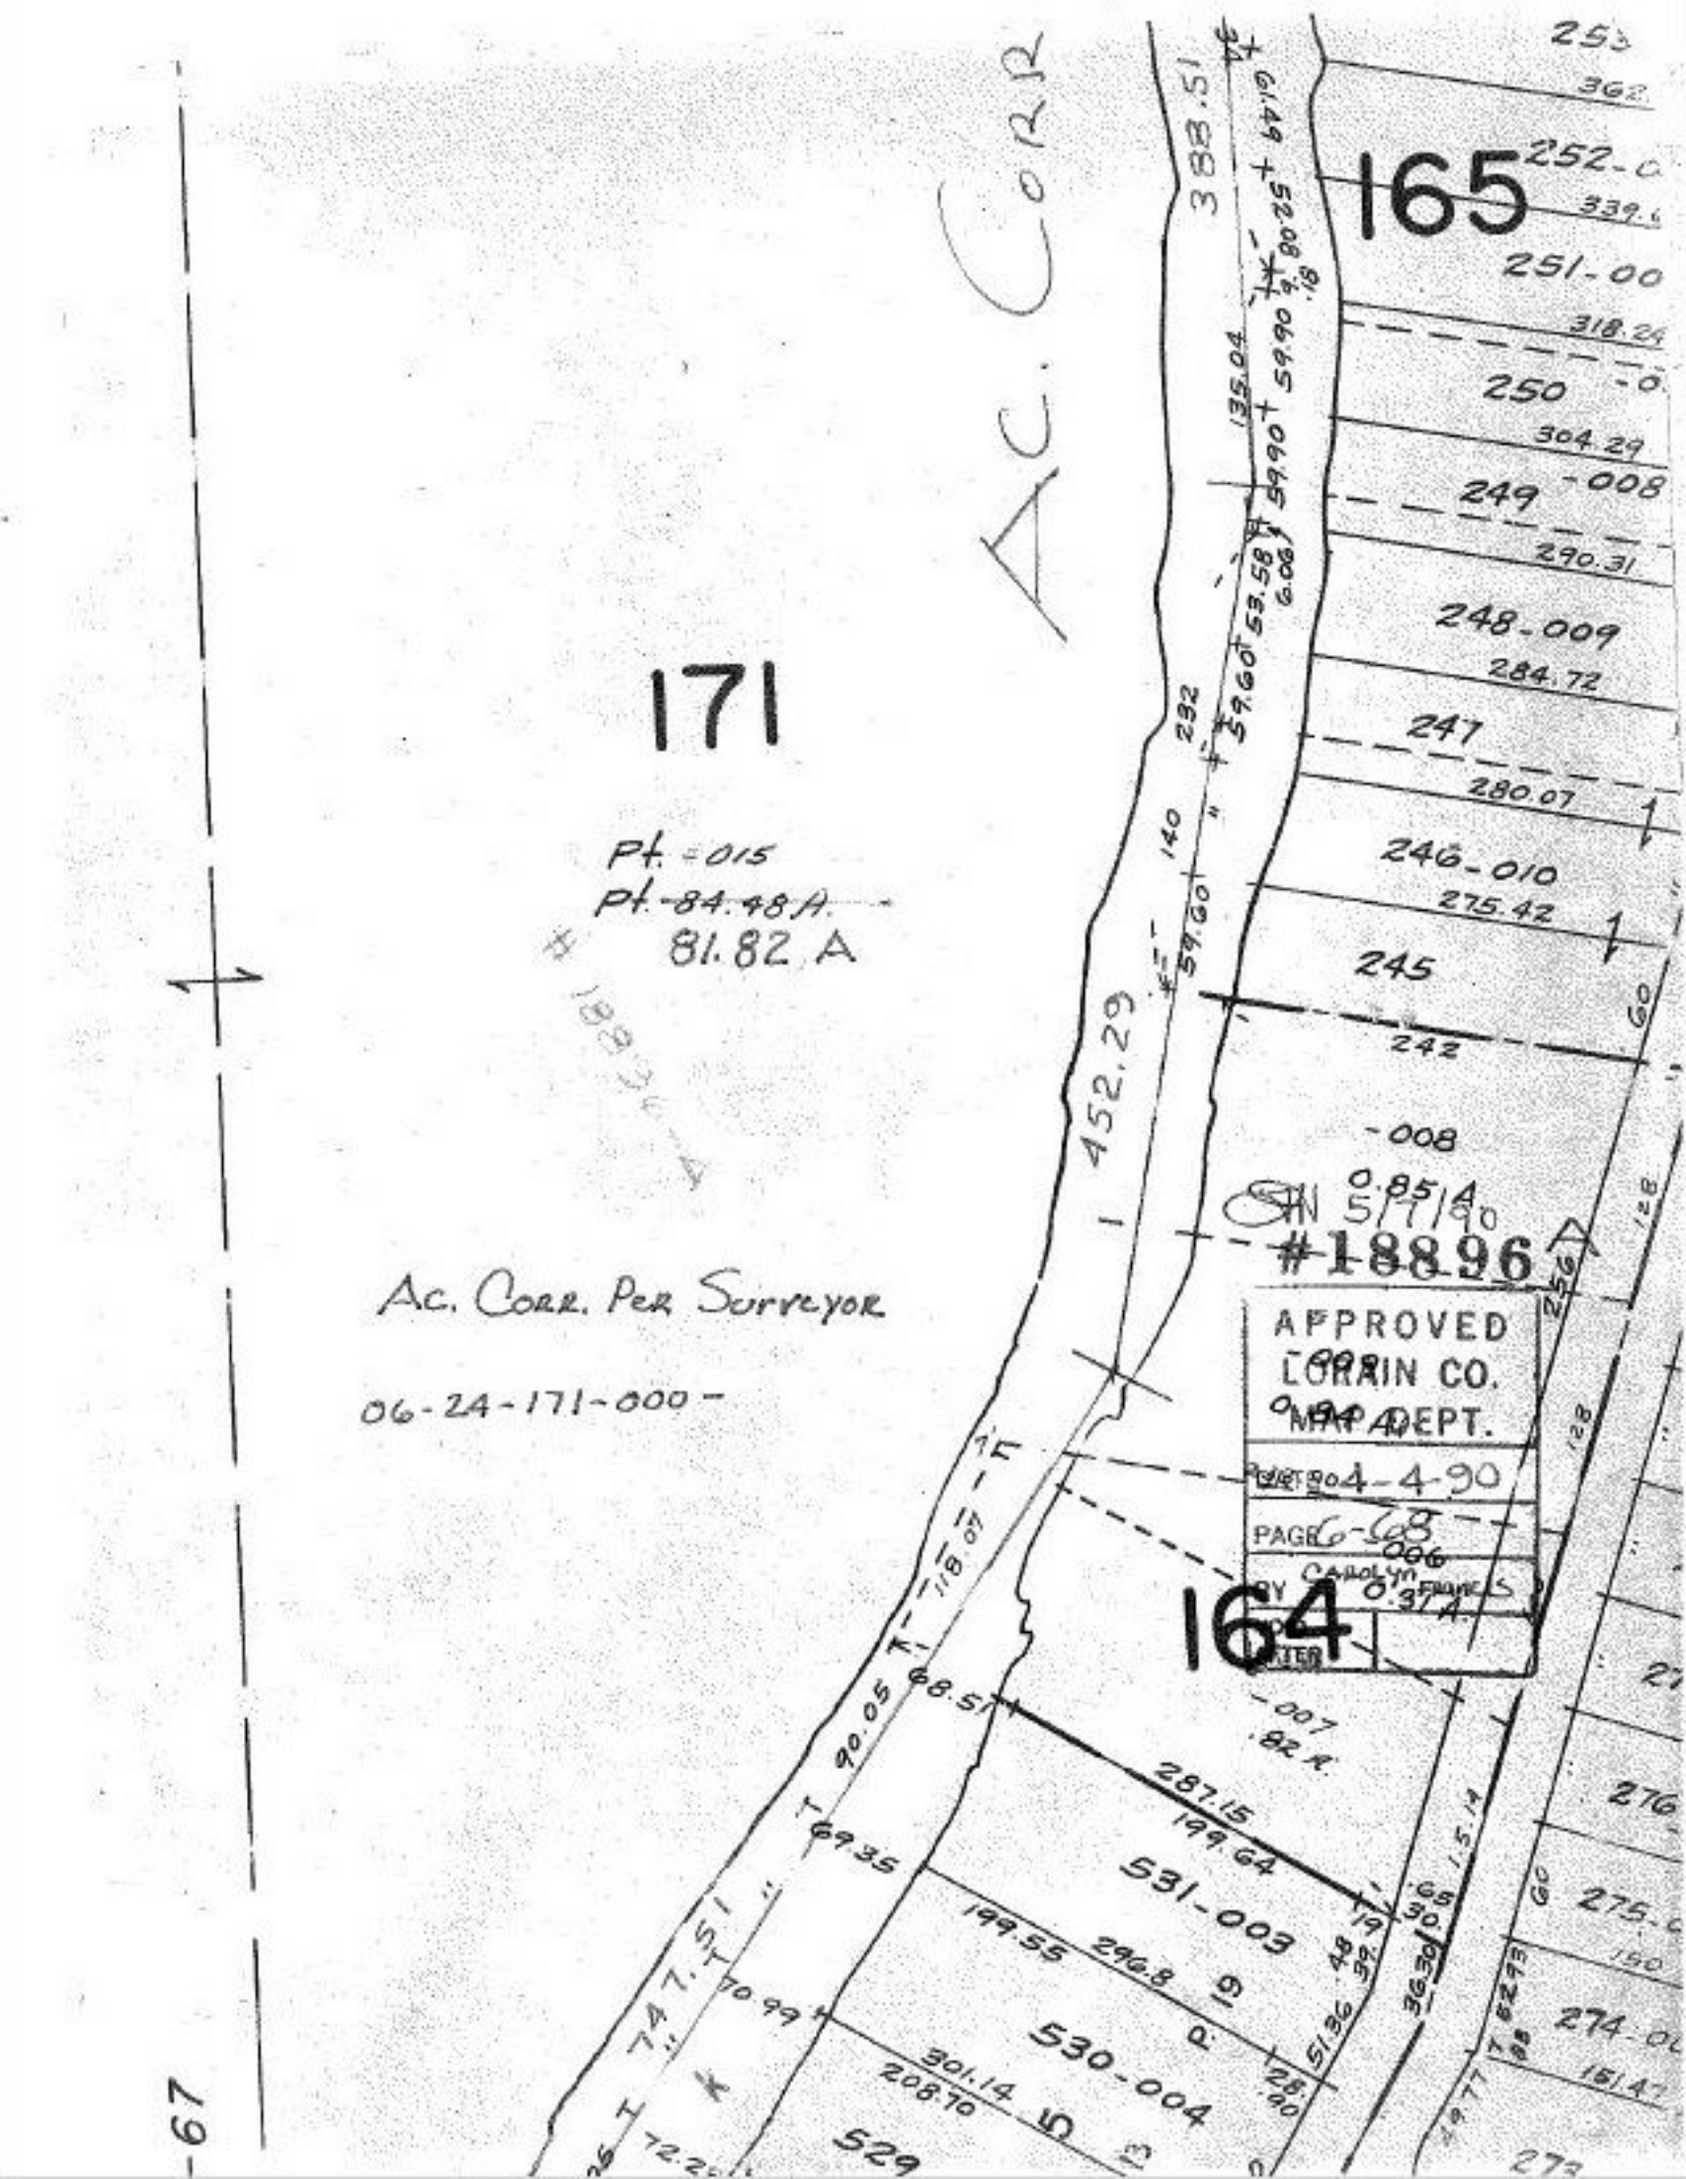
AC. CORR
171
Pt. -015
Pt. -84.48 A.
81.82 A
Ac. Corr. Per Surveyor
06-24-171-000
165
164
#18896
APPROVED
LORAIN CO.
MAP DEPT.
4-4-90
PAGE 6-68
006
0.37 A.
-008
0.85 A
-007
.82 A.
531-003
530-004
529
252-0
251-00
250 -0
249 -008
248-009
247
246-010
245
242
388.51
452.29
747.51
287.15
199.64
199.55
296.8
301.14
208.70
72.2
90.05
68.51
69.35
70.99
118.07
135.04
59.90
59.60
53.58
6.08
140
232
59.60
318.24
304.29
290.31
284.72
280.07
275.42
60
128
256
151.47
274.0
275.0
276
27
150
36.30
51.36
28.30
49.77
1.5.14
GS
30.
19
13
10
9
P.